

CHANGING ELEVATION OF Dis., Cbs OR MHS  
SEE SHEET 27

REHAB.  
Dis., Cbs OR MHS, CLASS I, II OR III  
SEE SHEETS 27-28

CHANGING ELEVATION OF SEWER MANHOLES  
SEE SHEET 28

VERTICAL GRANITE CURB  
STA. 188+21, RT

CAST-IN-PLACE CONCRETE CURB, TYPE B  
STA. 185+24, RT  
STA. 185+26, LT  
STA. 187+75, LT

REMOVAL OF EXISTING CURB  
STA. 185+24, RT  
STA. 185+26, LT  
STA. 187+75, LT  
STA. 188+21, RT

PORTLAND CEMENT  
CONCRETE SIDEWALK, 5 INCH  
STA. 185+24, RT  
STA. 185+26, LT  
STA. 185+66, LT  
STA. 187+75, LT  
STA. 188+09, LT  
STA. 188+21, RT

DETECTABLE WARNING SURFACE  
STA. 185+24, RT  
STA. 185+26, LT  
STA. 185+66, LT  
STA. 187+75, LT  
STA. 188+09, LT  
STA. 188+21, RT

ADJUST ELEVATION OF VALVE BOX  
SEE SHEETS 28-29

DURABLE & TEMPORARY 4 INCH WHITE LINE  
(ALL LINES WILL INCLUDE EDGE LINE BREAKS  
AND RADI1 FOR SIDE ROADS)  
STA. 185+00 TO 190+00, SOLID LT & RT  
(PARKING SPACES & DIAGONALS)  
SEE SHEETS 55 TO 56 (TYP.)

DURABLE & TEMPORARY 4 INCH YELLOW LINE  
(ALL LINES WILL INCLUDE G BREAKS FOR  
SIDE ROADS & CROSSWALKS)  
STA. 185+00 TO 190+00, SOLID LT & RT

DURABLE & TEMPORARY 24 INCH STOP BAR  
STA. 185+57, LT (CHERRY ST. TH-386)

DURABLE & TEMPORARY LETTER OR SYMBOL  
STA. 185+57, LT "STOP" (CHERRY ST. TH-386)  
STA. 189+98, RT ARROW  
STA. 190+00, RT ARROW


DURABLE CROSSWALK MARKING, TYPE A TAPE  
STA. 185+24, RT TO 185+26, LT  
STA. 185+57, LT (CHERRY ST. TH-386)  
STA. 187+97, LT (PEARL ST. TH-372)  
STA. 187+97, RT (PEARL ST. TH-372)  
STA. 188+10, LT TO 188+20, RT  
SEE SHEET 55 (TYP.)

TEMPORARY CROSSWALK MARKING  
STA. 185+24, RT TO 185+26, LT  
STA. 185+57, LT (CHERRY ST. TH-386)  
STA. 187+97, LT (PEARL ST. TH-372)  
STA. 187+97, RT (PEARL ST. TH-372)  
STA. 188+10, LT TO 188+20, RT  
SEE SHEET 55 (TYP.)

REMOVING SIGNS  
AS SHOWN - 37

ERECTING SALVAGED SIGNS  
AS SHOWN - 3

SPECIAL PROVISION (PARKING METER POST)  
STA. 185+95, LT  
STA. 187+09, LT  
STA. 187+24, RT  
STA. 187+53, LT  
STA. 188+53, LT  
STA. 189+00, LT  
STA. 189+48, LT  
STA. 189+95, LT

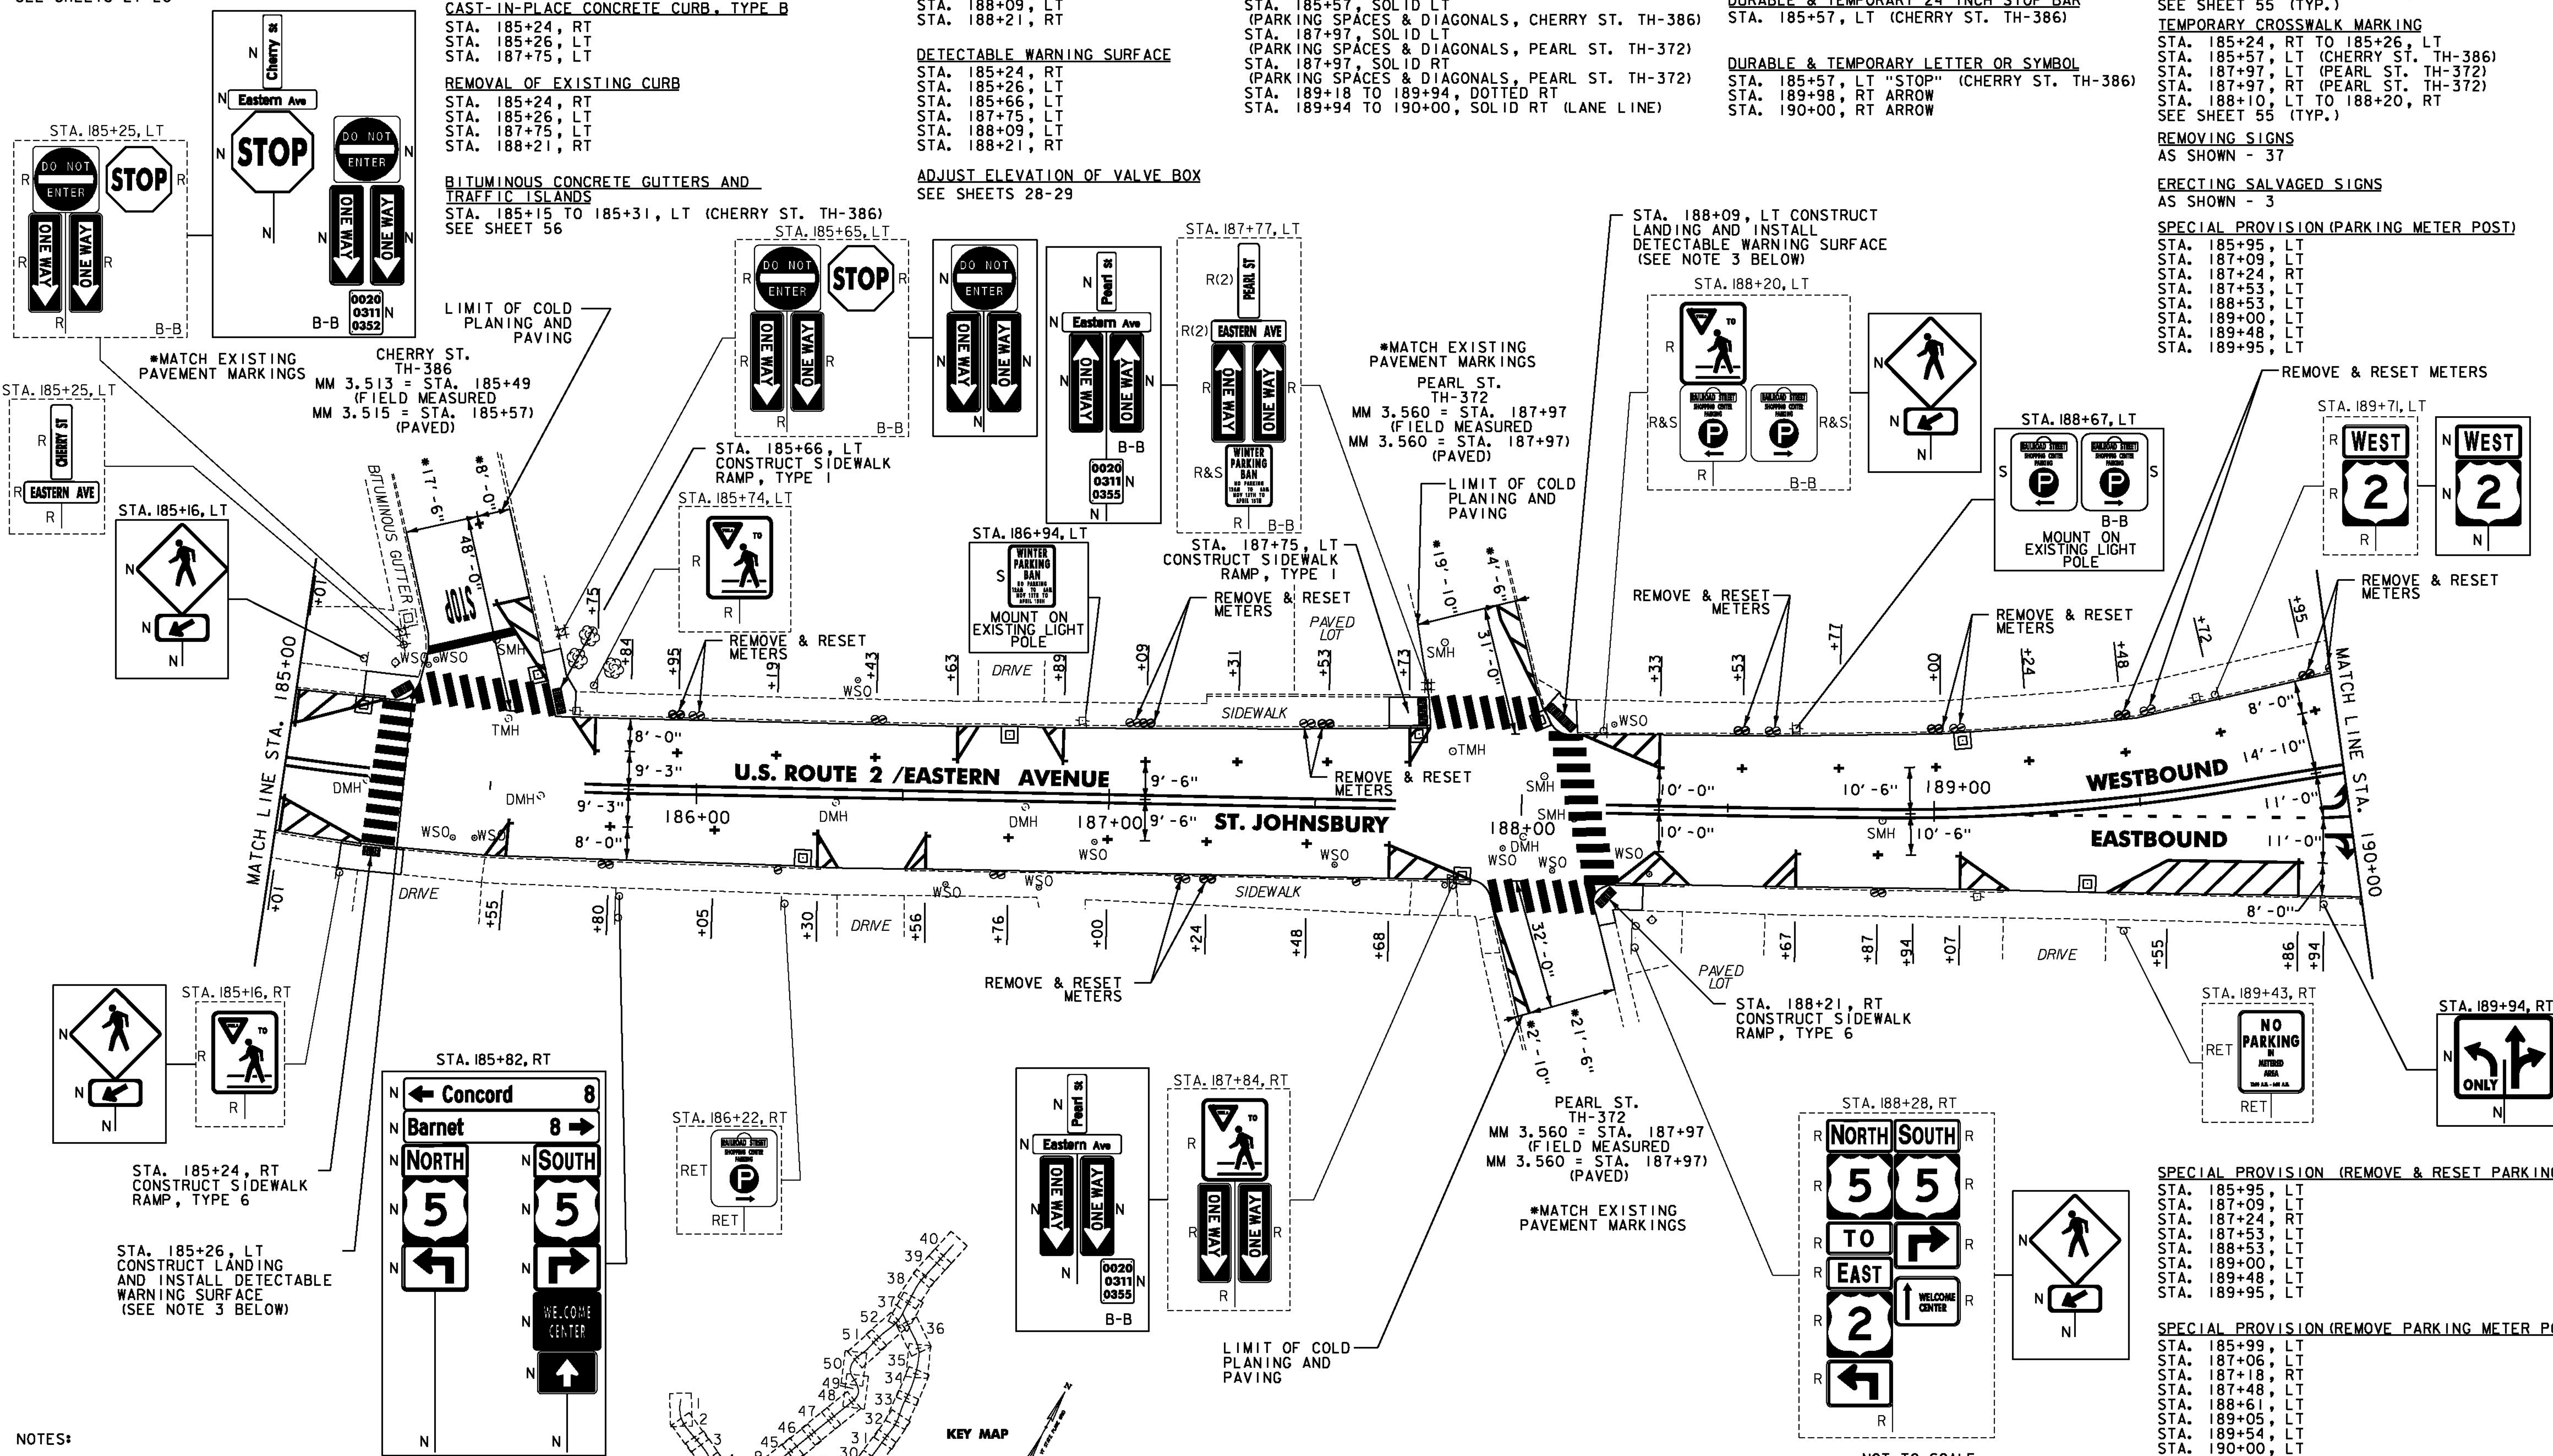

- NOTES:
- FOR LEGENDS, SEE SHEET 3.
  - ALL EXISTING SIGNS NOT SHOWN ON THE PLANS SHALL BE RETAINED.
  - THE SIDEWALK "LANDINGS" NOTED CONSIST OF THE REMOVAL AND REPLACEMENT OF A SINGLE SLAB OF CONCRETE SIDEWALK IN ORDER TO INSTALL A NEW DETECTABLE WARNING SURFACE. SEE SHEETS 12-25.

<b>PROJECT LAYOUT SHEET #11</b>	PROJECT NAME: ST JOHNSBURY - LYNDON
	PROJECT NUMBER: STP 2936(1)
	FILE NAME: pllc308.dgn
DESIGNED BY: D. DRAPER	PLOT DATE: 5/5/2014
	DRAWN BY: D. DRAPER
	CHECKED BY: J. LITTLE
	SHEET 72 OF 250

