

REHAB.  
Dis. Cbs OR MHS, CLASS I, II OR III  
SEE SHEETS 27-28

CAST-IN-PLACE CONCRETE CURB, TYPE B

STA. 230+00, LT  
STA. 231+60, RT

REMOVAL OF EXISTING CURB

STA. 230+00, LT  
STA. 231+60, RT

PORTLAND CEMENT  
CONCRETE SIDEWALK, 5 INCH  
STA. 230+00, LT  
STA. 231+60, RT

DETECTABLE WARNING SURFACE  
STA. 230+00, LT  
STA. 231+60, RT

ADJUST ELEVATION OF VALVE BOX  
SEE SHEETS 28-29

DURABLE & TEMPORARY 4 INCH WHITE LINE  
(ALL LINES WILL INCLUDE EDGE LINE BREAKS  
AND RADII FOR SIDE ROADS)

DURABLE & TEMPORARY 4 INCH YELLOW LINE  
(ALL LINES WILL INCLUDE  $\phi$  BREAKS FOR  
SIDE ROADS & CROSSWALKS)

STA. 230+00 TO 235+00, SOLID LT & RT  
STA. 230+08, DOUBLE SOLID LT (STATE ST. TH-485)  
STA. 231+46, DOUBLE SOLID RT (LINCOLN ST. TH-498)

DURABLE & TEMPORARY 24 INCH STOP BAR  
STA. 230+08, LT (STATE ST. TH-485)  
STA. 231+46, RT (LINCOLN ST. TH-498)

DURABLE & TEMPORARY LETTER OR SYMBOL  
STA. 230+08, LT "STOP" (STATE ST. TH-485)  
STA. 231+46, RT "STOP" (LINCOLN ST. TH-498)


DURABLE CROSSWALK MARKING, TYPE A TAPE  
STA. 230+08, LT (STATE ST. TH-485)  
STA. 231+60, LT-RT  
SEE SHEET 55 (TYP.)

DURABLE RAILROAD CROSSING SYMBOL, TYPE D TAPE  
STA. 233+50, RT

TEMPORARY CROSSWALK MARKING, PAINT  
STA. 230+08, LT (STATE ST. TH-485)  
STA. 231+60, LT-RT  
SEE SHEET 55 (TYP.)

TEMPORARY RAILROAD CROSSING SYMBOL, PAINT  
STA. 233+50, RT

REMOVING SIGNS  
AS SHOWN - 19

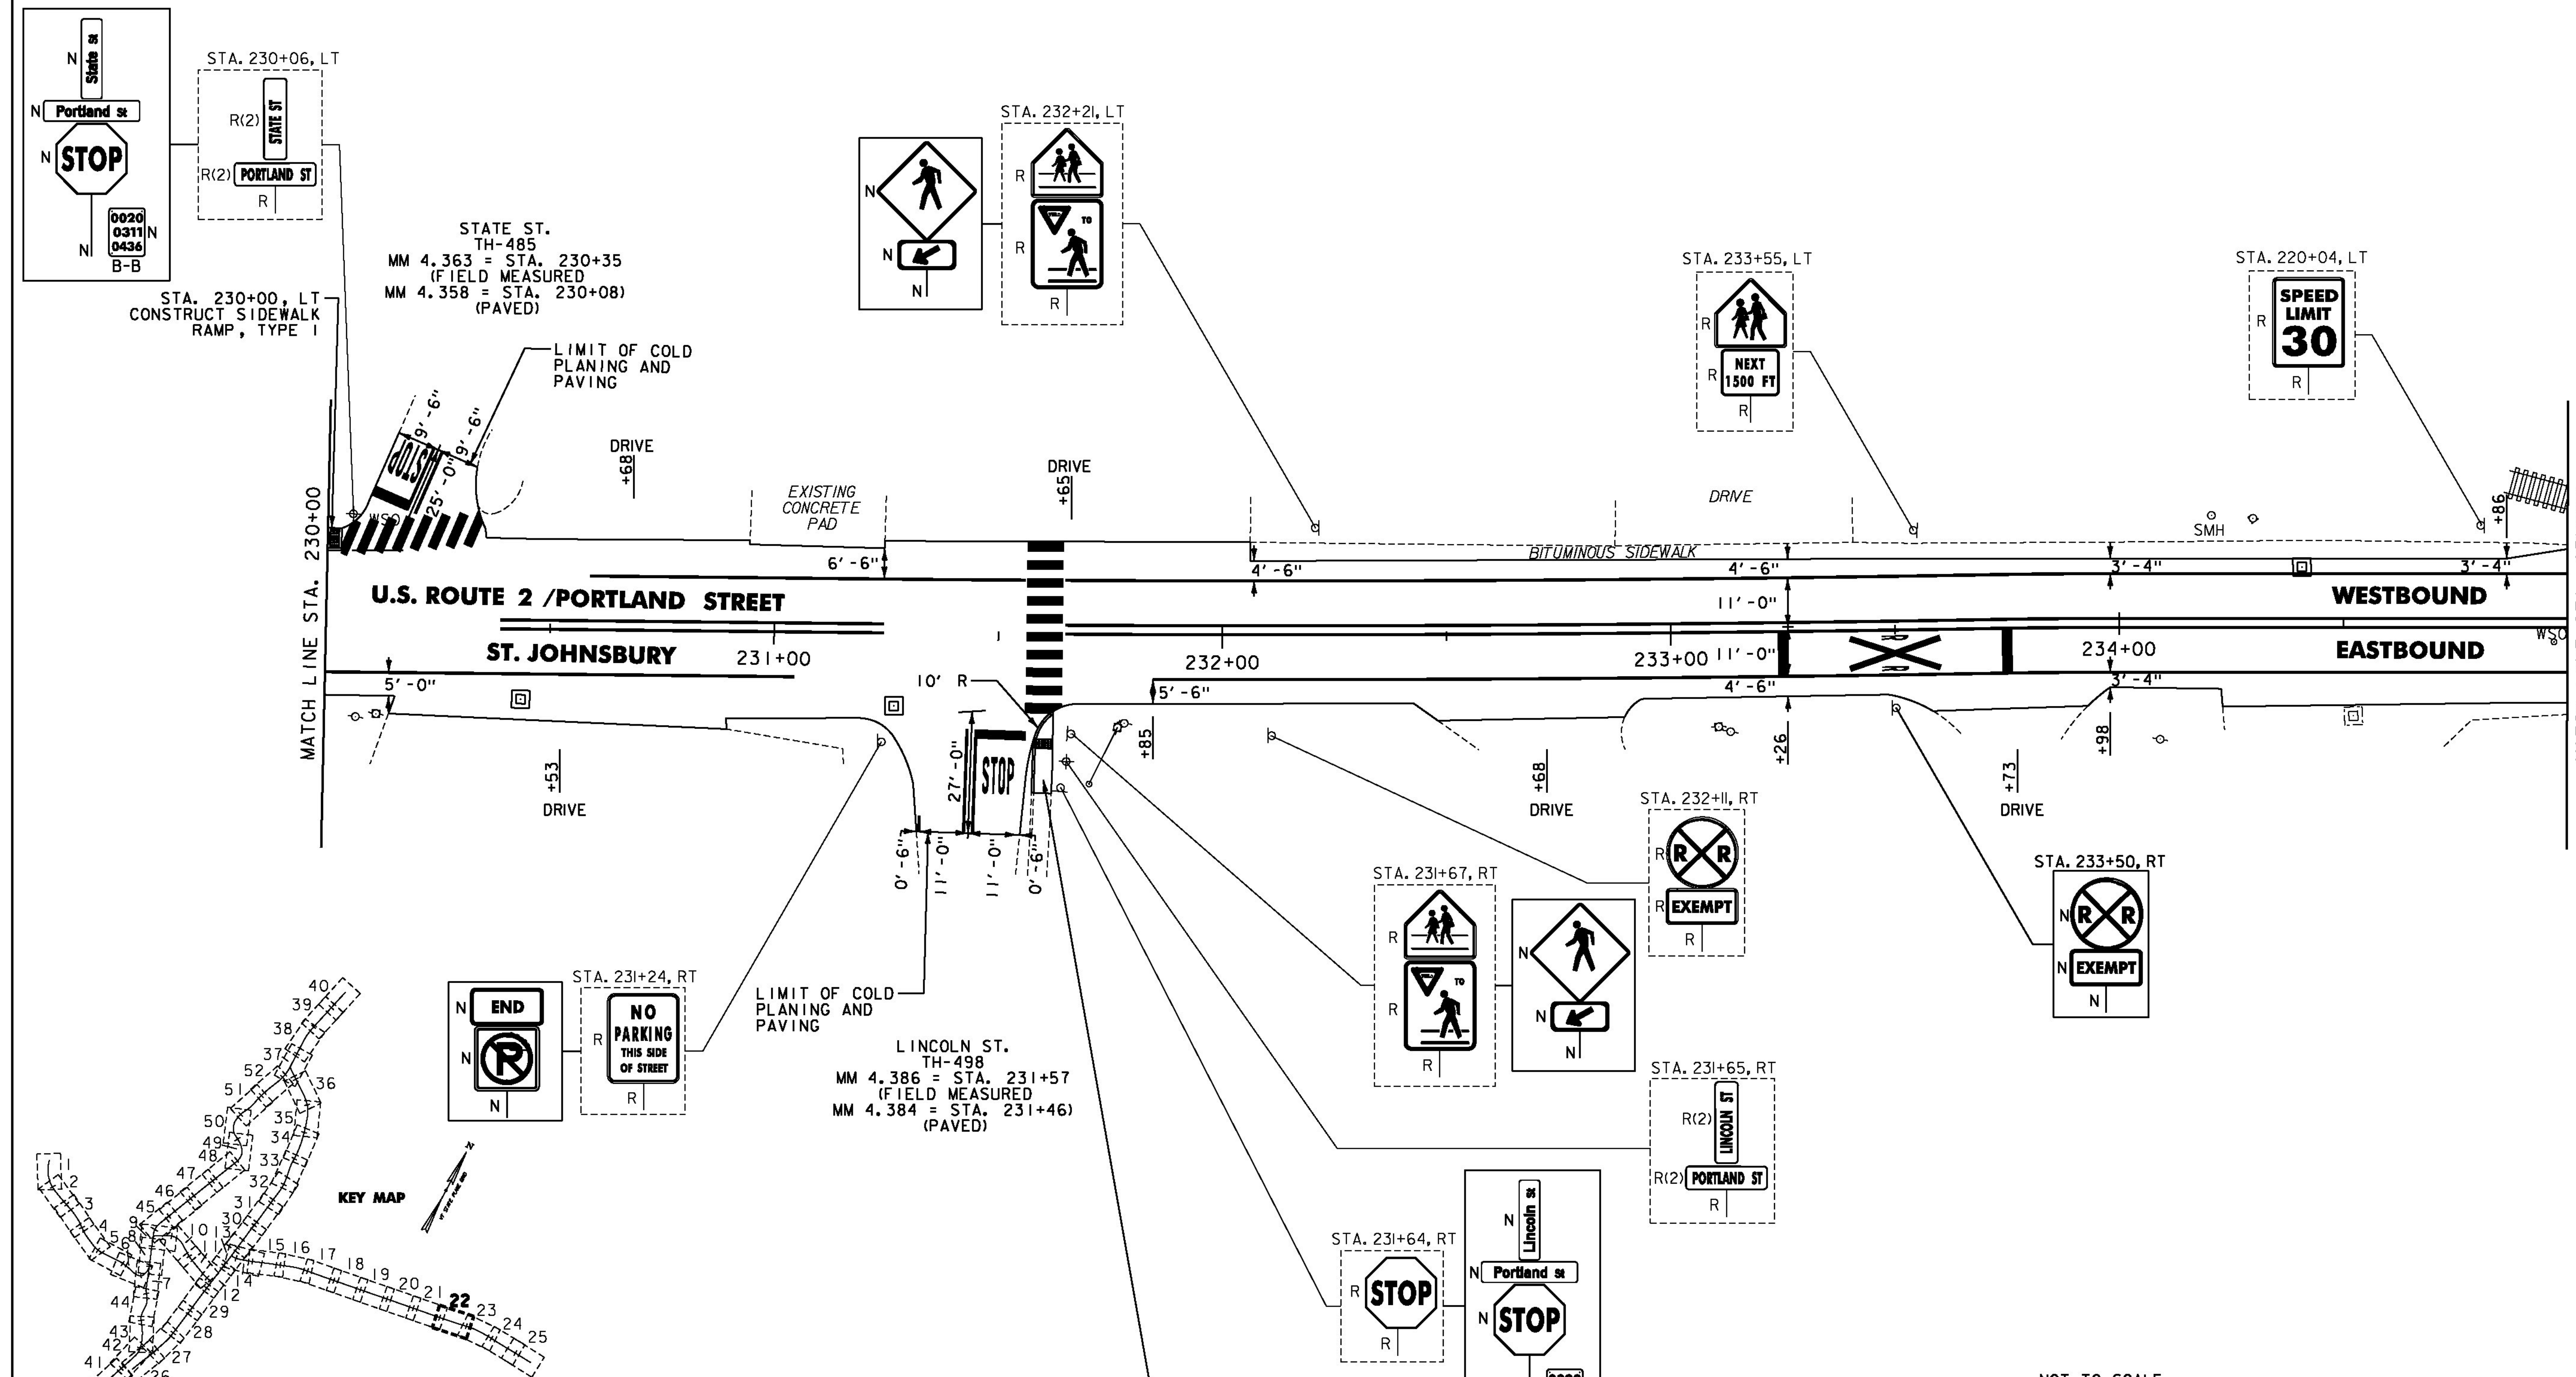

- NOTES:
- FOR LEGENDS, SEE SHEET 3.
  - ALL EXISTING SIGNS NOT SHOWN ON THE PLANS SHALL BE RETAINED.

STA. 231+60, RT  
CONSTRUCT NEW CAST-IN-PLACE CONCRETE CURB, TYPE B AND PORTLAND CEMENT CONCRETE SIDEWALK, 5 INCH WITH A TYPE I RAMP.  
FOR DETAILS, SEE SHEET 57



NOT TO SCALE	
<b>PROJECT LAYOUT SHEET #22</b>	
PROJECT NAME: ST JOHNSBURY - LYNDON	PLOT DATE: 5/5/2014
PROJECT NUMBER: STP 2936(I)	DRAWN BY: D. DRAPER
FILE NAME: pllc308.dgn	CHECKED BY: J. LITTLE
PROJECT LEADER: G. EDWARDS	SHEET 84 OF 250
DESIGNED BY: D. DRAPER	