

CHANGING ELEVATION OF DIS, CBS OR MHS
SEE SHEET 27

REHAB.
DIS, CBS OR MHS, CLASS I, II OR III
SEE SHEETS 27-28

CHANGING ELEVATION OF SEWER MANHOLES
SEE SHEET 28

CAST-IN-PLACE CONCRETE CURB, TYPE B

STA. 99+46, LT
STA. 99+83, LT
STA. 101+77, RT
STA. 101+77, LT

REMOVING AND RESETTING CURB

STA. 99+46, LT
STA. 99+83, LT
STA. 101+77, RT
STA. 101+77, LT

PORTLAND CEMENT
CONCRETE SIDEWALK, 5 INCH

STA. 99+46, LT
STA. 99+47, RT
STA. 99+83, LT
STA. 101+77, RT
STA. 101+77, LT

DETECTABLE WARNING SURFACE

STA. 99+46, LT
STA. 99+47, RT
STA. 99+83, LT
STA. 101+77, RT
STA. 101+77, LT

ADJUST ELEVATION OF VALVE BOX
SEE SHEETS 28-29

DURABLE & TEMPORARY 4 INCH WHITE LINE

(ALL LINES WILL INCLUDE EDGE LINE BREAKS
AND RADIUS FOR SIDE ROADS)
STA. 99+00 TO 99+23, SOLID LT
STA. 99+00 TO 99+41, DOTTED LT
STA. 99+00 TO 101+08, SOLID RT
STA. 99+83 TO 100+25, DOTTED LT
STA. 99+83 TO 101+31, LT (PARKING SPACES & DIAGONALS)
SEE SHEETS 55 TO 56 (TYP.)
STA. 101+08 TO 103+92, RT (PARKING SPACES & DIAGONALS)
STA. 101+44 TO 104+00, SOLID LT

DURABLE & TEMPORARY 4 INCH YELLOW LINE

(ALL LINES WILL INCLUDE $\frac{1}{2}$ BREAKS FOR SIDE
ROADS & CROSSWALKS)
STA. 99+00 TO 99+41, DOUBLE SOLID RT (2)
STA. 99+56, DOUBLE SOLID LT (MAPLE ST.)
STA. 99+83 TO 100+90, DOUBLE SOLID LT
STA. 99+84 TO 100+90, DOUBLE SOLID RT
STA. 100+90 TO 104+00, SOLID LT & RT

DURABLE & TEMPORARY 8 INCH YELLOW LINE
STA. 99+00 TO 99+41, RT (DIAGONALS)
STA. 101+20, RT HANDICAP SYMBOL
STA. 101+41, RT HANDICAP SYMBOL

DURABLE & TEMPORARY 24 INCH STOP BAR
STA. 99+56, LT (MAPLE ST.)

DURABLE & TEMPORARY LETTER OR SYMBOL
STA. 99+56, LT "STOP" (MAPLE ST.)
STA. 101+20, RT HANDICAP SYMBOL
STA. 101+41, RT HANDICAP SYMBOL

DURABLE CROSSWALK MARKING, TYPE D TAPE

STA. 99+47, LT - RT
STA. 99+56, LT (MAPLE ST.)
STA. 101+76, RT TO 101+78, LT
SEE SHEET 55 (TYP.)

TEMPORARY CROSSWALK MARKING, PAINT

STA. 99+47, LT - RT
STA. 99+56, LT (MAPLE ST.)
STA. 101+76, RT TO 101+78, LT
SEE SHEET 55 (TYP.)

REMOVING SIGNS
AS SHOWN - 10


SPECIAL PROVISION (PARKING METER POST)
STA. 101+08, RT
STA. 103+26, RT

SPECIAL PROVISION (REMOVE
& RESET PARKING METER)

STA. 101+08, RT
STA. 103+26, RT

SPECIAL PROVISION (REMOVE PARKING METER
POST)

STA. 101+34, RT
STA. 101+50, LT

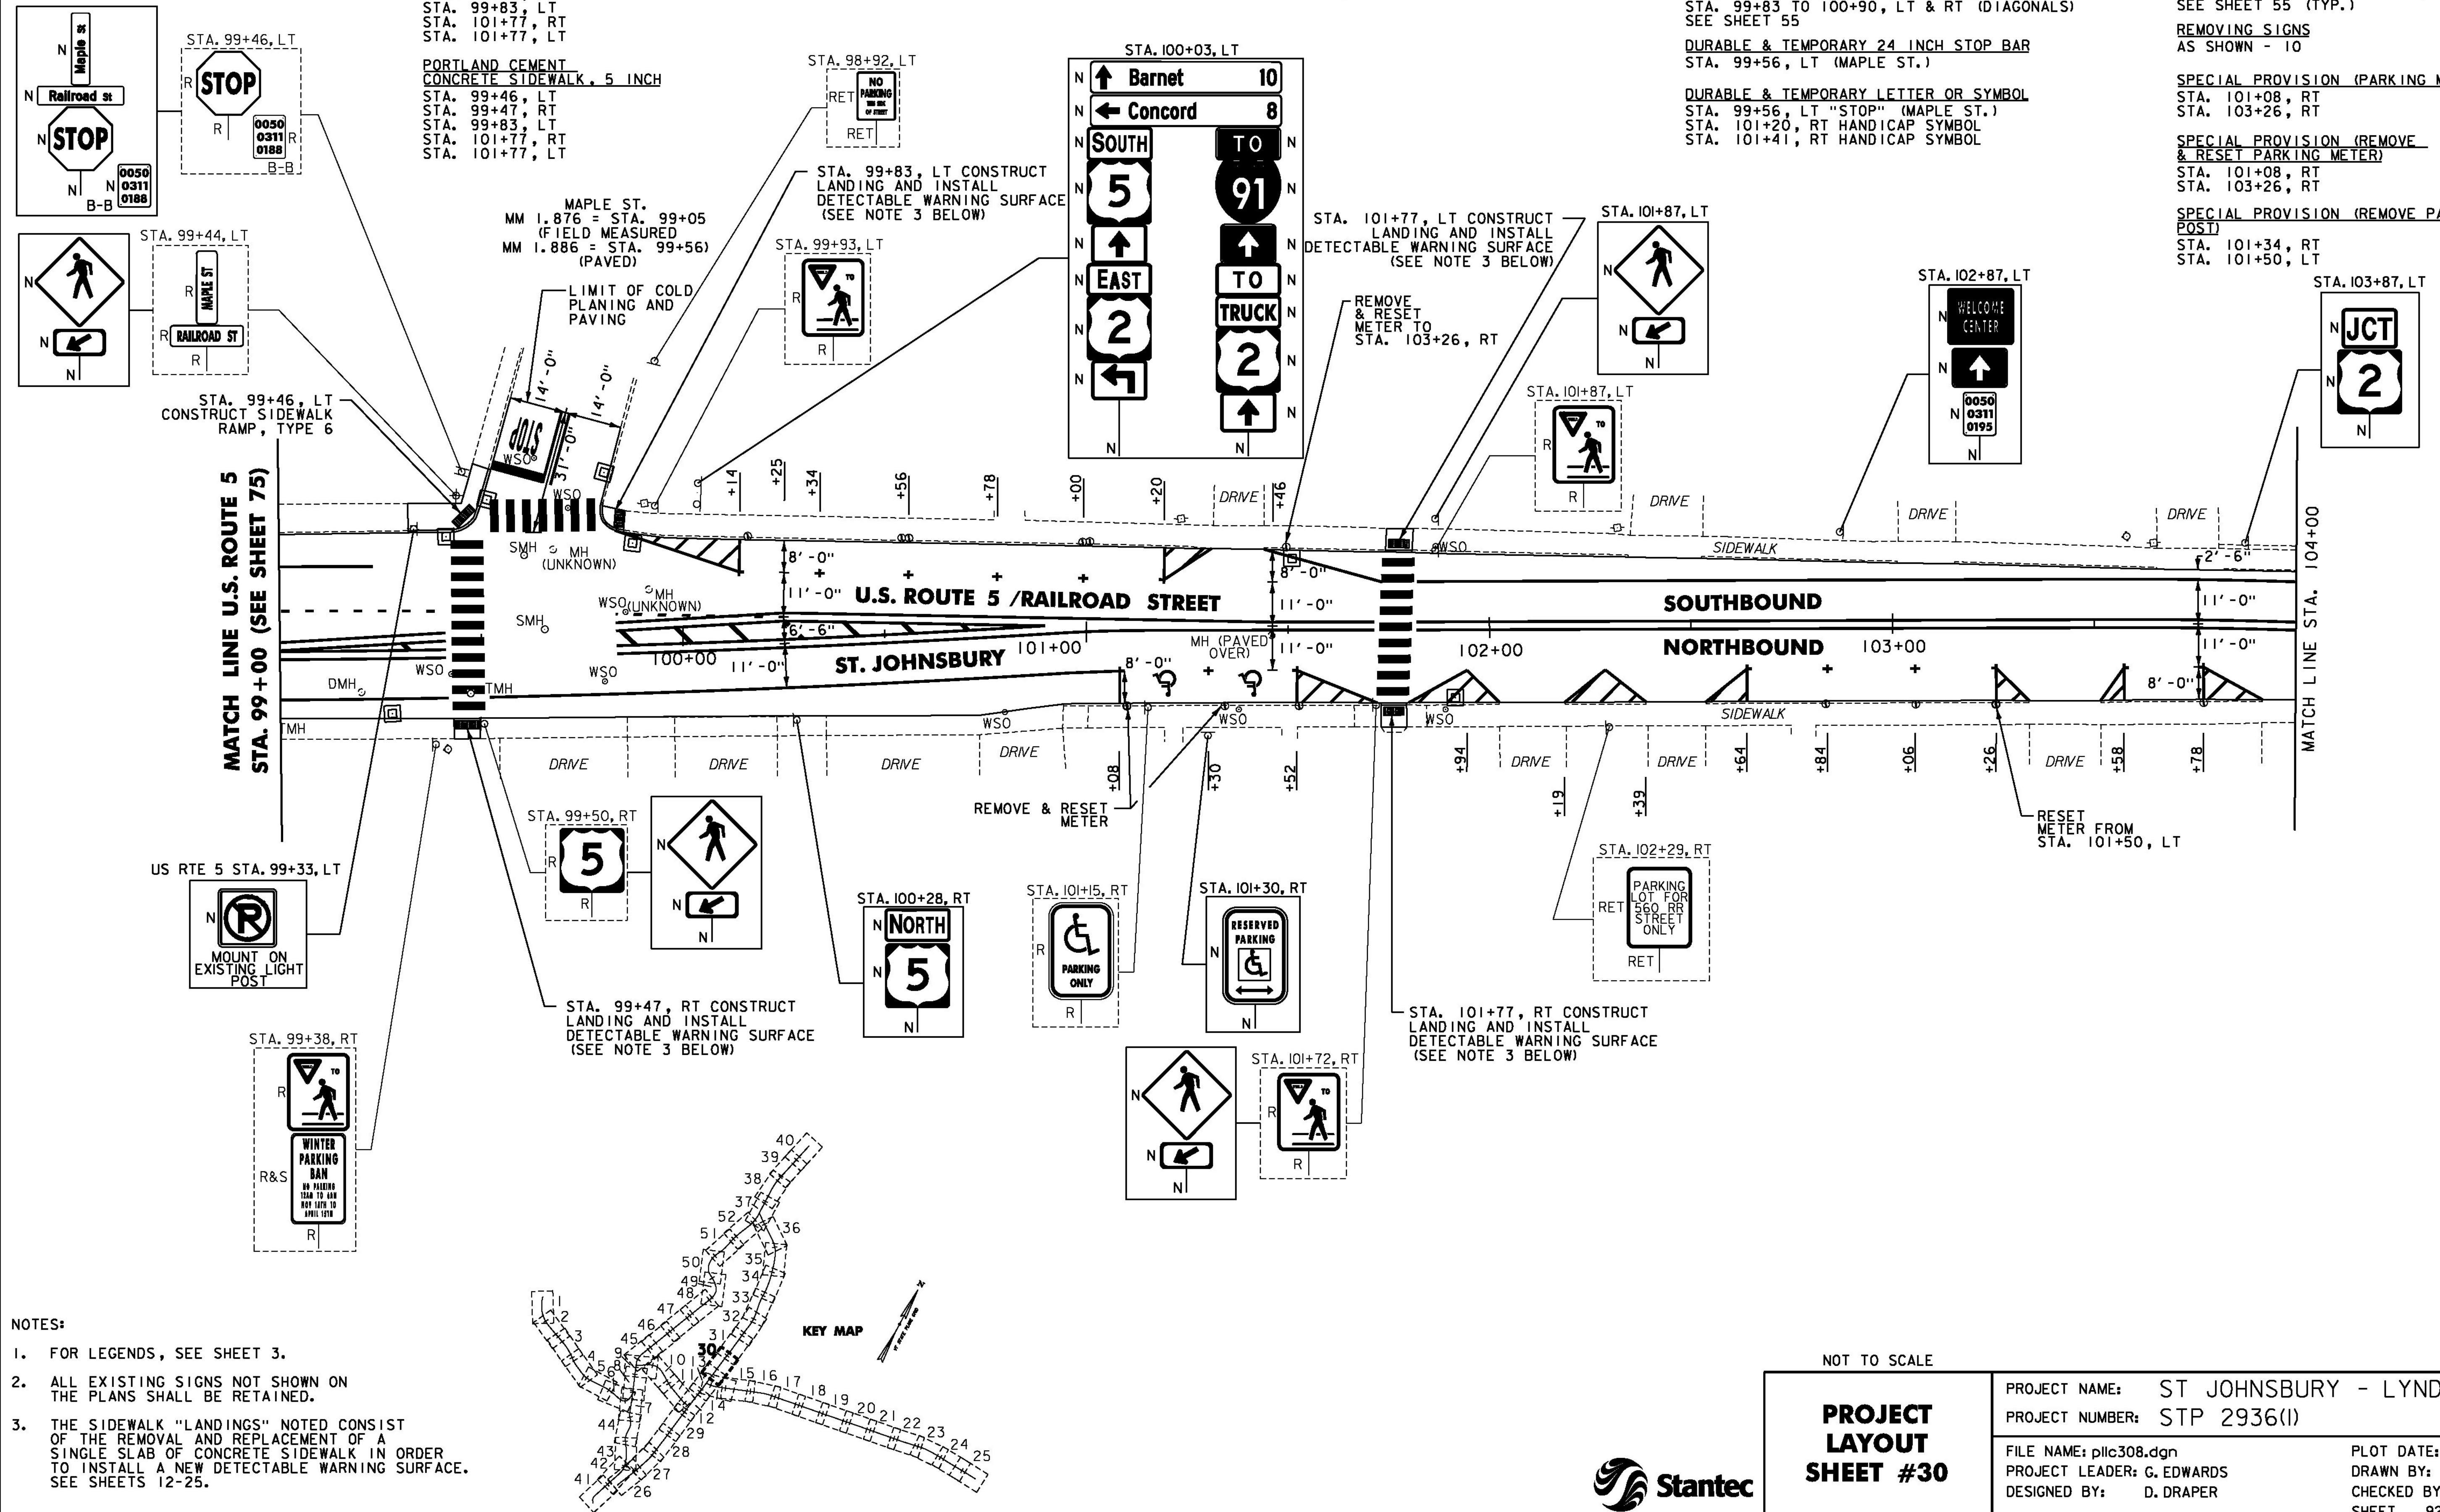

- NOTES:
- FOR LEGENDS, SEE SHEET 3.
 - ALL EXISTING SIGNS NOT SHOWN ON THE PLANS SHALL BE RETAINED.
 - THE SIDEWALK "LANDINGS" NOTED CONSIST OF THE REMOVAL AND REPLACEMENT OF A SINGLE SLAB OF CONCRETE SIDEWALK IN ORDER TO INSTALL A NEW DETECTABLE WARNING SURFACE. SEE SHEETS 12-25.

NOT TO SCALE

PROJECT LAYOUT SHEET #30	PROJECT NAME: ST JOHNSBURY - LYNDON
	PROJECT NUMBER: STP 2936(1)
FILE NAME: pllc308.dgn	PLOT DATE: 5/5/2014
PROJECT LEADER: G. EDWARDS	DRAWN BY: D. DRAPER
DESIGNED BY: D. DRAPER	CHECKED BY: J. LITTLE
	SHEET 92 OF 250

