

THINNING AND TRIMMING FOR SIGNS

STA. 106+19, RT
SEE SHEET 241 (TYP.)

REHAB.
DIS, CBS OR MHS, CLASS I, II OR III
SEE SHEETS 27-28

CHANGING ELEVATION OF SEWER MANHOLES
SEE SHEET 28

CAST-IN-PLACE CONCRETE CURB, TYPE B

STA. 104+83, LT
STA. 105+13, LT

REMOVAL OF EXISTING CURB

STA. 104+83, LT
STA. 105+13, LT

PORTLAND CEMENT CONCRETE SIDEWALK, 5 INCH

STA. 104+83, LT
STA. 105+13, LT

DETECTABLE WARNING SURFACE

STA. 104+83, LT
STA. 105+13, LT

ADJUST ELEVATION OF VALVE BOX

SEE SHEETS 28-29

DURABLE & TEMPORARY 4 INCH WHITE LINE
(ALL LINES WILL INCLUDE G BREAKS FOR SIDE ROADS)

STA. 104+00 TO 109+00, SOLID LT & RT
STA. 104+99, DOUBLE SOLID LT (BAGLEY ST. TH-394)

DURABLE & TEMPORARY 8 INCH WHITE LINE

STA. 108+13 TO 108+33, RT (HYDRANT)
SEE SHEET 55

DURABLE & TEMPORARY 24 INCH STOP BAR

STA. 104+99, LT (BAGLEY ST. TH-394)

DURABLE & TEMPORARY LETTER OR SYMBOL

STA. 104+99, LT "STOP" (BAGLEY ST. TH-394)

DURABLE CROSSWALK MARKING, TYPE D TAPE

STA. 104+99, LT (BAGLEY ST. TH-394)
SEE SHEET 55 (TYP.)

TEMPORARY CROSSWALK MARKING, PAINT



STA. 104+99, LT (BAGLEY ST. TH-394)
SEE SHEET 55 (TYP.)

REMOVING SIGNS

AS SHOWN - 8

ERECTING SALVAGED SIGNS

AS SHOWN - 1

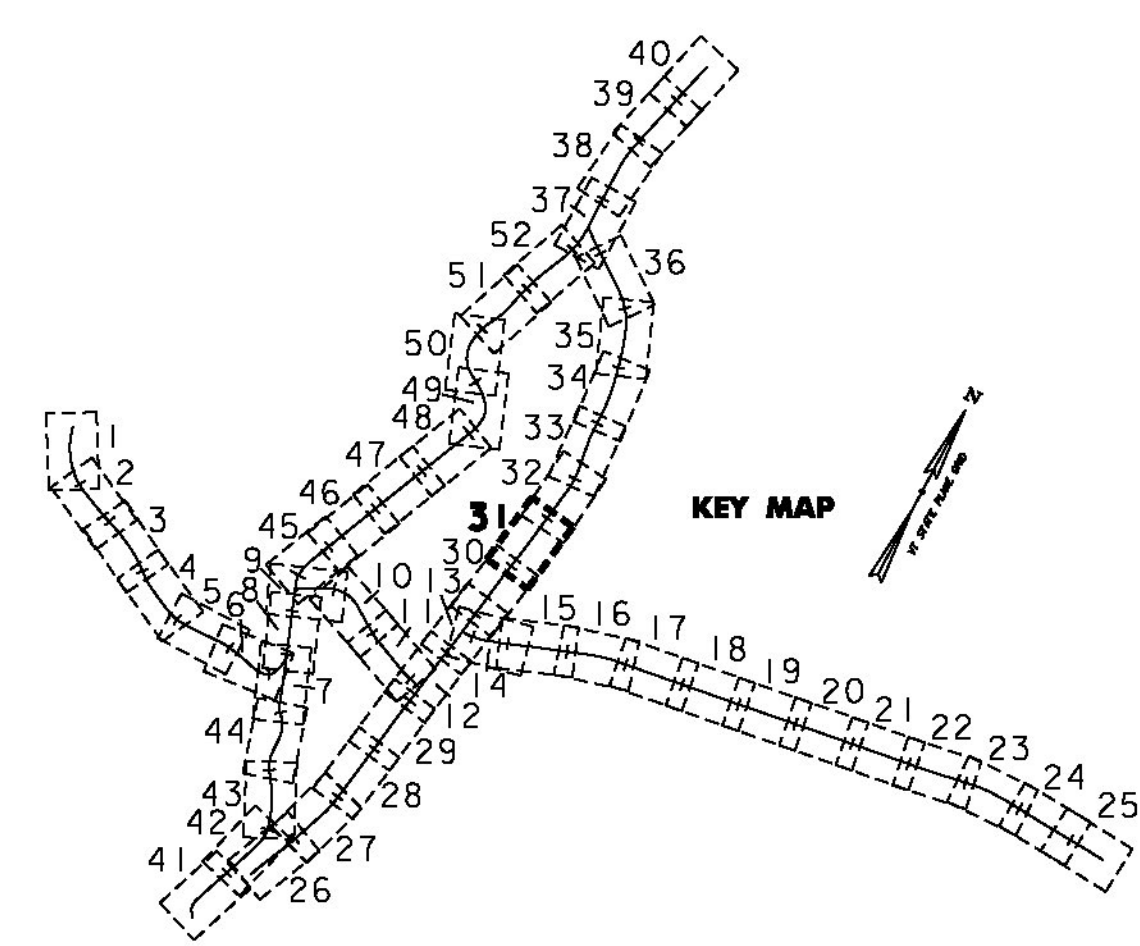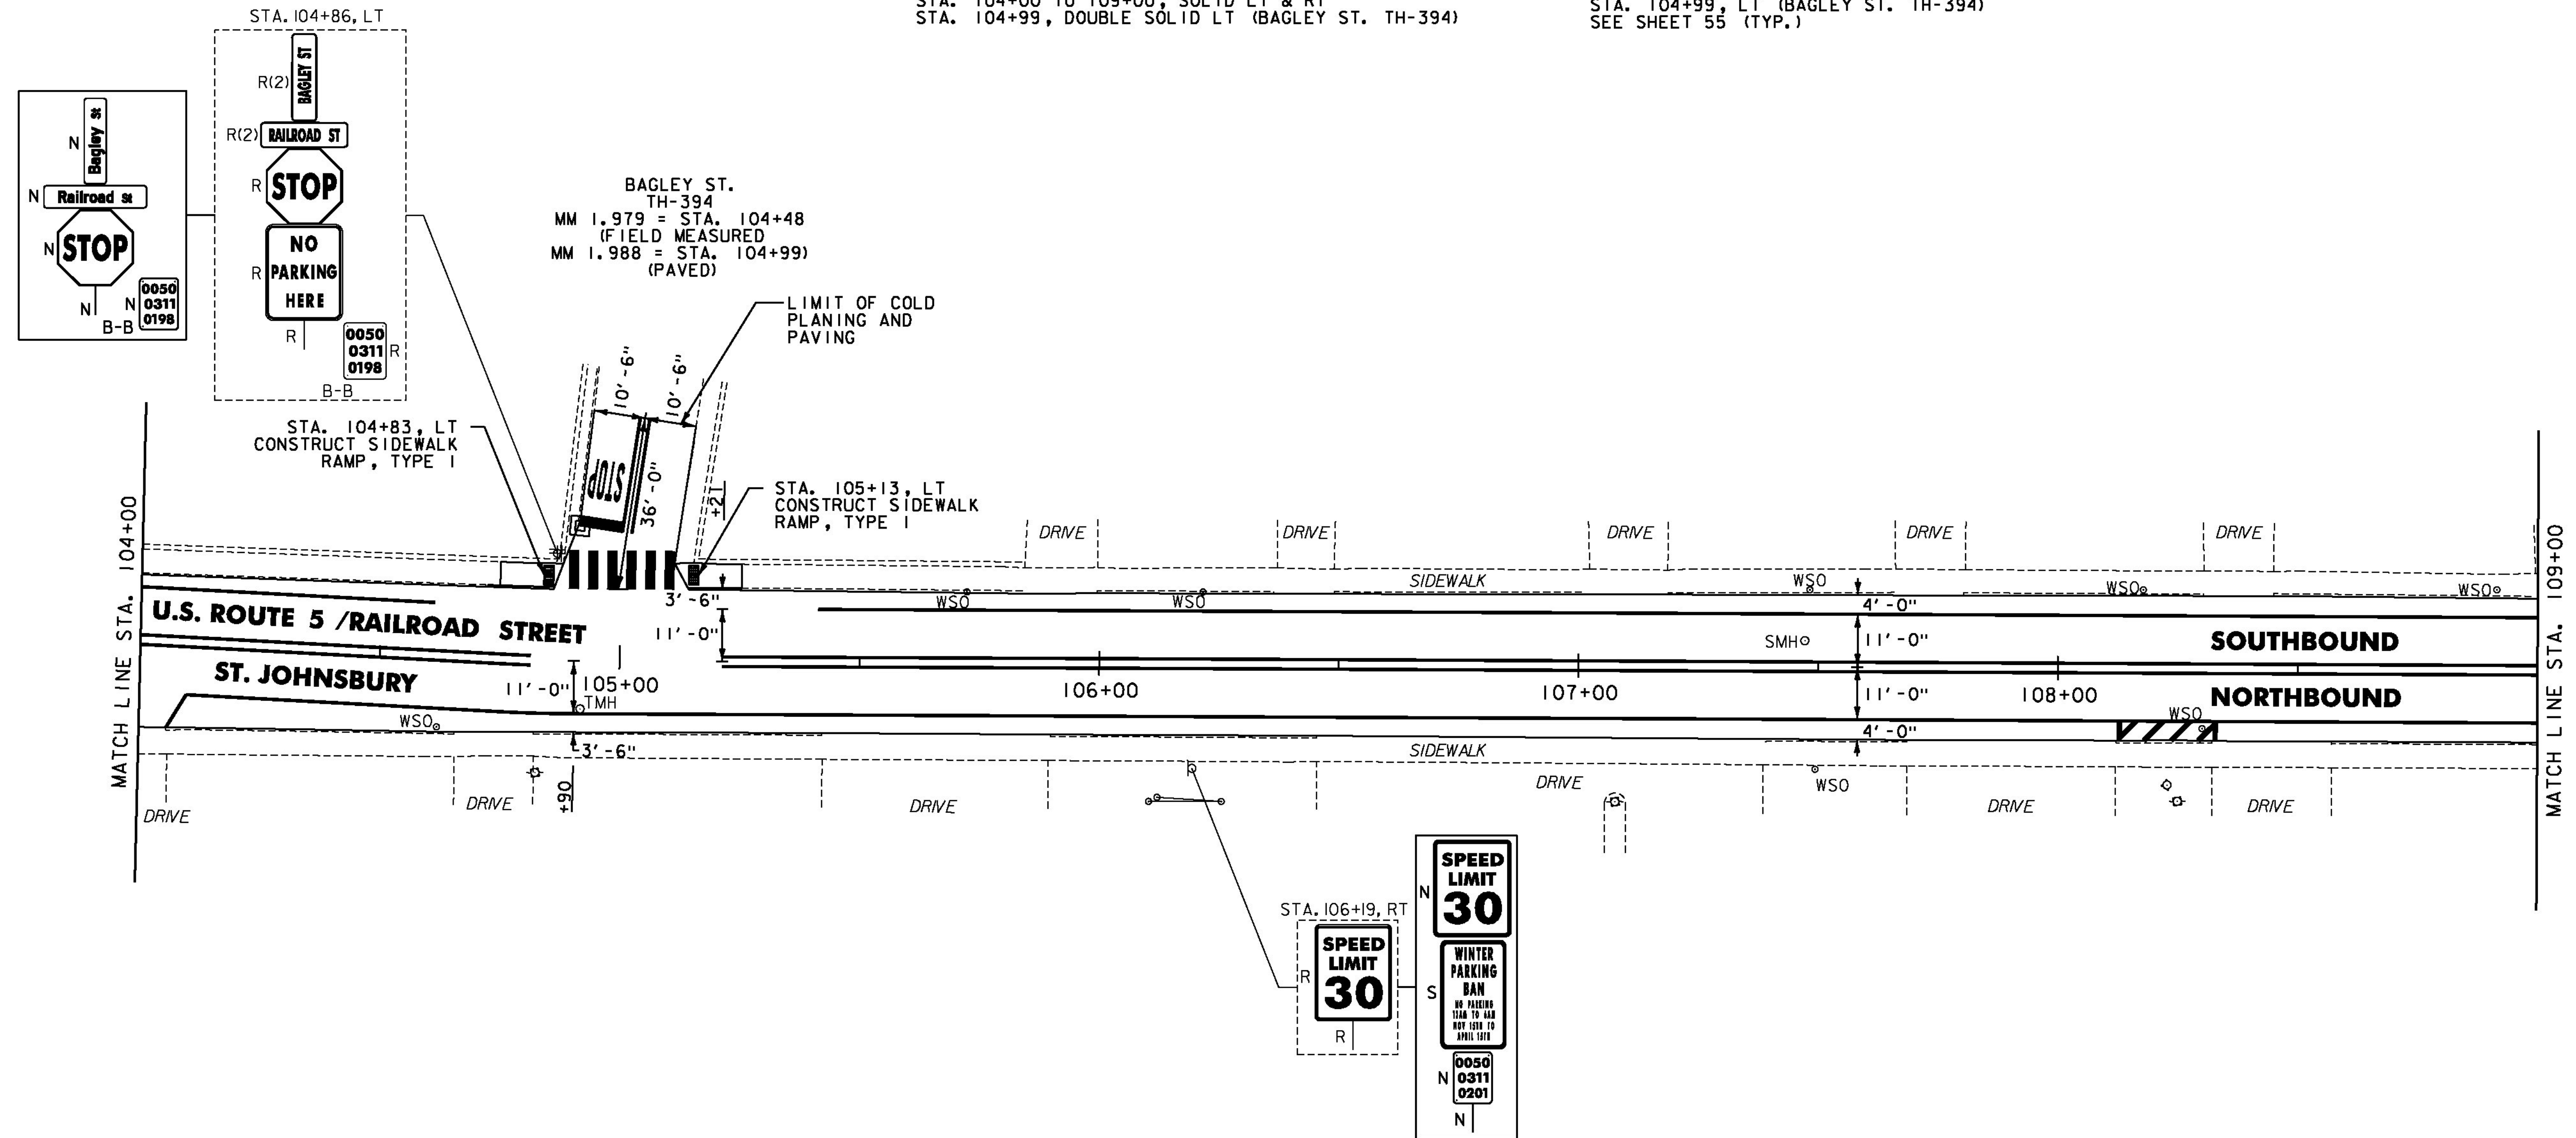

- NOTES:**
- FOR LEGENDS, SEE SHEET 3.
 - ALL EXISTING SIGNS NOT SHOWN ON THE PLANS SHALL BE RETAINED.

NOT TO SCALE



| | | |
|--|---|---|
| <p>PROJECT LAYOUT SHEET #31</p> | <p>PROJECT NAME: ST JOHNSBURY - LYNDON</p> <p>PROJECT NUMBER: STP 2936(I)</p> | |
| | <p>FILE NAME: pllc308.dgn</p> <p>PROJECT LEADER: G. EDWARDS</p> <p>DESIGNED BY: D. DRAPER</p> | <p>PLOT DATE: 5/5/2014</p> <p>DRAWN BY: D. DRAPER</p> <p>CHECKED BY: J. LITTLE</p> <p>SHEET 93 OF 250</p> |