

REHAB.
 DIS. CURBS OR MHS. CLASS I, II, OR III
 SEE SHEETS 27-28

TREATED TIMBER CURB
 STA. 5+00 TO 7+10, RT



STEEL BEAM GUARDRAIL, GALVANIZED W/8 FEET POSTS
 STA. 5+00 TO 10+00, RT

REMOVAL AND DISPOSAL OF GUARDRAIL
 STA. 5+00 TO 10+00, RT

DURABLE & TEMPORARY 4 INCH WHITE LINE
 (ALL LINES WILL INCLUDE EDGE LINE BREAKS
 AND RADII FOR SIDE ROADS)
 STA. 5+00 TO 10+00, SOLID LT & RT

DURABLE & TEMPORARY 4 INCH YELLOW LINE
 (ALL LINES WILL INCLUDE G BREAKS FOR SIDE ROADS)
 STA. 5+00 TO 10+00, SOLID LT & RT

REMOVING SIGNS
 AS SHOWN - 3

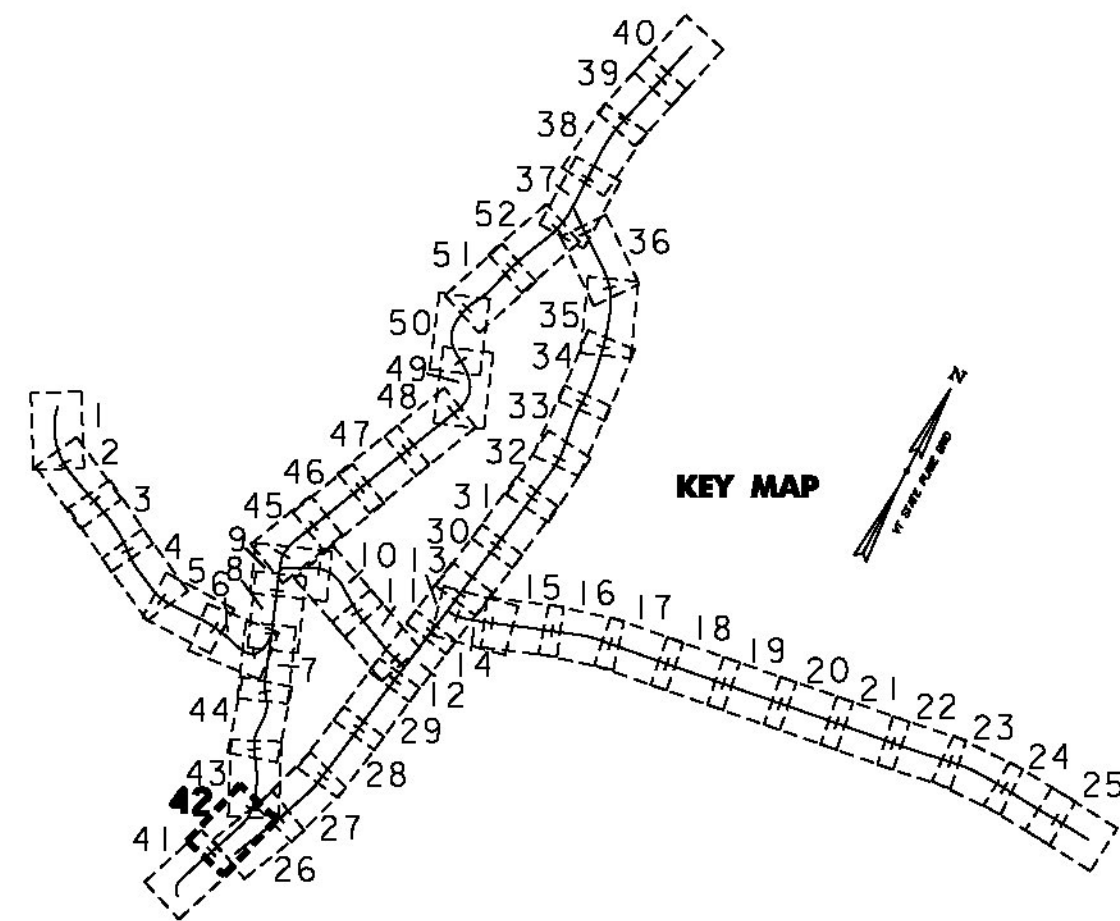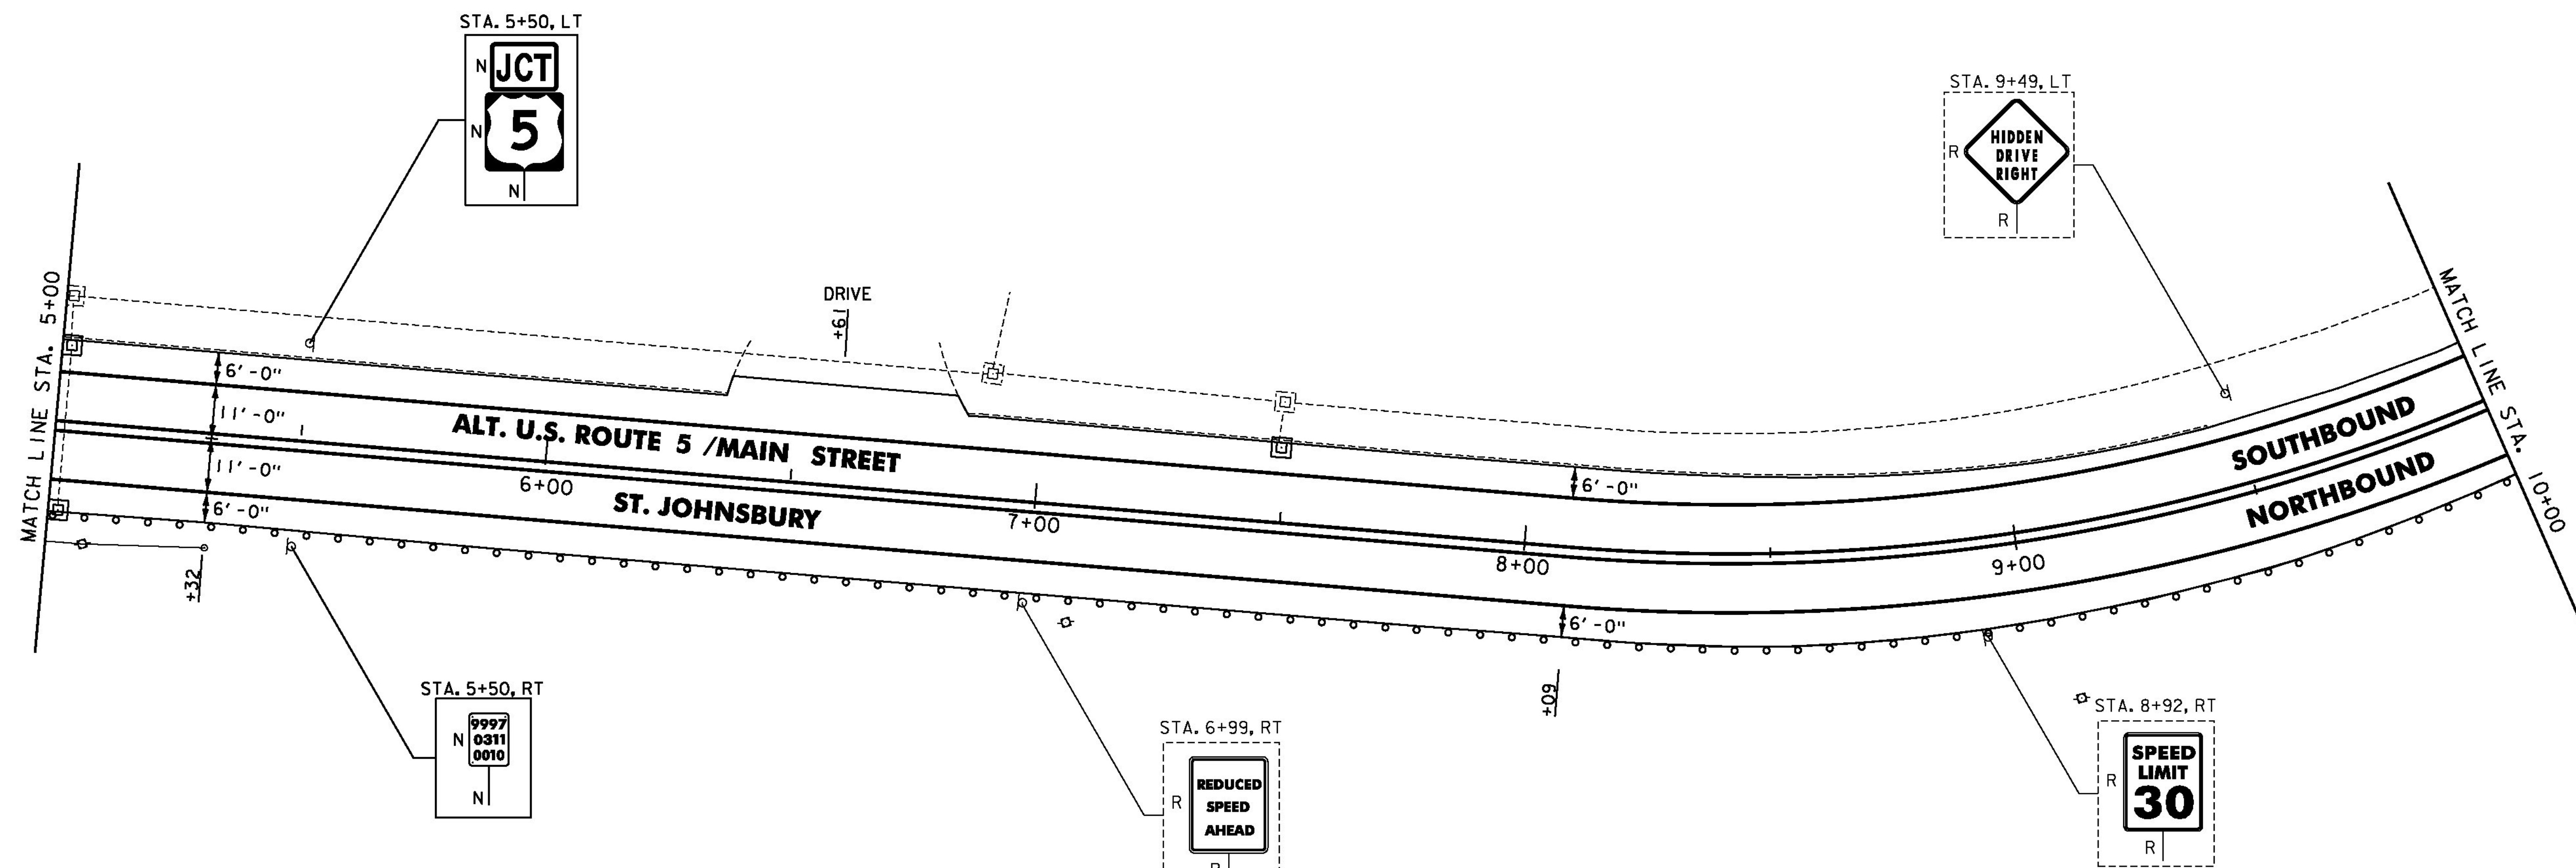

- NOTES:
- FOR LEGENDS, SEE SHEET 3.
 - ALL EXISTING SIGNS NOT SHOWN ON THE PLANS SHALL BE RETAINED.

NOT TO SCALE

PROJECT LAYOUT SHEET #42



PROJECT NAME: ST JOHNSBURY - LYNDON
 PROJECT NUMBER: STP 2936(I)

FILE NAME: pllc308.dgn
 PROJECT LEADER: G. EDWARDS
 DESIGNED BY: D. DRAPER

PLOT DATE: 5/5/2014
 DRAWN BY: D. DRAPER
 CHECKED BY: J. LITTLE
 SHEET 106 OF 250