


**FOR ALL CONSTRUCTION NOTES
SEE SHEET 124**

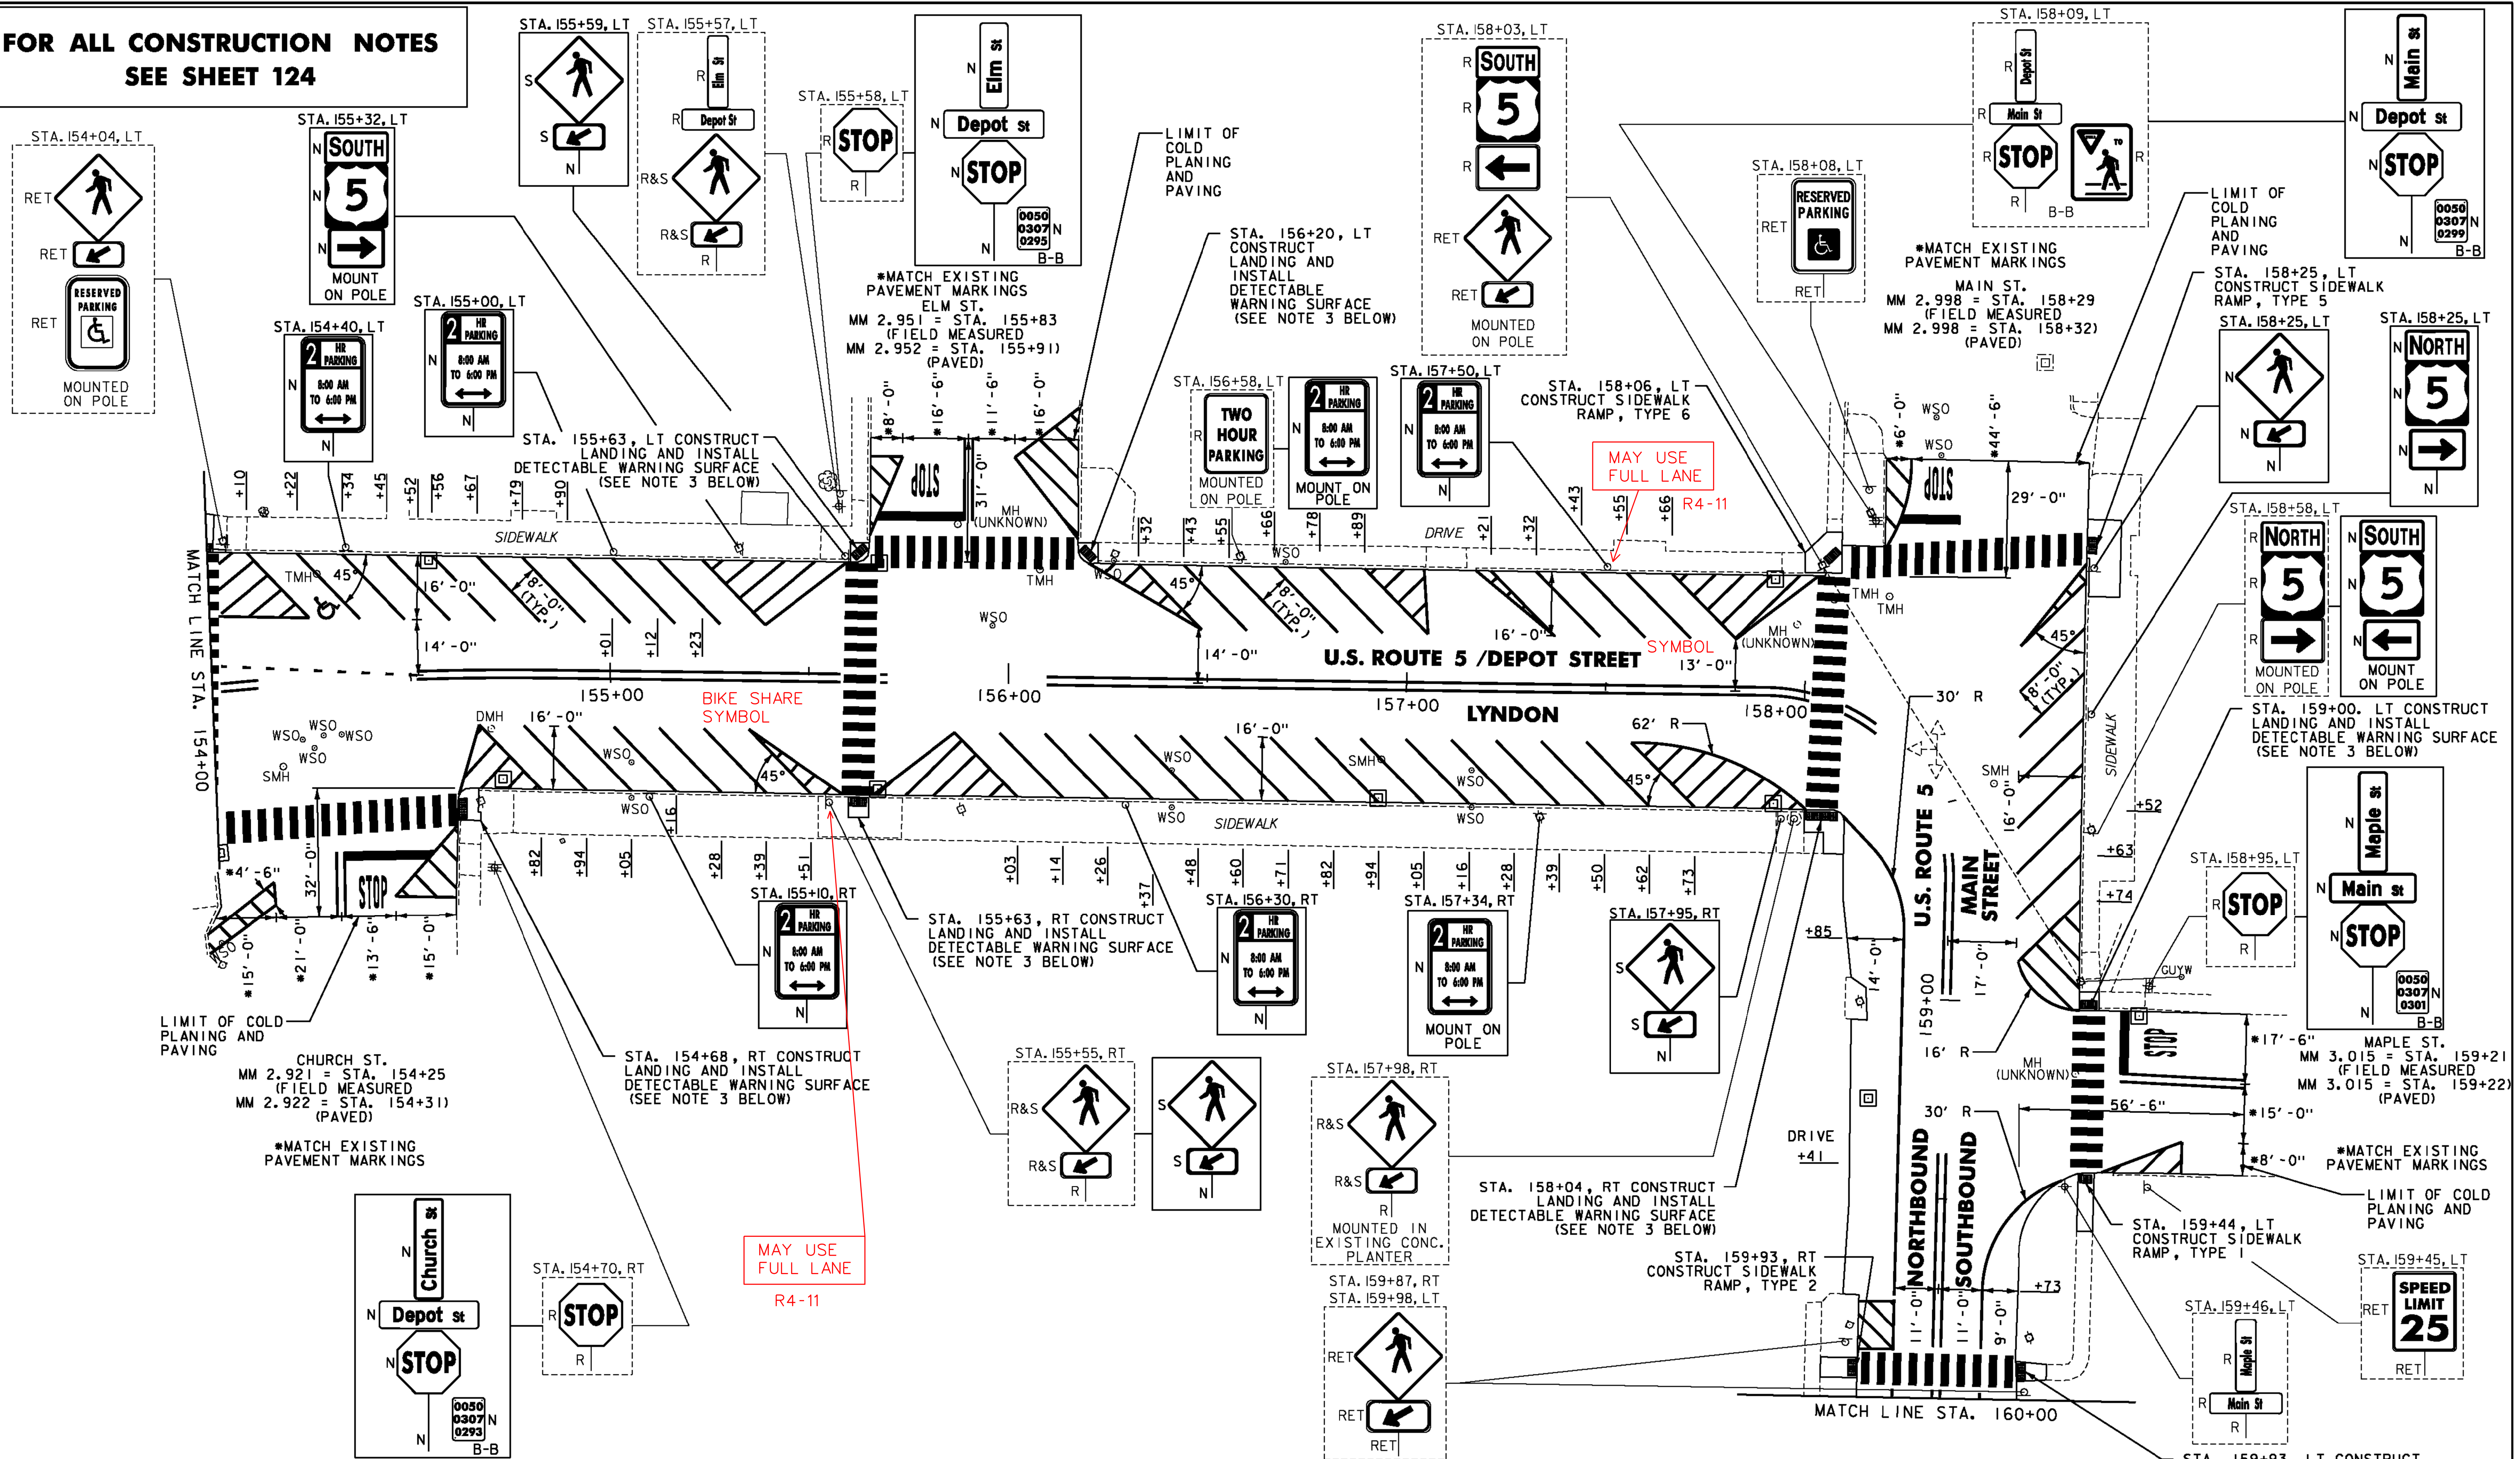

- NOTES:**
- FOR LEGENDS, SEE SHEET 3.
 - ALL EXISTING SIGNS NOT SHOWN ON THE PLANS SHALL BE RETAINED.
 - THE SIDEWALK "LANDINGS" NOTED CONSIST OF THE REMOVAL AND REPLACEMENT OF A SINGLE SLAB OF CONCRETE SIDEWALK IN ORDER TO INSTALL A NEW DETECTABLE WARNING SURFACE. SEE SHEETS 12-25.
 - SEE SHEET 245 FOR FLASHING BEACON DETAILS.

NOT TO SCALE

<p>PROJECT LAYOUT SHEET #57A</p>	<p>PROJECT NAME: ST JOHNSBURY - LYNDON</p> <p>PROJECT NUMBER: STP 2936(I)</p>
	<p>FILE NAME: pllc308.dgn</p> <p>PROJECT LEADER: G. EDWARDS</p> <p>DESIGNED BY: D. DRAPER</p>
	<p>PLOT DATE: 5/5/2014</p> <p>DRAWN BY: D. DRAPER</p> <p>CHECKED BY: J. LITTLE</p> <p>SHEET 123 OF 250</p>

