

CHANGING ELEVATION OF DIS, CBS OR MHS
SEE SHEET 27

REHAB.
DIS, CBS OR MHS, CLASS I, II OR III
SEE SHEETS 27-28

CHANGING ELEVATION OF SEWER MANHOLES
SEE SHEET 28

BITUMINOUS CONCRETE GUTTERS AND TRAFFIC ISLANDS

STA. 161+45 TO 161+64, RT
SEE SHEET 56 (TYP.)
STA. 161+50, LT
STA. 162+65, LT
STA. 163+15, RT
STA. 164+02, RT

PORTLAND CEMENT
CONCRETE SIDEWALK, 5 INCH

STA. 163+40, RT
STA. 163+82, RT

DETECTABLE WARNING SURFACE

STA. 163+40, RT
STA. 163+82, RT

DURABLE & TEMPORARY 4 INCH WHITE LINE
(ALL LINES WILL INCLUDE EDGE LINE BREAKS
AND RADII FOR SIDE ROADS)
STA. 160+00 TO 164+50, LT - RT
STA. 163+04 TO 163+36, SOLID RT (NO PARKING)
STA. 163+61, SOLID RT (NO PARKING, MIDDLE ST.)

DURABLE & TEMPORARY 4 INCH YELLOW LINE
(ALL LINES WILL INCLUDE ϕ BREAKS FOR SIDE ROADS & CROSSWALKS)
STA. 160+00 TO 164+50, SOLID LT & RT
STA. 163+53, DOUBLE SOLID LT (PARK AVE.)
STA. 163+61, DOUBLE SOLID RT (MIDDLE ST.)


DURABLE & TEMPORARY 24 INCH STOP BAR
STA. 163+53, LT (PARK AVE.)
STA. 163+61, RT (MIDDLE ST.)

DURABLE & TEMPORARY LETTER OR SYMBOL
STA. 163+53, LT "STOP" (PARK AVE.)
STA. 163+61, RT "STOP" (MIDDLE ST.)

TEMPORARY CROSSWALK MARKING, PAINT
STA. 163+61, RT (MIDDLE ST.)
STA. 163+76, LT TO 163+79, RT
SEE SHEET 55 (TYP.)

DURABLE CROSSWALK MARKING, TYPE A TAPE
STA. 163+61, RT (MIDDLE ST.)
STA. 163+76, LT TO 163+79, RT
SEE SHEET 55 (TYP.)

REMOVING SIGNS
AS SHOWN - 13

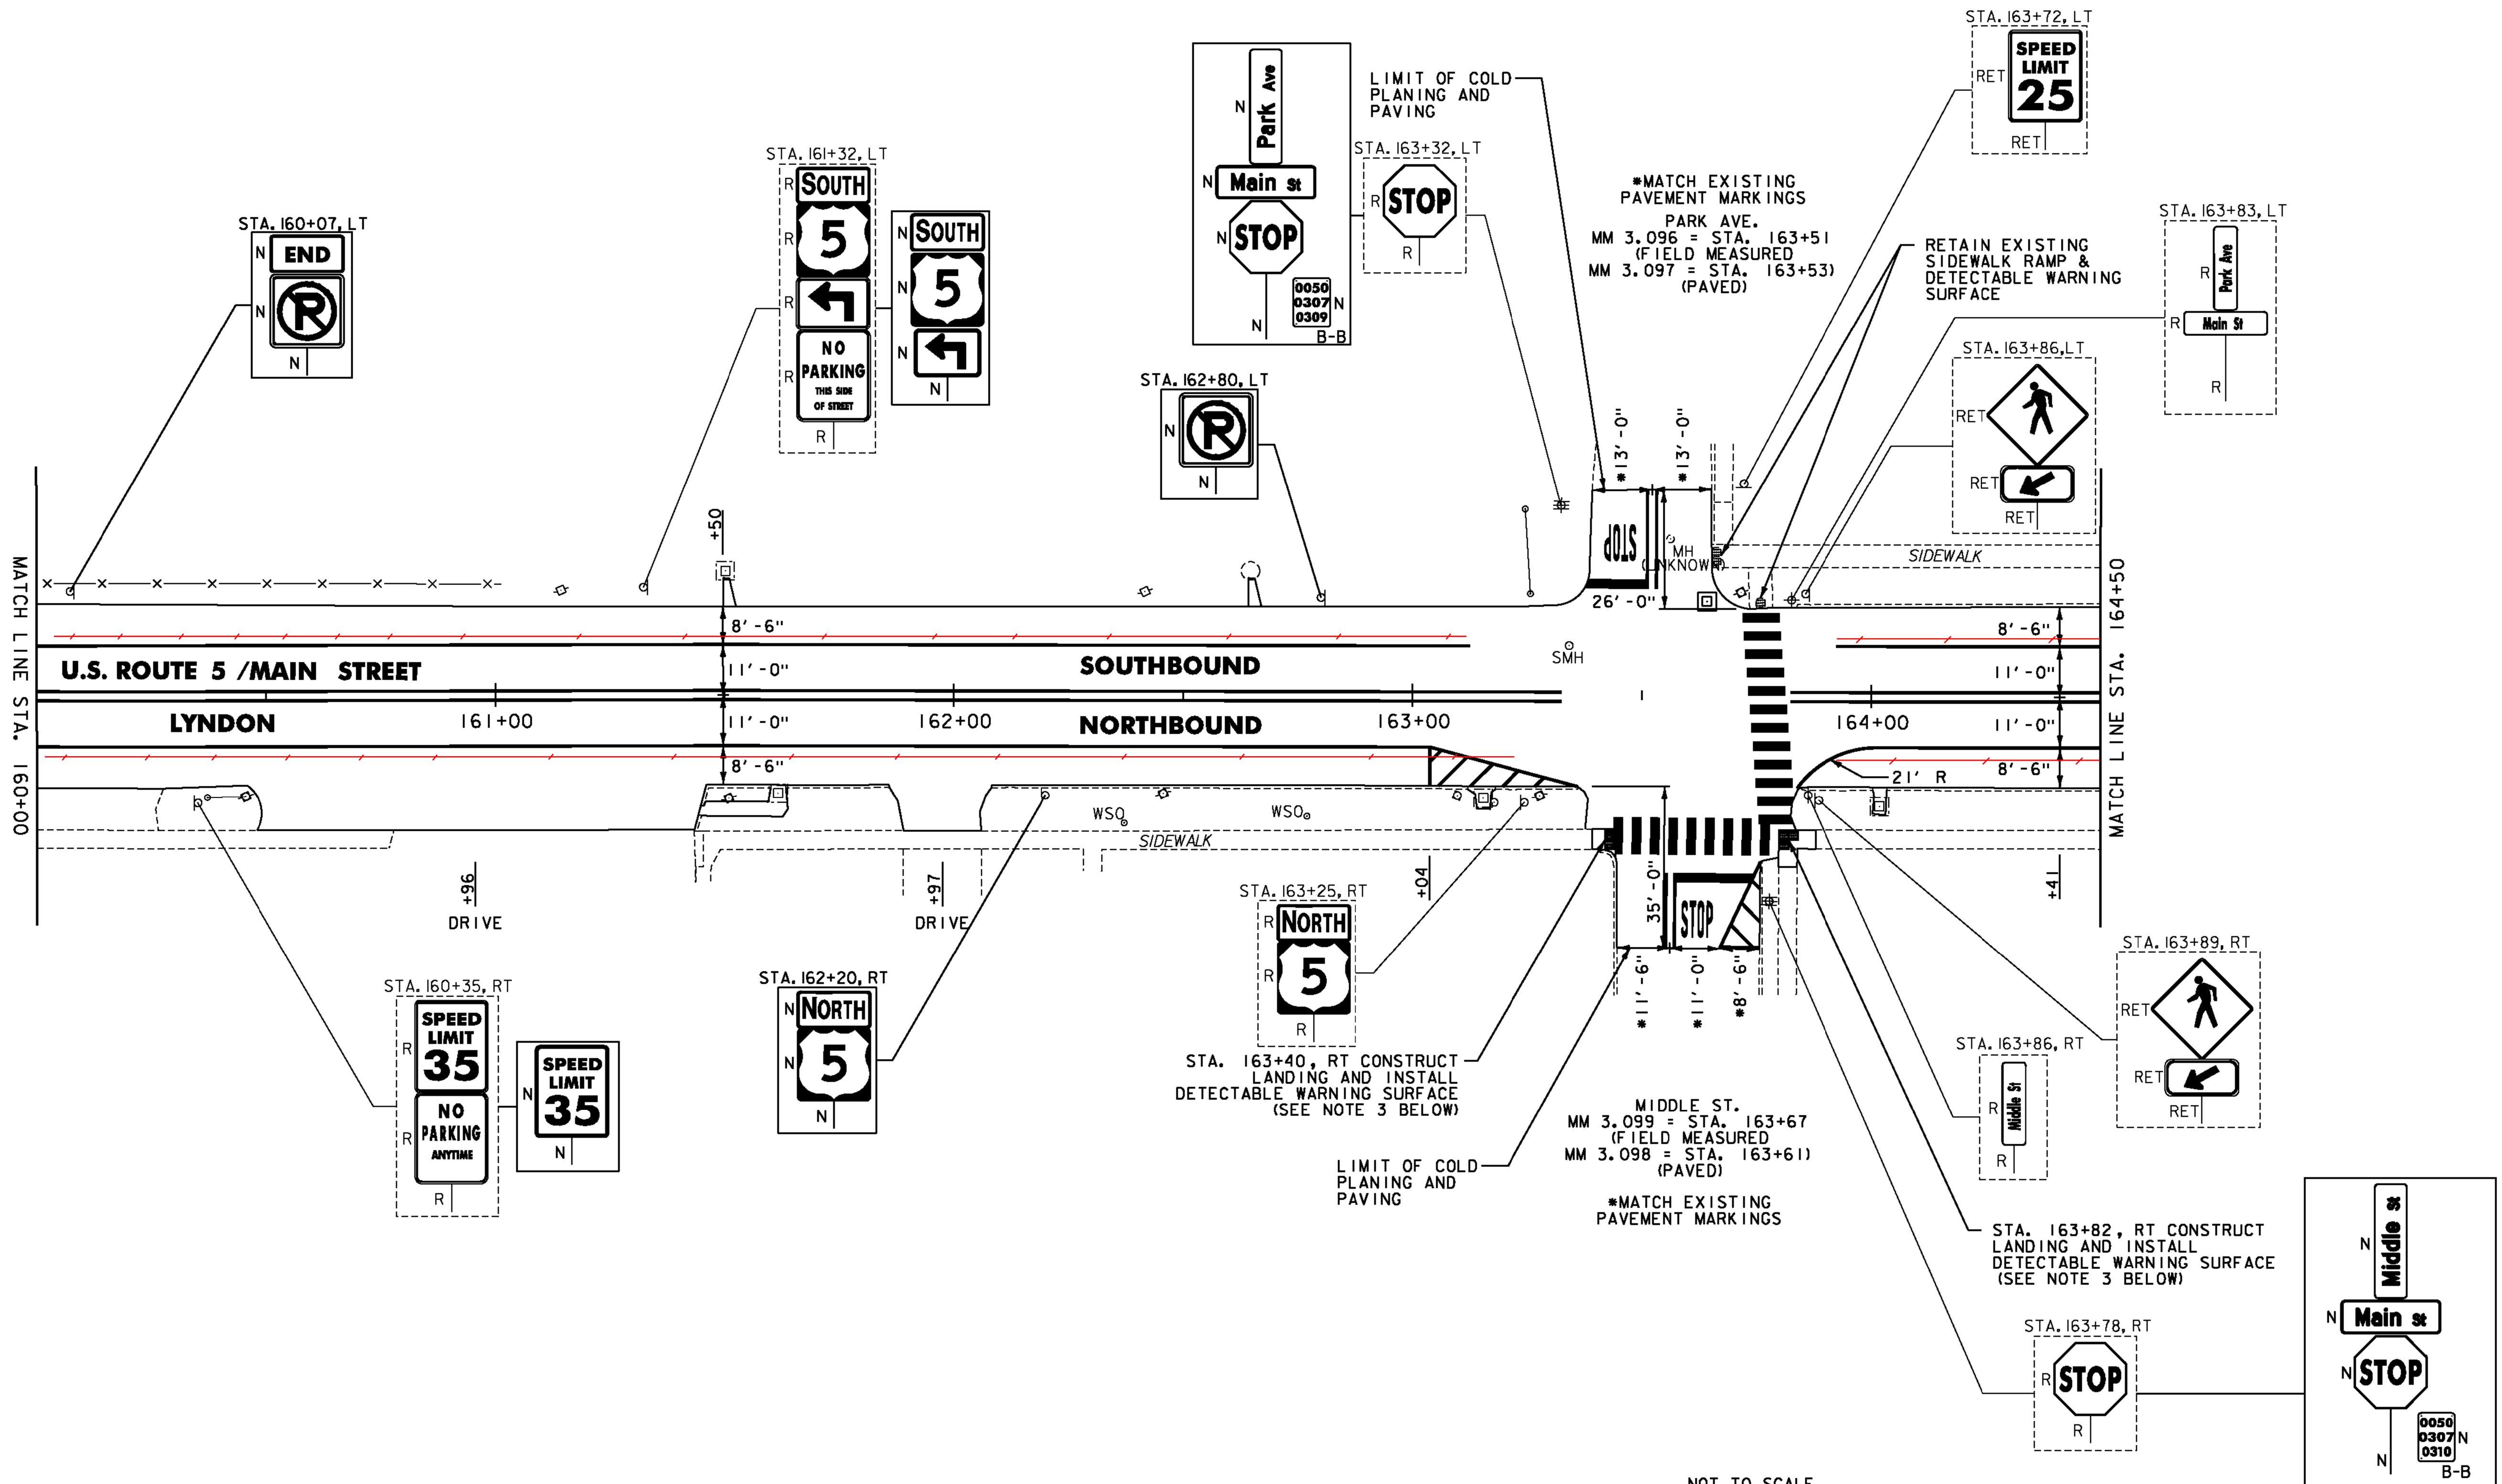

- NOTES:
- FOR LEGENDS, SEE SHEET 3.
 - ALL EXISTING SIGNS NOT SHOWN ON THE PLANS SHALL BE RETAINED.
 - THE SIDEWALK "LANDINGS" NOTED CONSIST OF THE REMOVAL AND REPLACEMENT OF A SINGLE SLAB OF CONCRETE SIDEWALK IN ORDER TO INSTALL A NEW DETECTABLE WARNING SURFACE. SEE SHEETS 12-25.



NOT TO SCALE

PROJECT LAYOUT SHEET #58

PROJECT NAME: ST JOHNSBURY - LYNDON
PROJECT NUMBER: STP 2936(I)

FILE NAME: pllc308.dgn
PROJECT LEADER: G. EDWARDS
DESIGNED BY: D. DRAPER

PLOT DATE: 5/5/2014
DRAWN BY: D. DRAPER
CHECKED BY: J. LITTLE
SHEET 125 OF 250