

REHAB,  
DIs, CBs OR MHS, CLASS I, II OR III  
SEE SHEETS 27-28

CHANGING ELEVATION OF SEWER MANHOLES  
SEE SHEET 28

CAST-IN-PLACE CONCRETE CURB, TYPE B  
STA. 171+53, LT

REMOVAL OF EXISTING CURB  
STA. 171+53, LT

PORTLAND CEMENT  
CONCRETE SIDEWALK, 5 INCH  
STA. 171+42, RT  
STA. 171+53, LT

DETECTABLE WARNING SURFACE  
STA. 171+42, RT  
STA. 171+53, LT

ADJUST ELEVATION OF VALVE BOX  
SEE SHEETS 28-29

DURABLE & TEMPORARY 4 INCH WHITE LINE  
(ALL LINES WILL INCLUDE EDGE LINE BREAKS  
AND RADIUS FOR SIDE ROADS)  
STA. 169+00 TO 174+50, SOLID LT - RT  
STA. 172+16, SOLID LT (EDGE LINES, POWERS PARK)

DURABLE & TEMPORARY 4 INCH YELLOW LINE  
(ALL LINES WILL INCLUDE C BREAKS FOR SIDE ROADS & CROSSWALKS)  
STA. 169+00 TO 174+50, SOLID LT & RT  
STA. 171+75, DOUBLE SOLID RT (GROVE ST.)  
STA. 172+16, DOUBLE SOLID LT (POWERS PARK)

DURABLE & TEMPORARY 8 INCH WHITE LINE  
STA. 171+21 TO 171+33, RT (HYDRANT)  
SEE SHEET 55


DURABLE & TEMPORARY 24 INCH STOP BAR  
STA. 171+75, RT (GROVE ST.)  
STA. 172+16, LT (POWERS PARK)

DURABLE & TEMPORARY LETTER OR SYMBOL  
STA. 171+75, RT "STOP" (GROVE ST.)  
STA. 172+16, LT "STOP" (POWERS PARK)

REMOVING SIGNS  
AS SHOWN - 8

DURABLE CROSSWALK MARKING, TYPE A TAPE  
STA. 171+42, RT TO 171+53, LT  
SEE SHEET 55 (TYP.)

TEMPORARY CROSSWALK MARKING, PAINT  
STA. 171+42, RT TO 171+53, LT  
SEE SHEET 55 (TYP.)

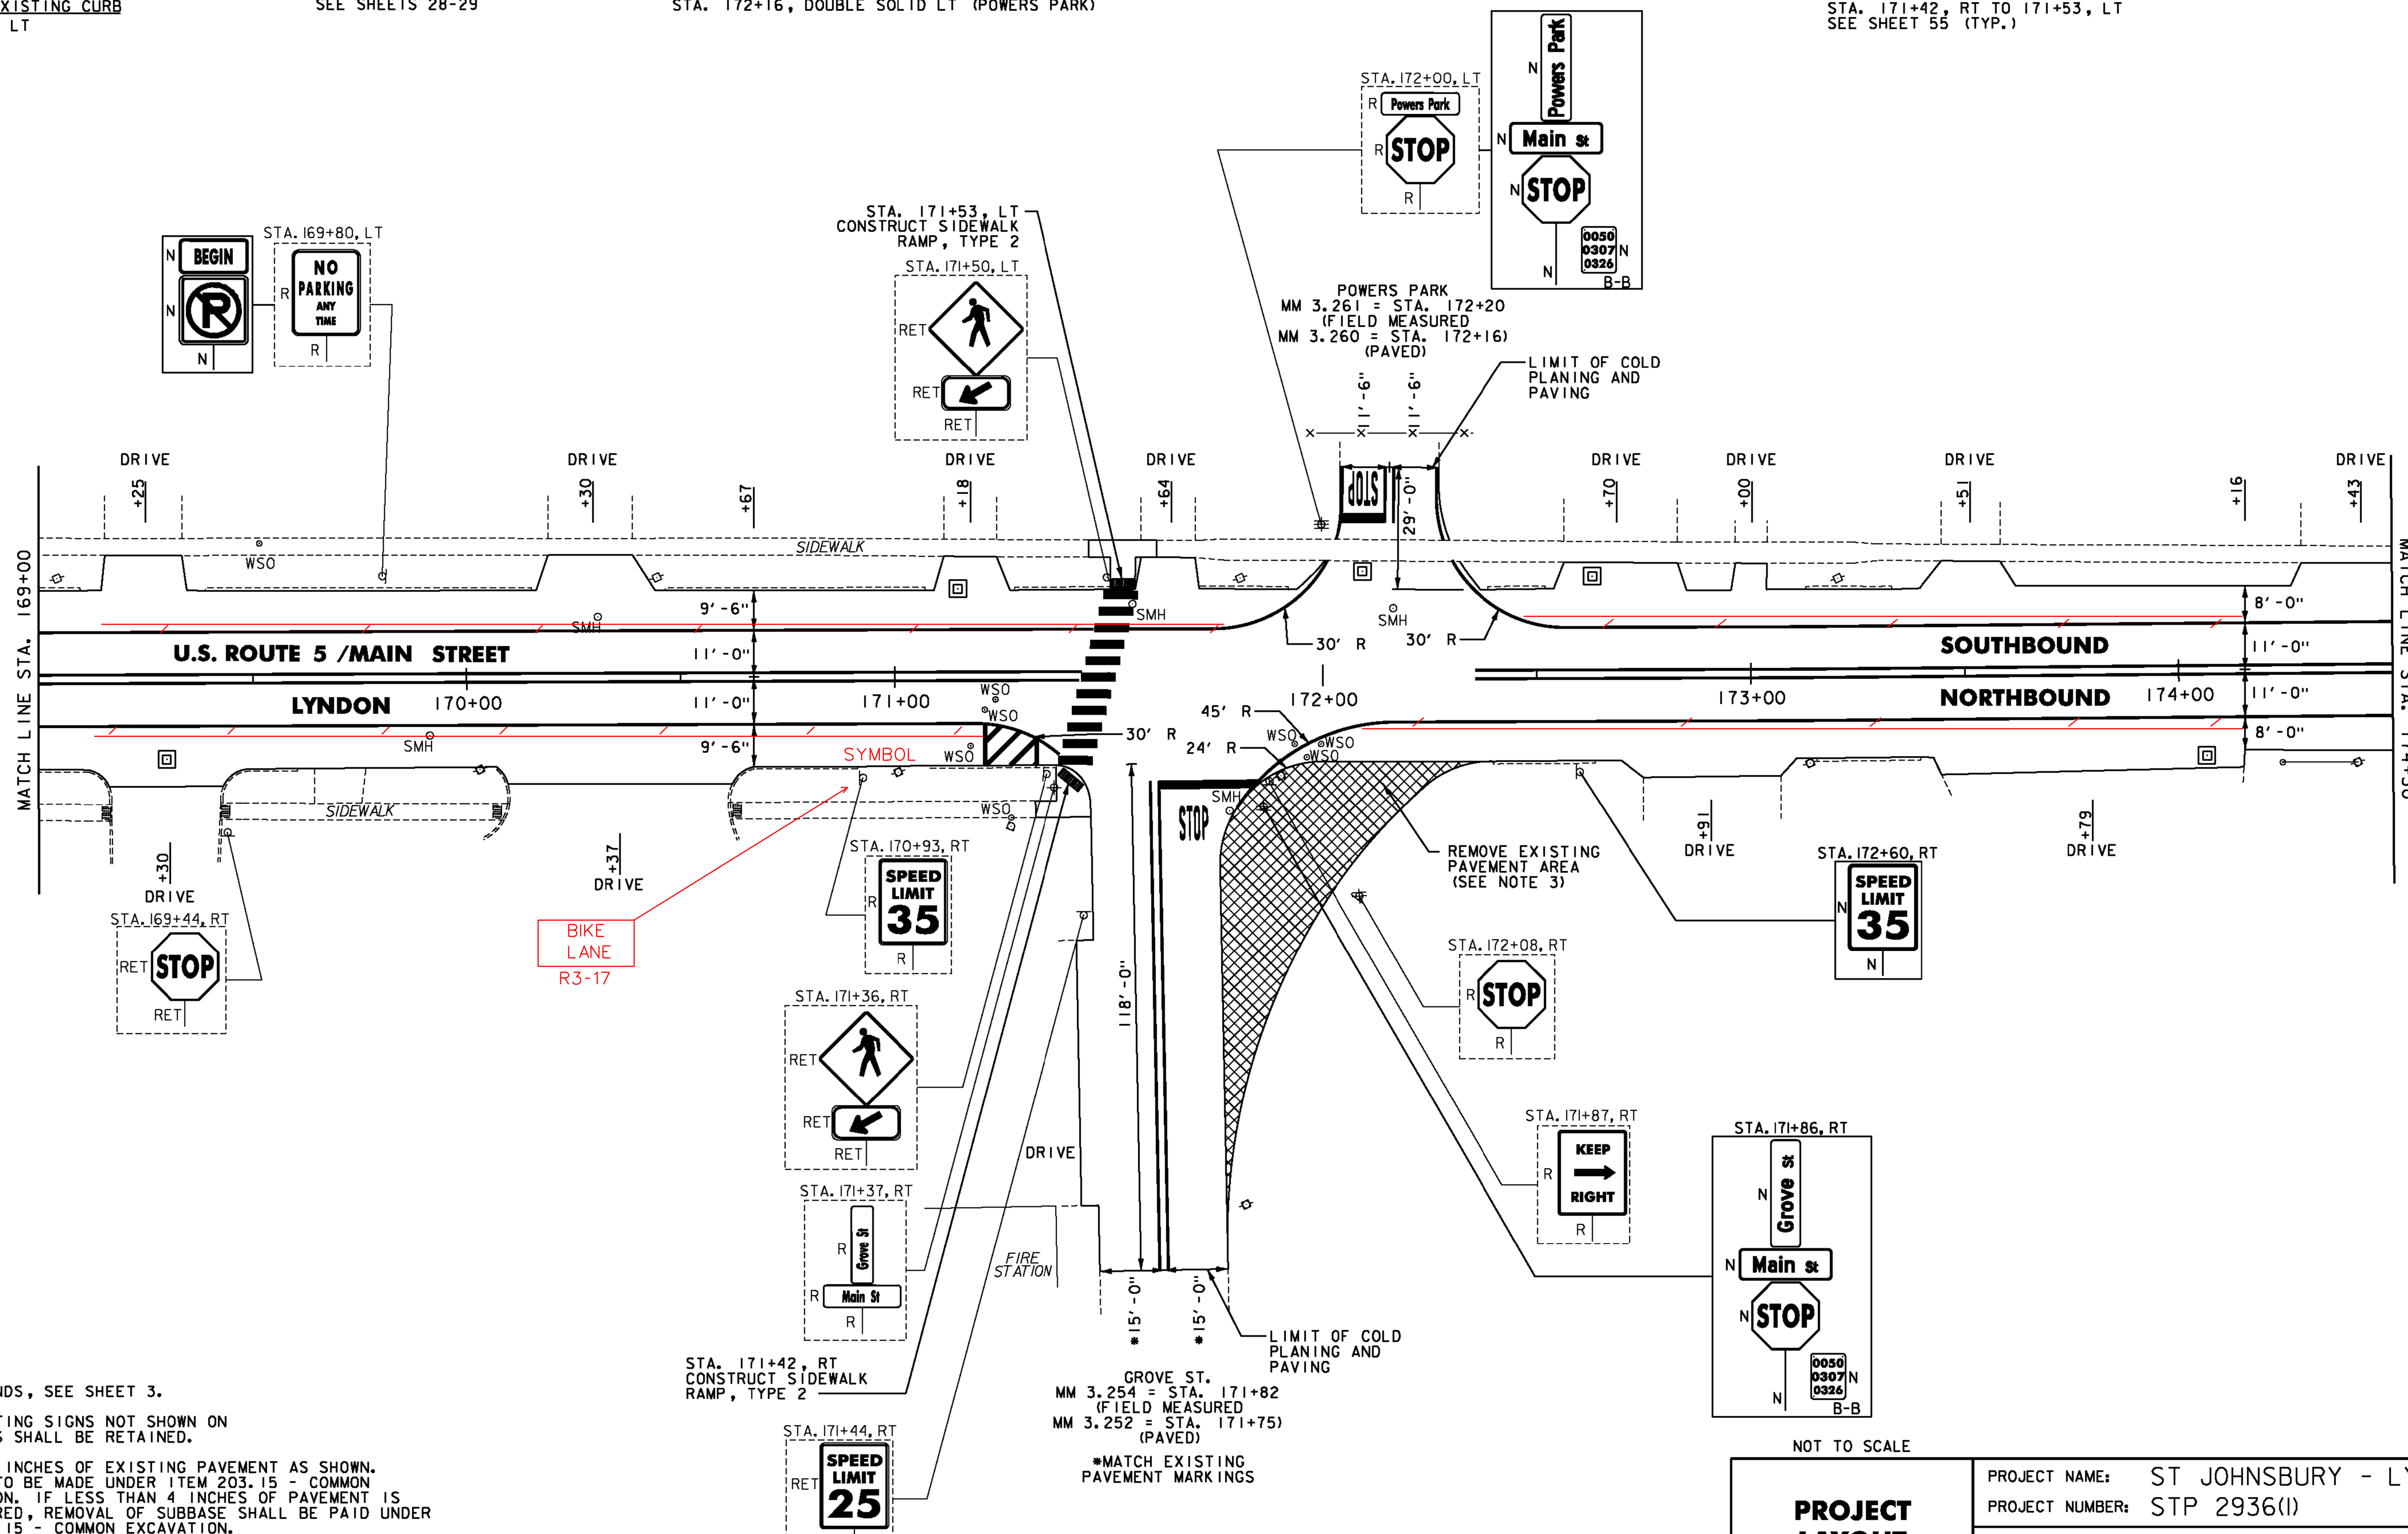

- NOTES:
- FOR LEGENDS, SEE SHEET 3.
  - ALL EXISTING SIGNS NOT SHOWN ON THE PLANS SHALL BE RETAINED.
  - REMOVE 4 INCHES OF EXISTING PAVEMENT AS SHOWN. PAYMENT TO BE MADE UNDER ITEM 203.15 - COMMON EXCAVATION. IF LESS THAN 4 INCHES OF PAVEMENT IS ENCOUNTERED, REMOVAL OF SUBBASE SHALL BE PAID UNDER ITEM 203.15 - COMMON EXCAVATION. REPLACE WITH 4 INCHES OF ITEM 651.35 - TOPSOIL, 651.15 - SEED, 651.18 - FERTILIZER, 651.20 - AGRICULTURAL LIMESTONE AND 653.20 - TEMPORARY EROSION MATTING. ESTIMATED QUANTITIES OF ALL THESE ITEMS HAVE BEEN INCLUDED FOR USE AS DIRECTED BY THE ENGINEER.

REMOVAL OF EXISTING PAVEMENT AREAS, SEE NOTE 3

NOT TO SCALE

**PROJECT LAYOUT SHEET #60**



PROJECT NAME:	ST JOHNSBURY - LYNDON	PLOT DATE:	5/5/2014
PROJECT NUMBER:	STP 2936(I)	DRAWN BY:	D. DRAPER
FILE NAME:	pllc308.dgn	CHECKED BY:	J. LITTLE
PROJECT LEADER:	G. EDWARDS	SHEET	127 OF 250
DESIGNED BY:	D. DRAPER		