

CHANGING ELEVATION OF DIS, CBS OR MHS
SEE SHEET 27

REHAB,
DIS, CBS OR MHS, CLASS I, II OR III
SEE SHEETS 27-28

CHANGING ELEVATION OF SEWER MANHOLES
SEE SHEET 28

PORTLAND CEMENT
CONCRETE SIDEWALK, 5 INCH
STA. 11+70, RT
STA. 12+35, RT

DETECTABLE WARNING SURFACE
STA. 11+70, RT
STA. 12+35, RT

DURABLE & TEMPORARY 4 INCH WHITE LINE
(ALL LINES WILL INCLUDE EDGE LINE BREAKS
AND RADIUS FOR SIDE ROADS)
STA. 11+00 TO 16+25, SOLID LT & RT
STA. 12+10, SOLID RT (EDGELINES, PARK AVENUE)

DURABLE & TEMPORARY 4 INCH YELLOW LINE
(ALL LINES WILL INCLUDE ϕ BREAKS FOR SIDE ROADS)
STA. 11+00 TO 16+25, SOLID LT & RT
STA. 12+10, DOUBLE SOLID RT (PARK AVENUE)

DURABLE & TEMPORARY 24 INCH STOP BAR
STA. 12+10, RT (PARK AVENUE)


DURABLE & TEMPORARY LETTER OR SYMBOL
STA. 12+10, RT "STOP" (PARK AVENUE)

DURABLE CROSSWALK MARKING, TYPE A TAPE
STA. 12+10, RT (PARK AVENUE)
SEE SHEET 55 (TYP.)

TEMPORARY CROSSWALK MARKING, PAINT
STA. 12+10, RT (PARK AVENUE)
SEE SHEET 55 (TYP.)

REMOVING SIGNS
AS SHOWN - 5

ERECTING SALVAGED SIGNS
AS SHOWN - 1

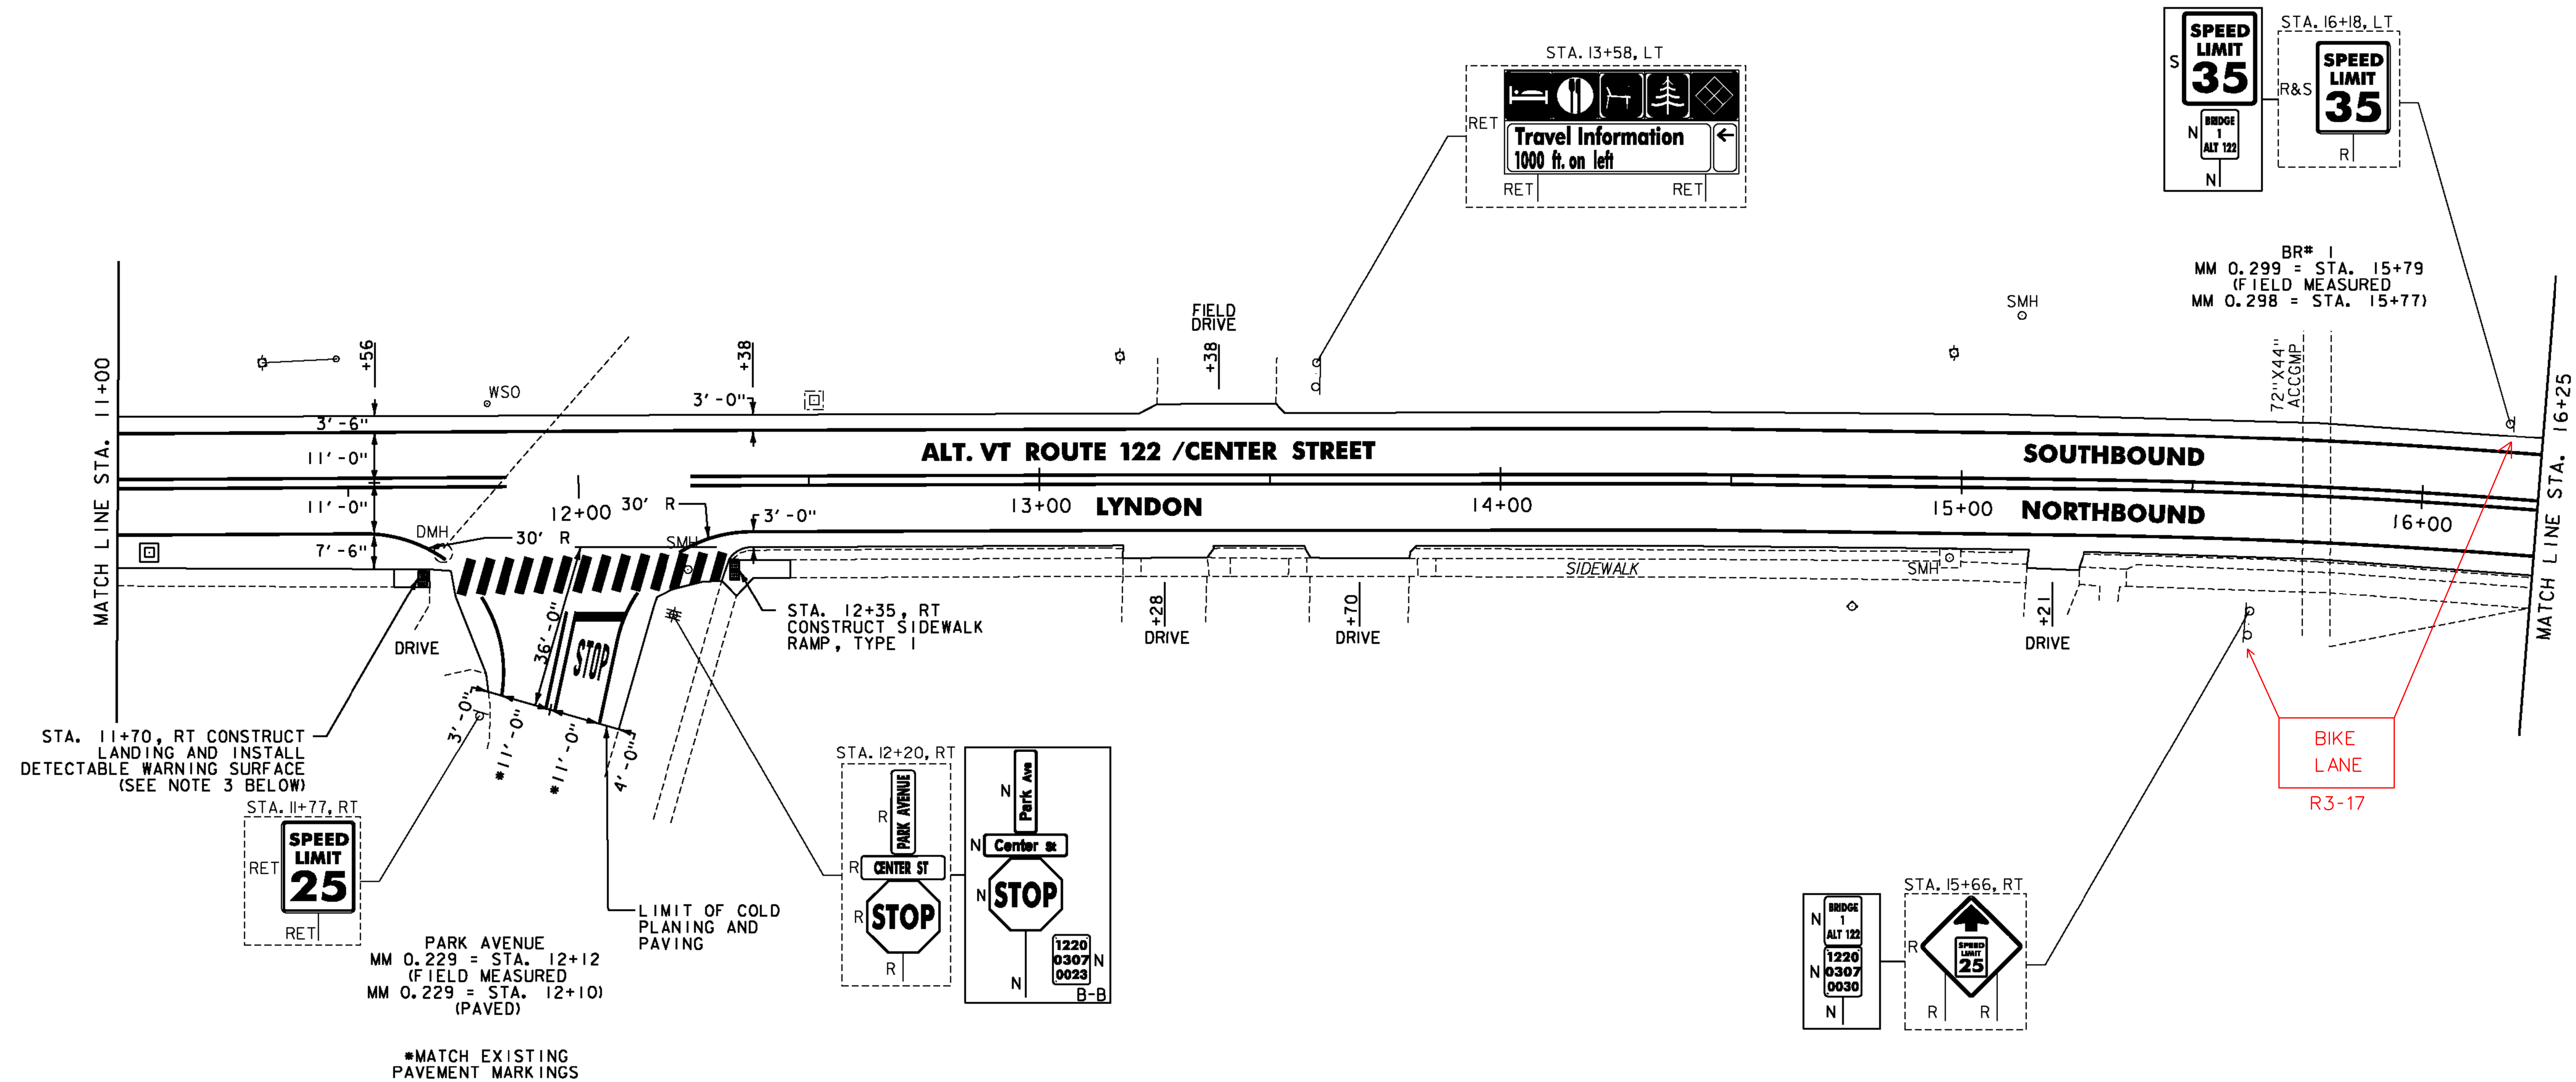

NOTES:

- FOR LEGENDS, SEE SHEET 3.
- ALL EXISTING SIGNS NOT SHOWN ON THE PLANS SHALL BE RETAINED.
- THE SIDEWALK "LANDINGS" NOTED CONSIST OF THE REMOVAL AND REPLACEMENT OF A SINGLE SLAB OF CONCRETE SIDEWALK IN ORDER TO INSTALL A NEW DETECTABLE WARNING SURFACE. SEE SHEETS 12-25.

NOT TO SCALE



PROJECT LAYOUT SHEET #66

PROJECT NAME:	ST JOHNSBURY - LYNDON
PROJECT NUMBER:	STP 2936(I)
FILE NAME:	pllc308.dgn
PROJECT LEADER:	G. EDWARDS
DESIGNED BY:	D. DRAPER
PLOT DATE:	5/5/2014
DRAWN BY:	D. DRAPER
CHECKED BY:	J. LITTLE
SHEET	133 OF 250