

REHAB.
Dis, CBs OR MHS, CLASS I, II OR III
SEE SHEETS 27-28

ADJUST ELEVATION OF VALVE BOX
SEE SHEETS 28-29

DURABLE & TEMPORARY 4 INCH WHITE LINE
(ALL LINES WILL INCLUDE EDGE LINE BREAKS
AND RADII FOR SIDE ROADS)
STA. 26+50 TO 30+50, SOLID LT & RT
STA. 28+91, SOLID LT (EDGELINES, BACK CENTER ROAD)

DURABLE & TEMPORARY 24 INCH STOP BAR
STA. 28+67, RT
STA. 28+91, LT (BACK CENTER ROAD)


DURABLE & TEMPORARY LETTER OR SYMBOL
STA. 28+58, RT "STOP"
STA. 28+91, LT "STOP" (BACK CENTER ROAD)

REMOVING SIGNS
AS SHOWN - 6

ERECTING SALVAGED SIGNS
AS SHOWN - 2

CHANGING ELEVATION OF SEWER MANHOLES
SEE SHEET 28

DURABLE & TEMPORARY 4 INCH YELLOW LINE
(ALL LINES WILL INCLUDE $\frac{1}{2}$ BREAKS FOR SIDE ROADS)
STA. 26+50 TO 30+50, SOLID LT & RT
STA. 28+91, DOUBLE SOLID LT (BACK CENTER ROAD)

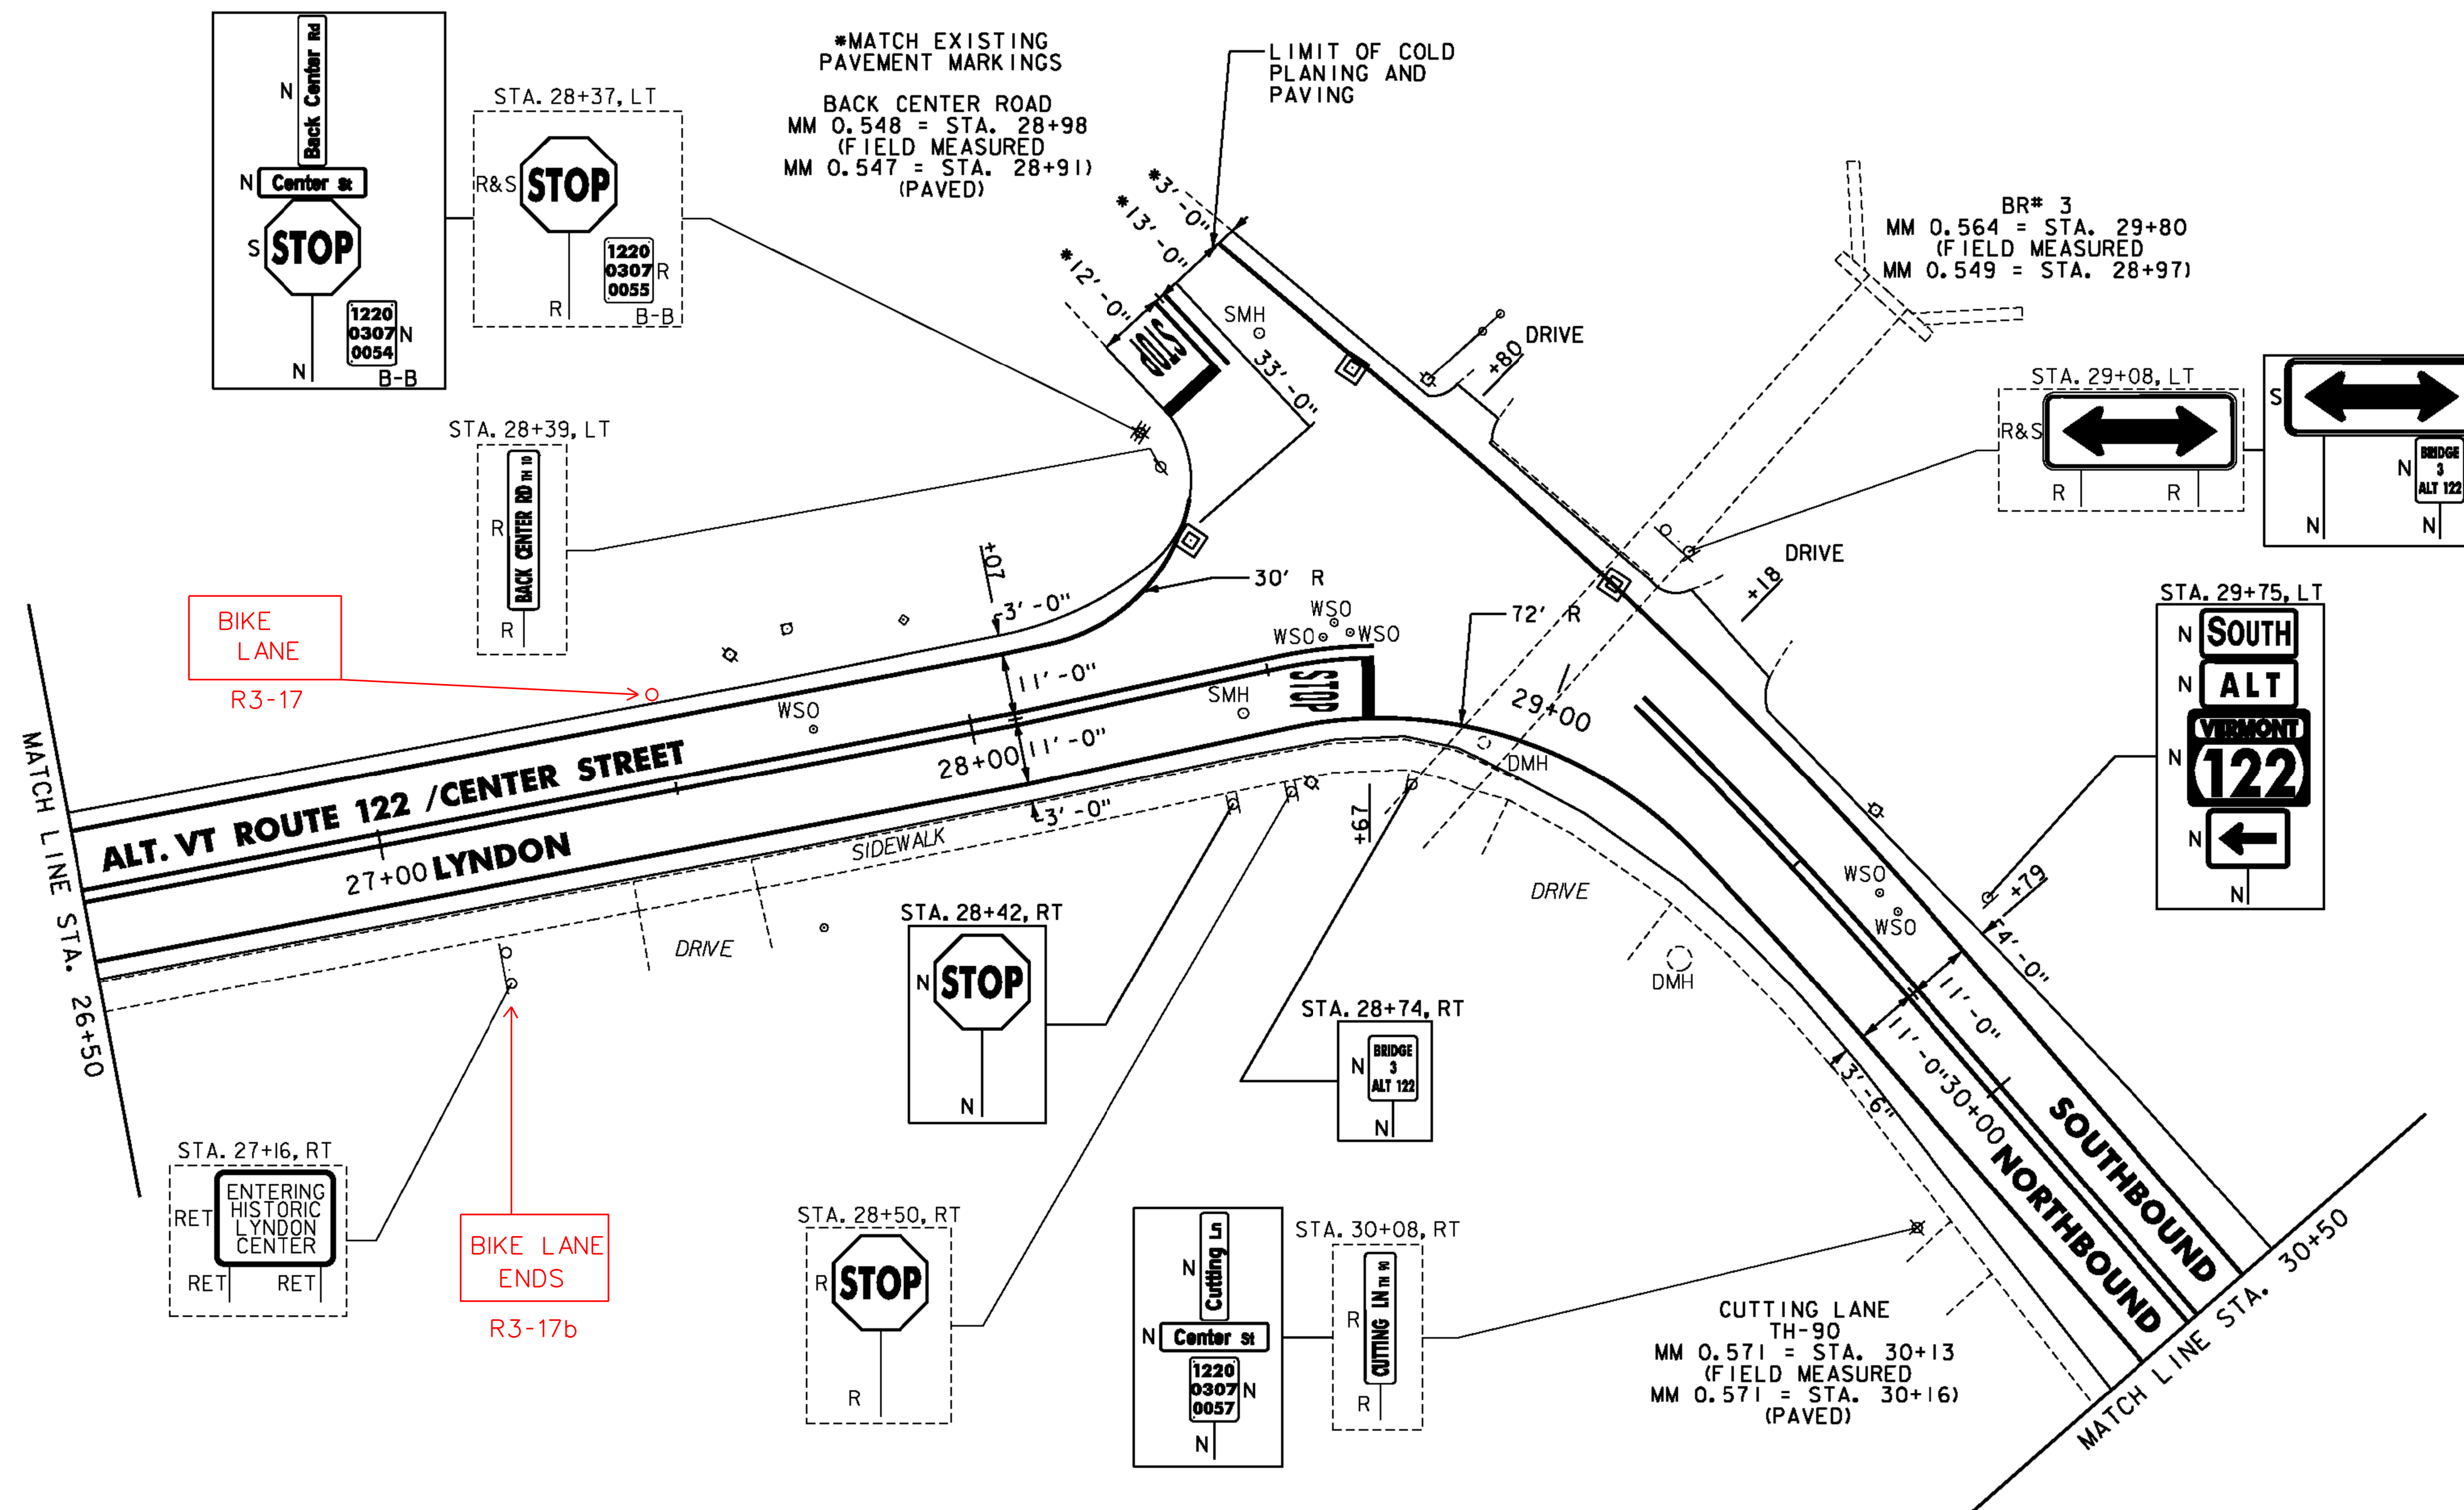

NOTES:

- FOR LEGENDS, SEE SHEET 3.
- ALL EXISTING SIGNS NOT SHOWN ON THE PLANS SHALL BE RETAINED.



NOT TO SCALE

PROJECT LAYOUT SHEET #69

PROJECT NAME: ST JOHNSBURY - LYNDON

PROJECT NUMBER: STP 2936(I)

FILE NAME: pllc308.dgn
PROJECT LEADER: G. EDWARDS
DESIGNED BY: D. DRAPER

PLOT DATE: 5/5/2014
DRAWN BY: D. DRAPER
CHECKED BY: J. LITTLE
SHEET 136 OF 250