

REHAB.
DIs, CBs OR MHS, CLASS I, II OR III
SEE SHEETS 27-28

CHANGING ELEVATION OF SEWER MANHOLES
SEE SHEET 28

BITUMINOUS CONCRETE GUTTERS AND
TRAFFIC ISLANDS
STA. 33+75 TO 33+93, LT
SEE SHEET 56 (TYP.)
STA. 35+60, LT

PORTLAND CEMENT
CONCRETE SIDEWALK, 8 INCH
STA. 32+84, RT
STA. 32+84, LT

DETECTABLE WARNING SURFACE
STA. 32+84, RT
STA. 32+84, LT

ADJUST ELEVATION OF VALVE BOX
SEE SHEETS 28-29

DURABLE & TEMPORARY 4 INCH WHITE LINE
(ALL LINES WILL INCLUDE EDGE LINE BREAKS
AND RADIUS FOR SIDE ROADS)
STA. 30+50 TO 36+00, SOLID LT & RT
STA. 33+08, SOLID LT (EDGELINES, COLLEGE ROAD TH-9)

DURABLE & TEMPORARY 4 INCH YELLOW LINE
(ALL LINES WILL INCLUDE G BREAKS FOR SIDE ROADS & CROSSWALKS)
STA. 30+50 TO 36+00, SOLID LT & RT
STA. 33+08, DOUBLE SOLID LT (COLLEGE ROAD TH-9)

DURABLE & TEMPORARY 8 INCH WHITE LINE
STA. 33+73 TO 33+85, RT (HYDRANT)
SEE SHEET 55

DURABLE & TEMPORARY 24 INCH STOP BAR
STA. 33+08, LT (COLLEGE ROAD TH-9)


DURABLE & TEMPORARY LETTER OR SYMBOL
STA. 33+08, LT "STOP" (COLLEGE ROAD TH-9)

DURABLE CROSSWALK MARKING, TYPE A TAPE
STA. 32+81, LT - RT
SEE SHEET 55 (TYP.)

TEMPORARY CROSSWALK MARKING, PAINT
STA. 32+81, LT - RT
SEE SHEET 55 (TYP.)

REMOVING SIGNS
AS SHOWN - 11

ERECTING SALVAGED SIGNS
AS SHOWN - 1

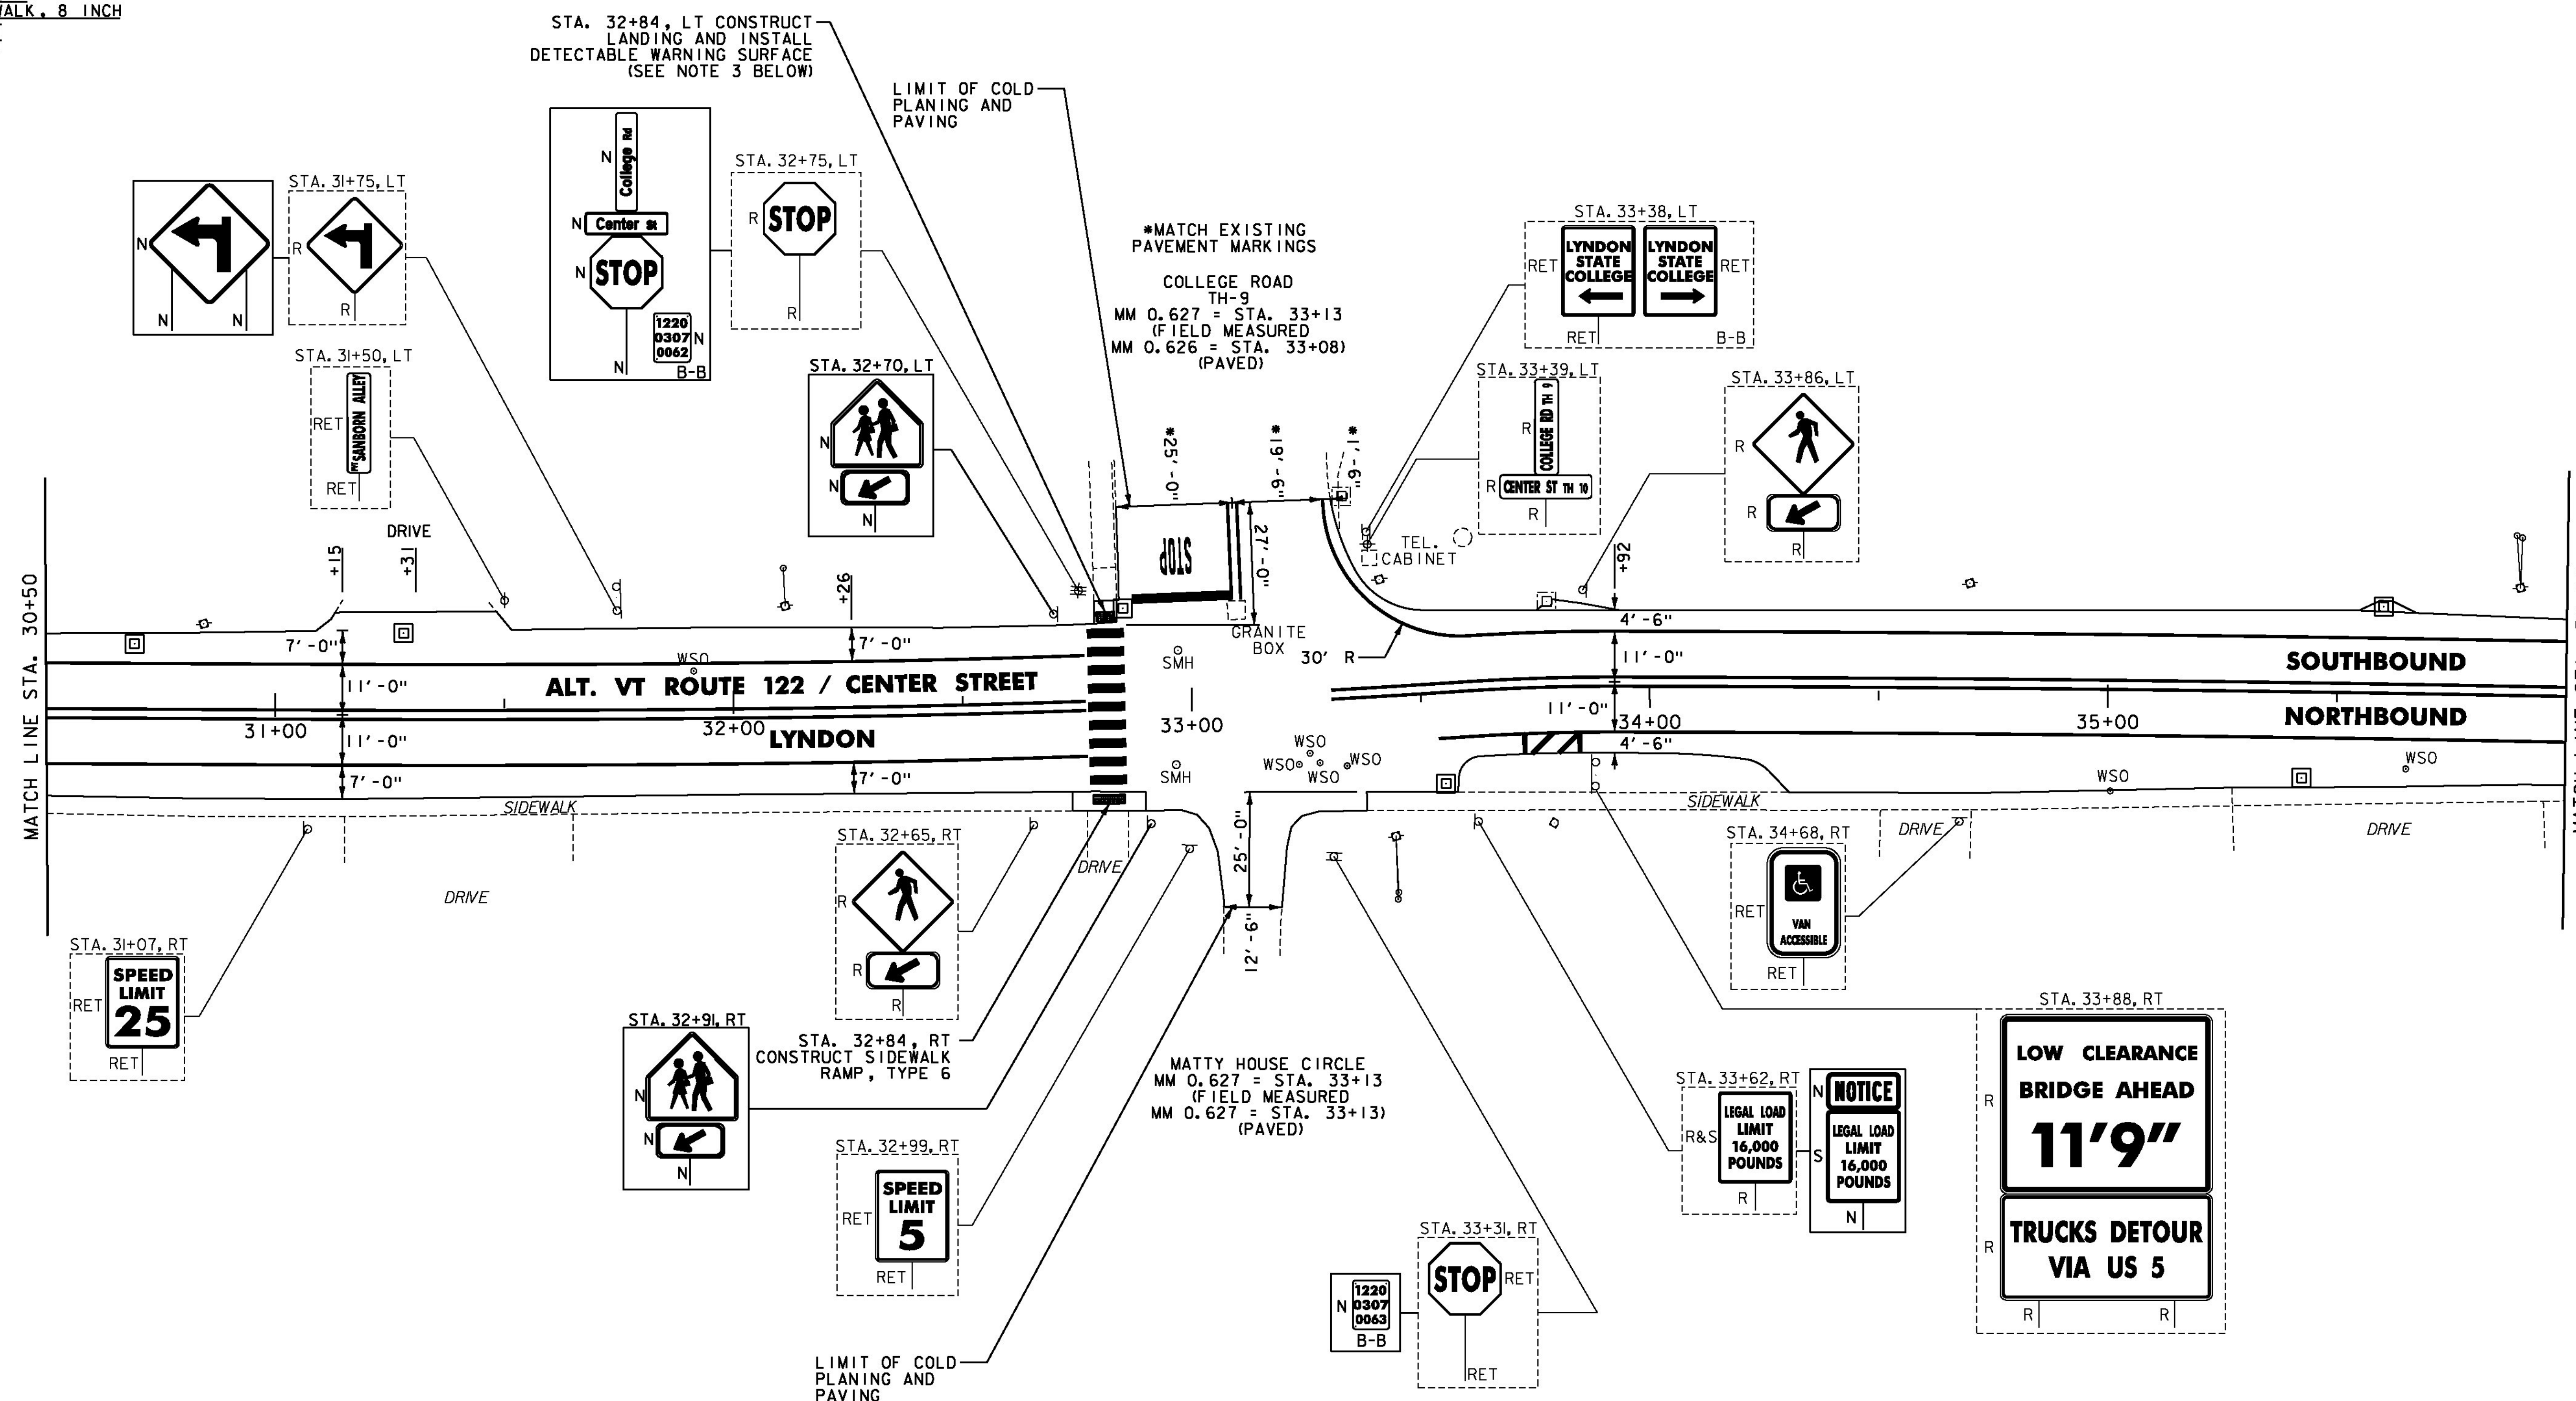

- NOTES:
- FOR LEGENDS, SEE SHEET 3.
 - ALL EXISTING SIGNS NOT SHOWN ON THE PLANS SHALL BE RETAINED.
 - THE SIDEWALK "LANDINGS" NOTED CONSIST OF THE REMOVAL AND REPLACEMENT OF A SINGLE SLAB OF CONCRETE SIDEWALK IN ORDER TO INSTALL A NEW DETECTABLE WARNING SURFACE. SEE SHEETS 12-25.

NOT TO SCALE

PROJECT LAYOUT SHEET #70



PROJECT NAME: ST JOHNSBURY - LYNDON
PROJECT NUMBER: STP 2936(I)

FILE NAME: pllc308.dgn
PROJECT LEADER: G. EDWARDS
DESIGNED BY: D. DRAPER

PLOT DATE: 5/5/2014
DRAWN BY: D. DRAPER
CHECKED BY: J. LITTLE
SHEET 137 OF 250