



VDI-1a

LOCATION: LYNDON, U.S. ROUTE 5
STA. 188+07, RT
COLOR: WHITE BORDER, ARROW AND TEXT (RETROREFLECTIVE)
GREEN BACKGROUND (RETROREFLECTIVE)
MATERIAL: 0.125" FLAT SHEET ALUMINUM
* FOR ARROW DETAIL SEE SHEET 238

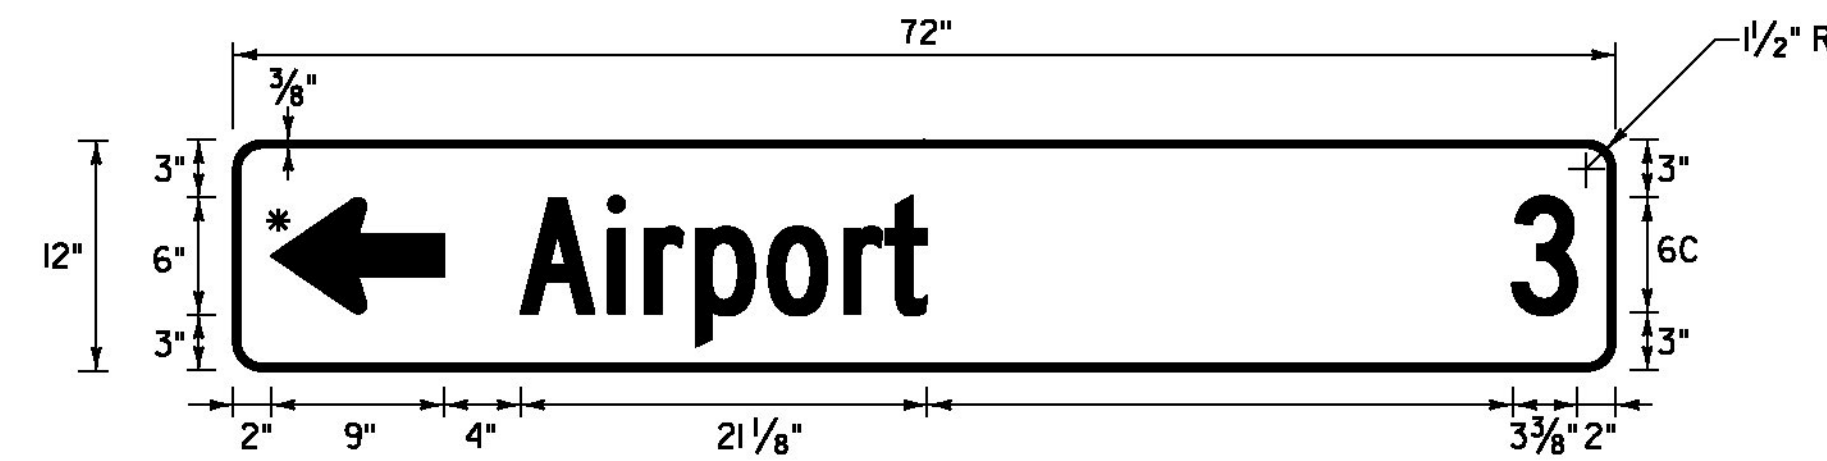


VDI-1a

LOCATION: LYNDON, ALT. VT ROUTE 122
STA. 53+00, RT
COLOR: WHITE BORDER, ARROW AND TEXT (RETROREFLECTIVE)
GREEN BACKGROUND (RETROREFLECTIVE)
MATERIAL: 0.125" FLAT SHEET ALUMINUM
* FOR ARROW DETAIL SEE SHEET 238

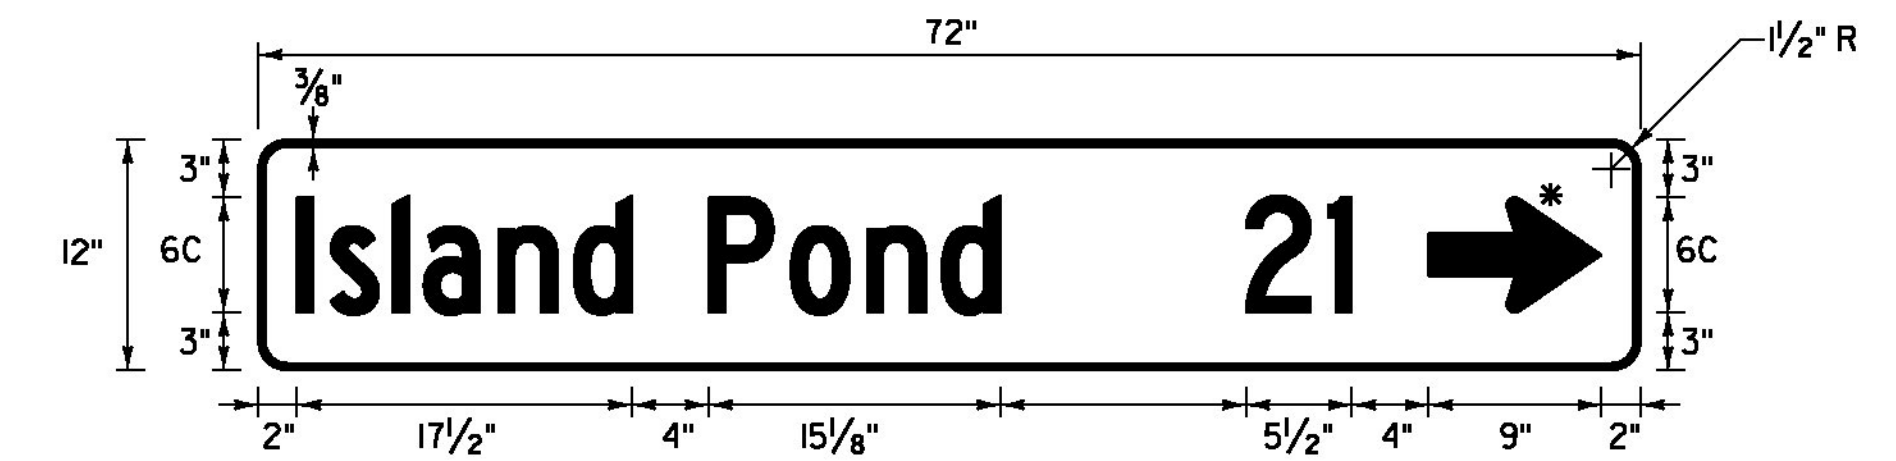


VDI-1a

LOCATION: LYNDON, ALT. VT ROUTE 122
STA. 53+00, RT
COLOR: WHITE BORDER, ARROW AND TEXT (RETROREFLECTIVE)
GREEN BACKGROUND (RETROREFLECTIVE)
MATERIAL: 0.125" FLAT SHEET ALUMINUM
* FOR ARROW DETAIL SEE SHEET 238

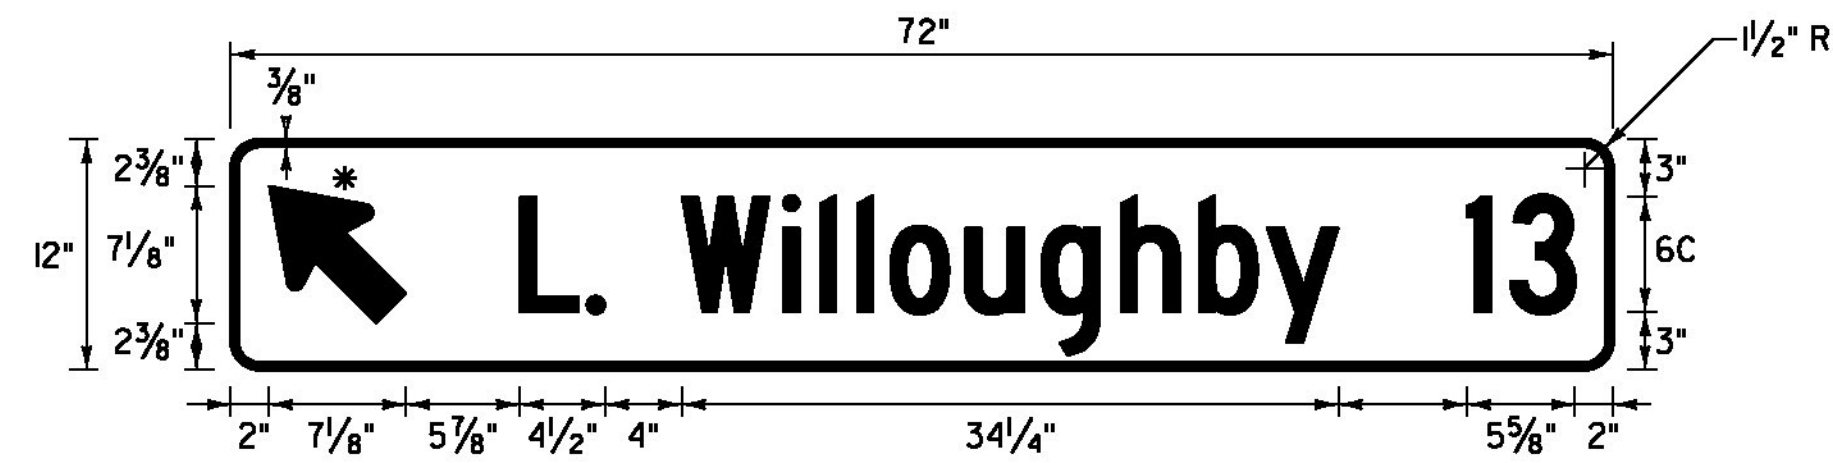


VDI-1a

LOCATION: LYNDON, U.S. ROUTE 5
STA. 188+07, RT
COLOR: WHITE BORDER, ARROW AND TEXT (RETROREFLECTIVE)
GREEN BACKGROUND (RETROREFLECTIVE)
MATERIAL: 0.125" FLAT SHEET ALUMINUM
* FOR ARROW DETAIL SEE SHEET 238

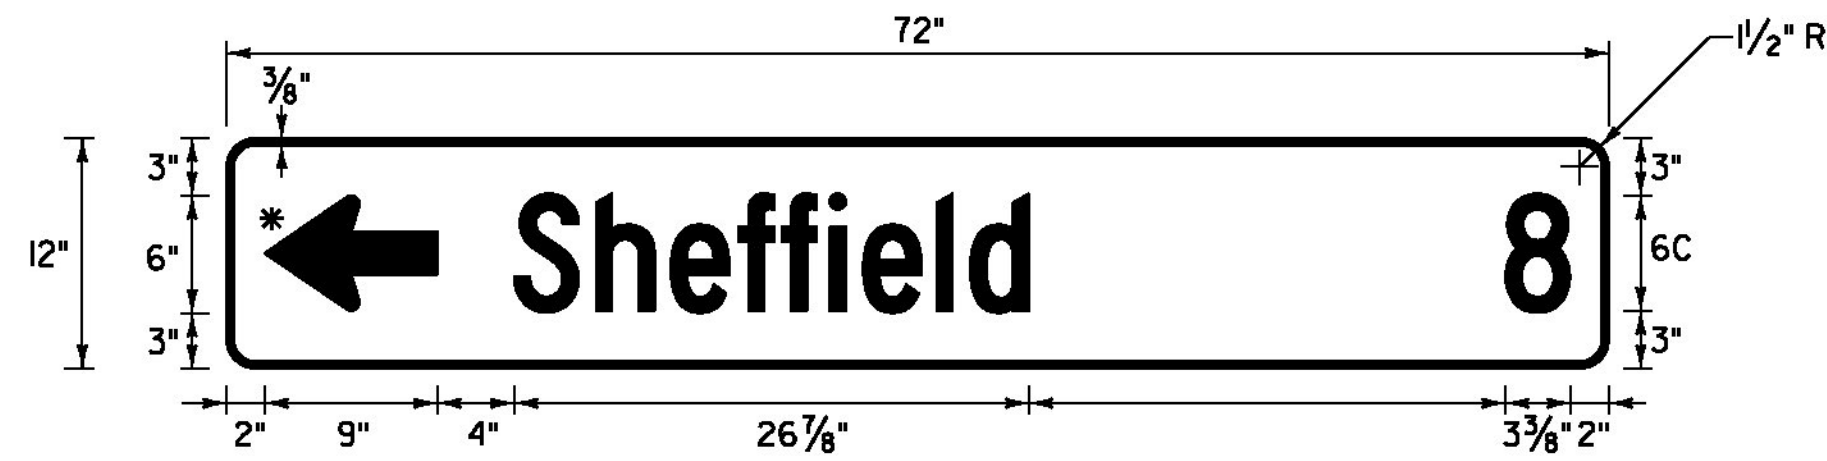


VDI-1a

LOCATION: LYNDON, U.S. ROUTE 5
STA. 188+07, RT
LYNDON, ALT. VT ROUTE 122
STA. 53+00, RT
COLOR: WHITE BORDER, ARROW AND TEXT (RETROREFLECTIVE)
GREEN BACKGROUND (RETROREFLECTIVE)
MATERIAL: 0.125" FLAT SHEET ALUMINUM
* FOR ARROW DETAIL SEE SHEET 238

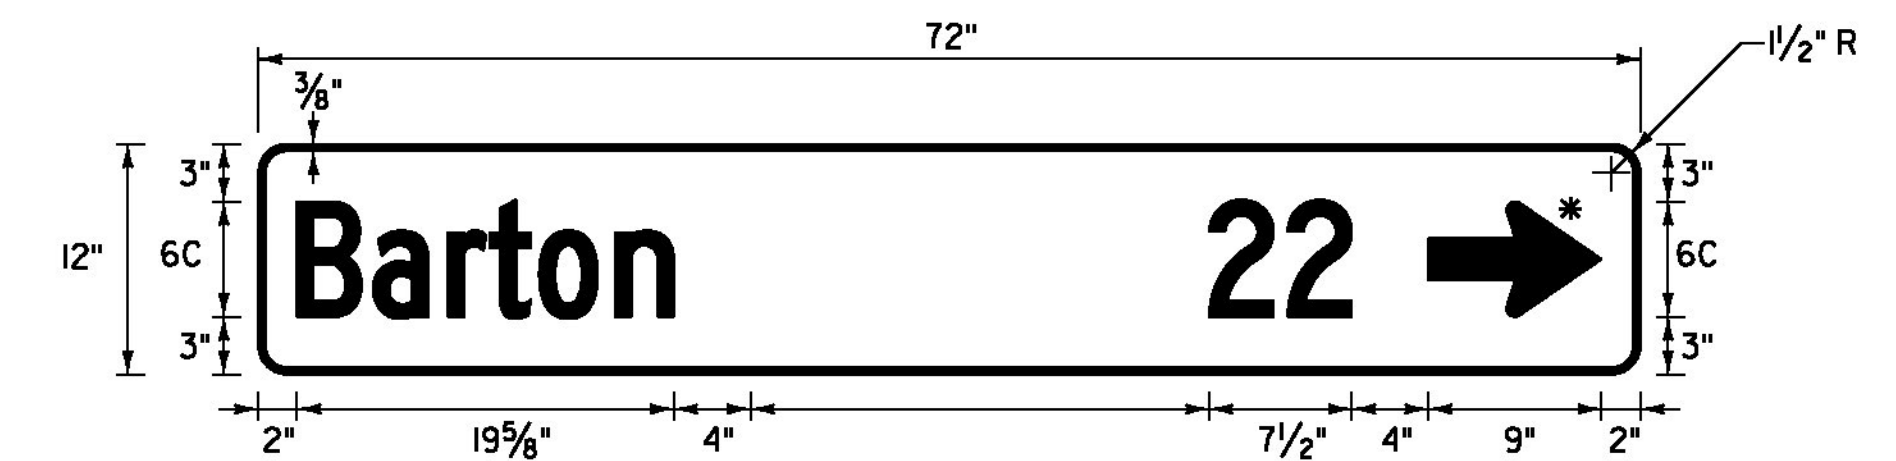


VDI-1a

LOCATION: LYNDON, ALT. VT ROUTE 122
STA. 53+00, RT
COLOR: WHITE BORDER, ARROW AND TEXT (RETROREFLECTIVE)
GREEN BACKGROUND (RETROREFLECTIVE)
MATERIAL: 0.125" FLAT SHEET ALUMINUM
* FOR ARROW DETAIL SEE SHEET 238

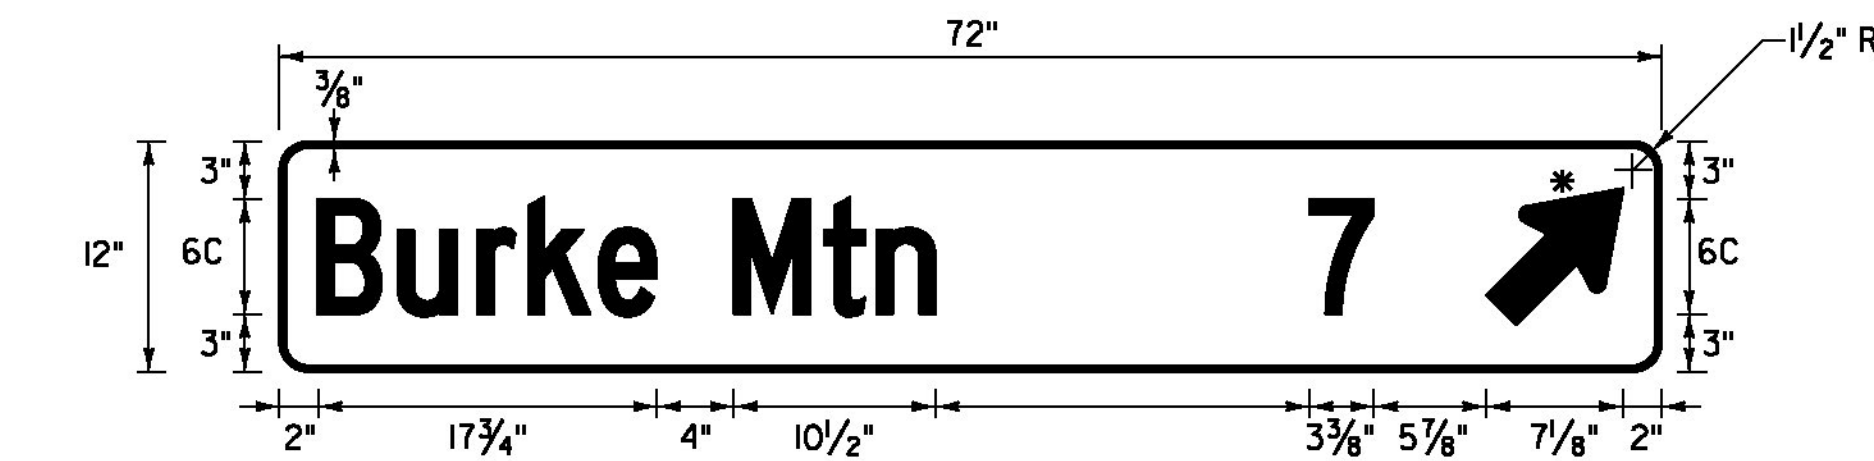


VDI-1a

LOCATION: LYNDON, U.S. ROUTE 5
STA. 188+07, RT
COLOR: WHITE BORDER, ARROW AND TEXT (RETROREFLECTIVE)
GREEN BACKGROUND (RETROREFLECTIVE)
MATERIAL: 0.125" FLAT SHEET ALUMINUM
* FOR ARROW DETAIL SEE SHEET 238

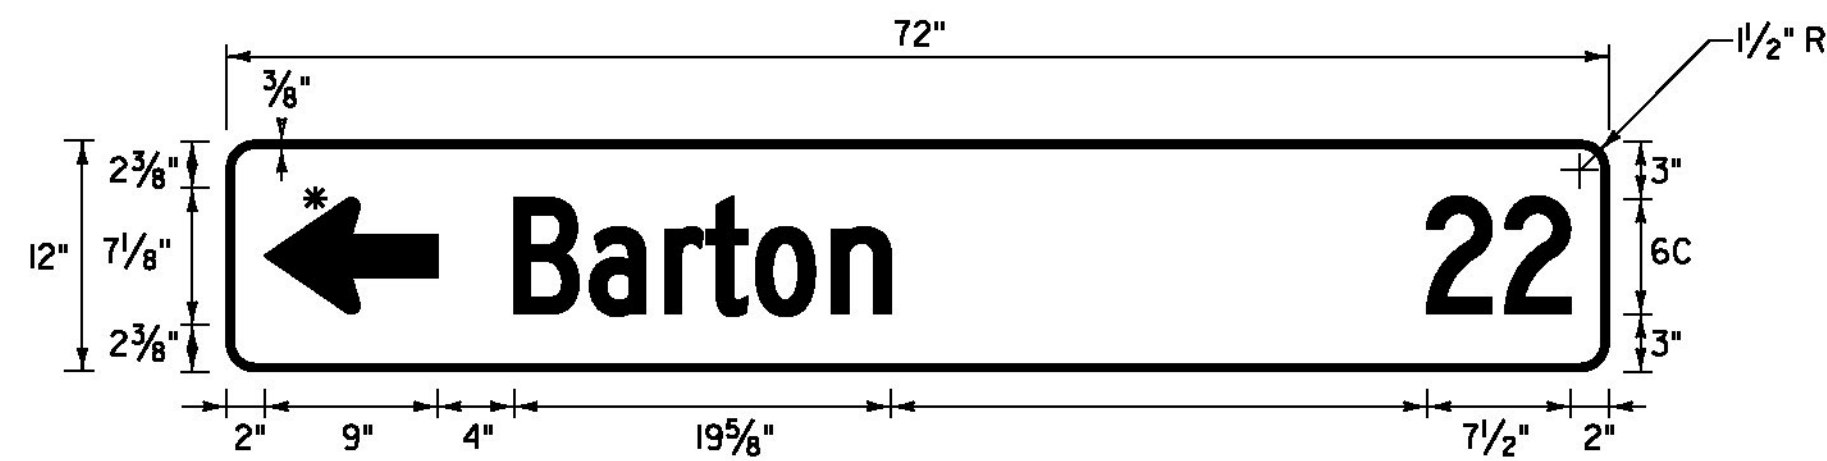


VDI-1a

LOCATION: LYNDON, ALT. VT ROUTE 122
STA. 3+75, LT
COLOR: WHITE BORDER, ARROW AND TEXT (RETROREFLECTIVE)
GREEN BACKGROUND (RETROREFLECTIVE)
MATERIAL: 0.125" FLAT SHEET ALUMINUM
* FOR ARROW DETAIL SEE SHEET 238

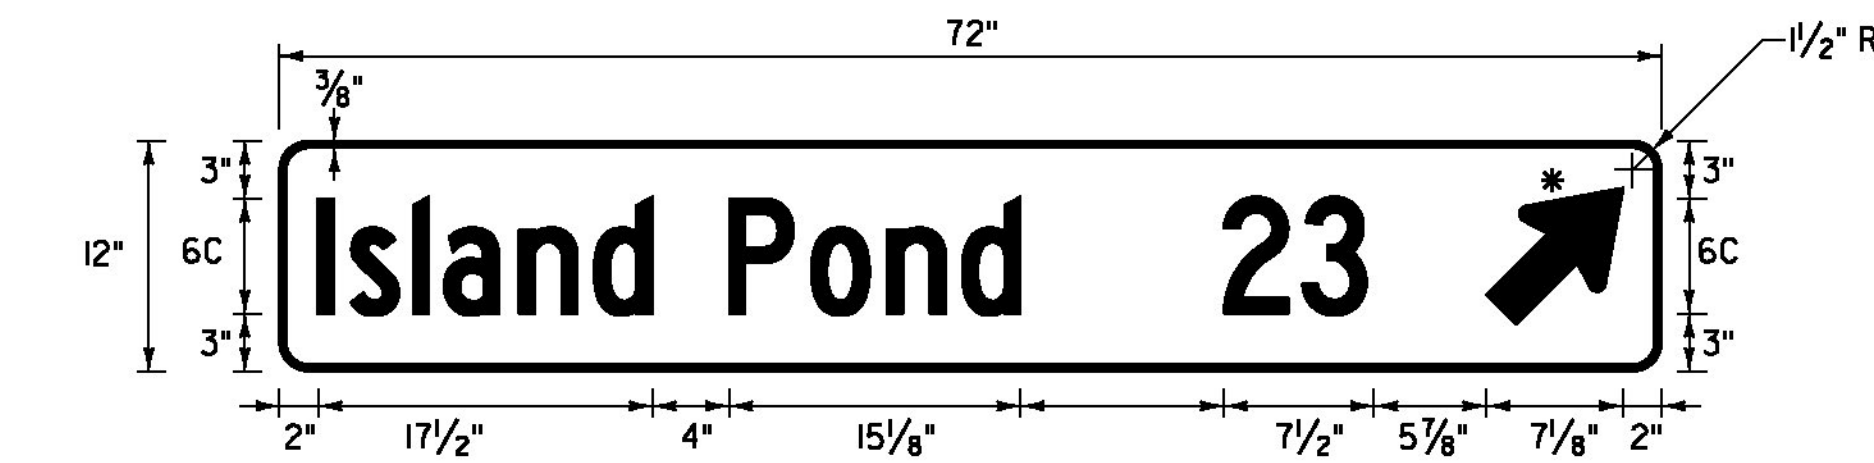

VDI-1a

LOCATION: LYNDON, U.S. ROUTE 5
STA. 188+07, RT
COLOR: WHITE BORDER, ARROW AND TEXT (RETROREFLECTIVE)
GREEN BACKGROUND (RETROREFLECTIVE)
MATERIAL: 0.125" FLAT SHEET ALUMINUM
* FOR ARROW DETAIL SEE SHEET 238

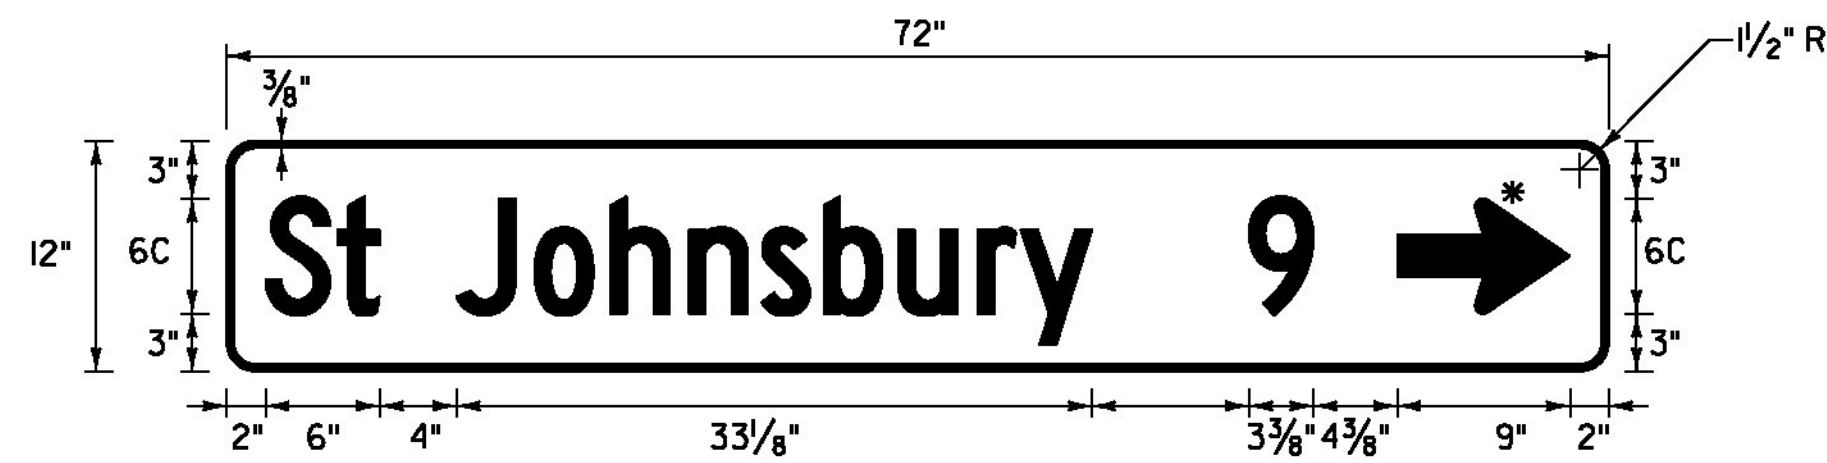

VDI-1a

LOCATION: LYNDON, ALT. VT ROUTE 122
STA. 3+75, LT
COLOR: WHITE BORDER, ARROW AND TEXT (RETROREFLECTIVE)
GREEN BACKGROUND (RETROREFLECTIVE)
MATERIAL: 0.125" FLAT SHEET ALUMINUM
* FOR ARROW DETAIL SEE SHEET 238

NOT TO SCALE

NOTE: SEE TRAFFIC SIGN NOTES ON SHEET 241

**TRAFFIC
SIGN
DETAIL
SHEET #9**

PROJECT NAME: ST JOHNSBURY - LYNDON
PROJECT NUMBER: STP 2936(I)

FILE NAME: pllc308.dgn
PROJECT LEADER: G. EDWARDS
DESIGNED BY: D. DRAPER

PLOT DATE: 5/5/2014
DRAWN BY: D. DRAPER
CHECKED BY: J. LITTLE
SHEET 237 OF 250

