


LYNDON U.S. ROUTE 5 /MAIN STREET INTERSECTION

MAIN ST.
MM 2.998 = STA. 158+29
(FIELD MEASURED)
MM 2.998 = STA. 158+32)
(PAVED)

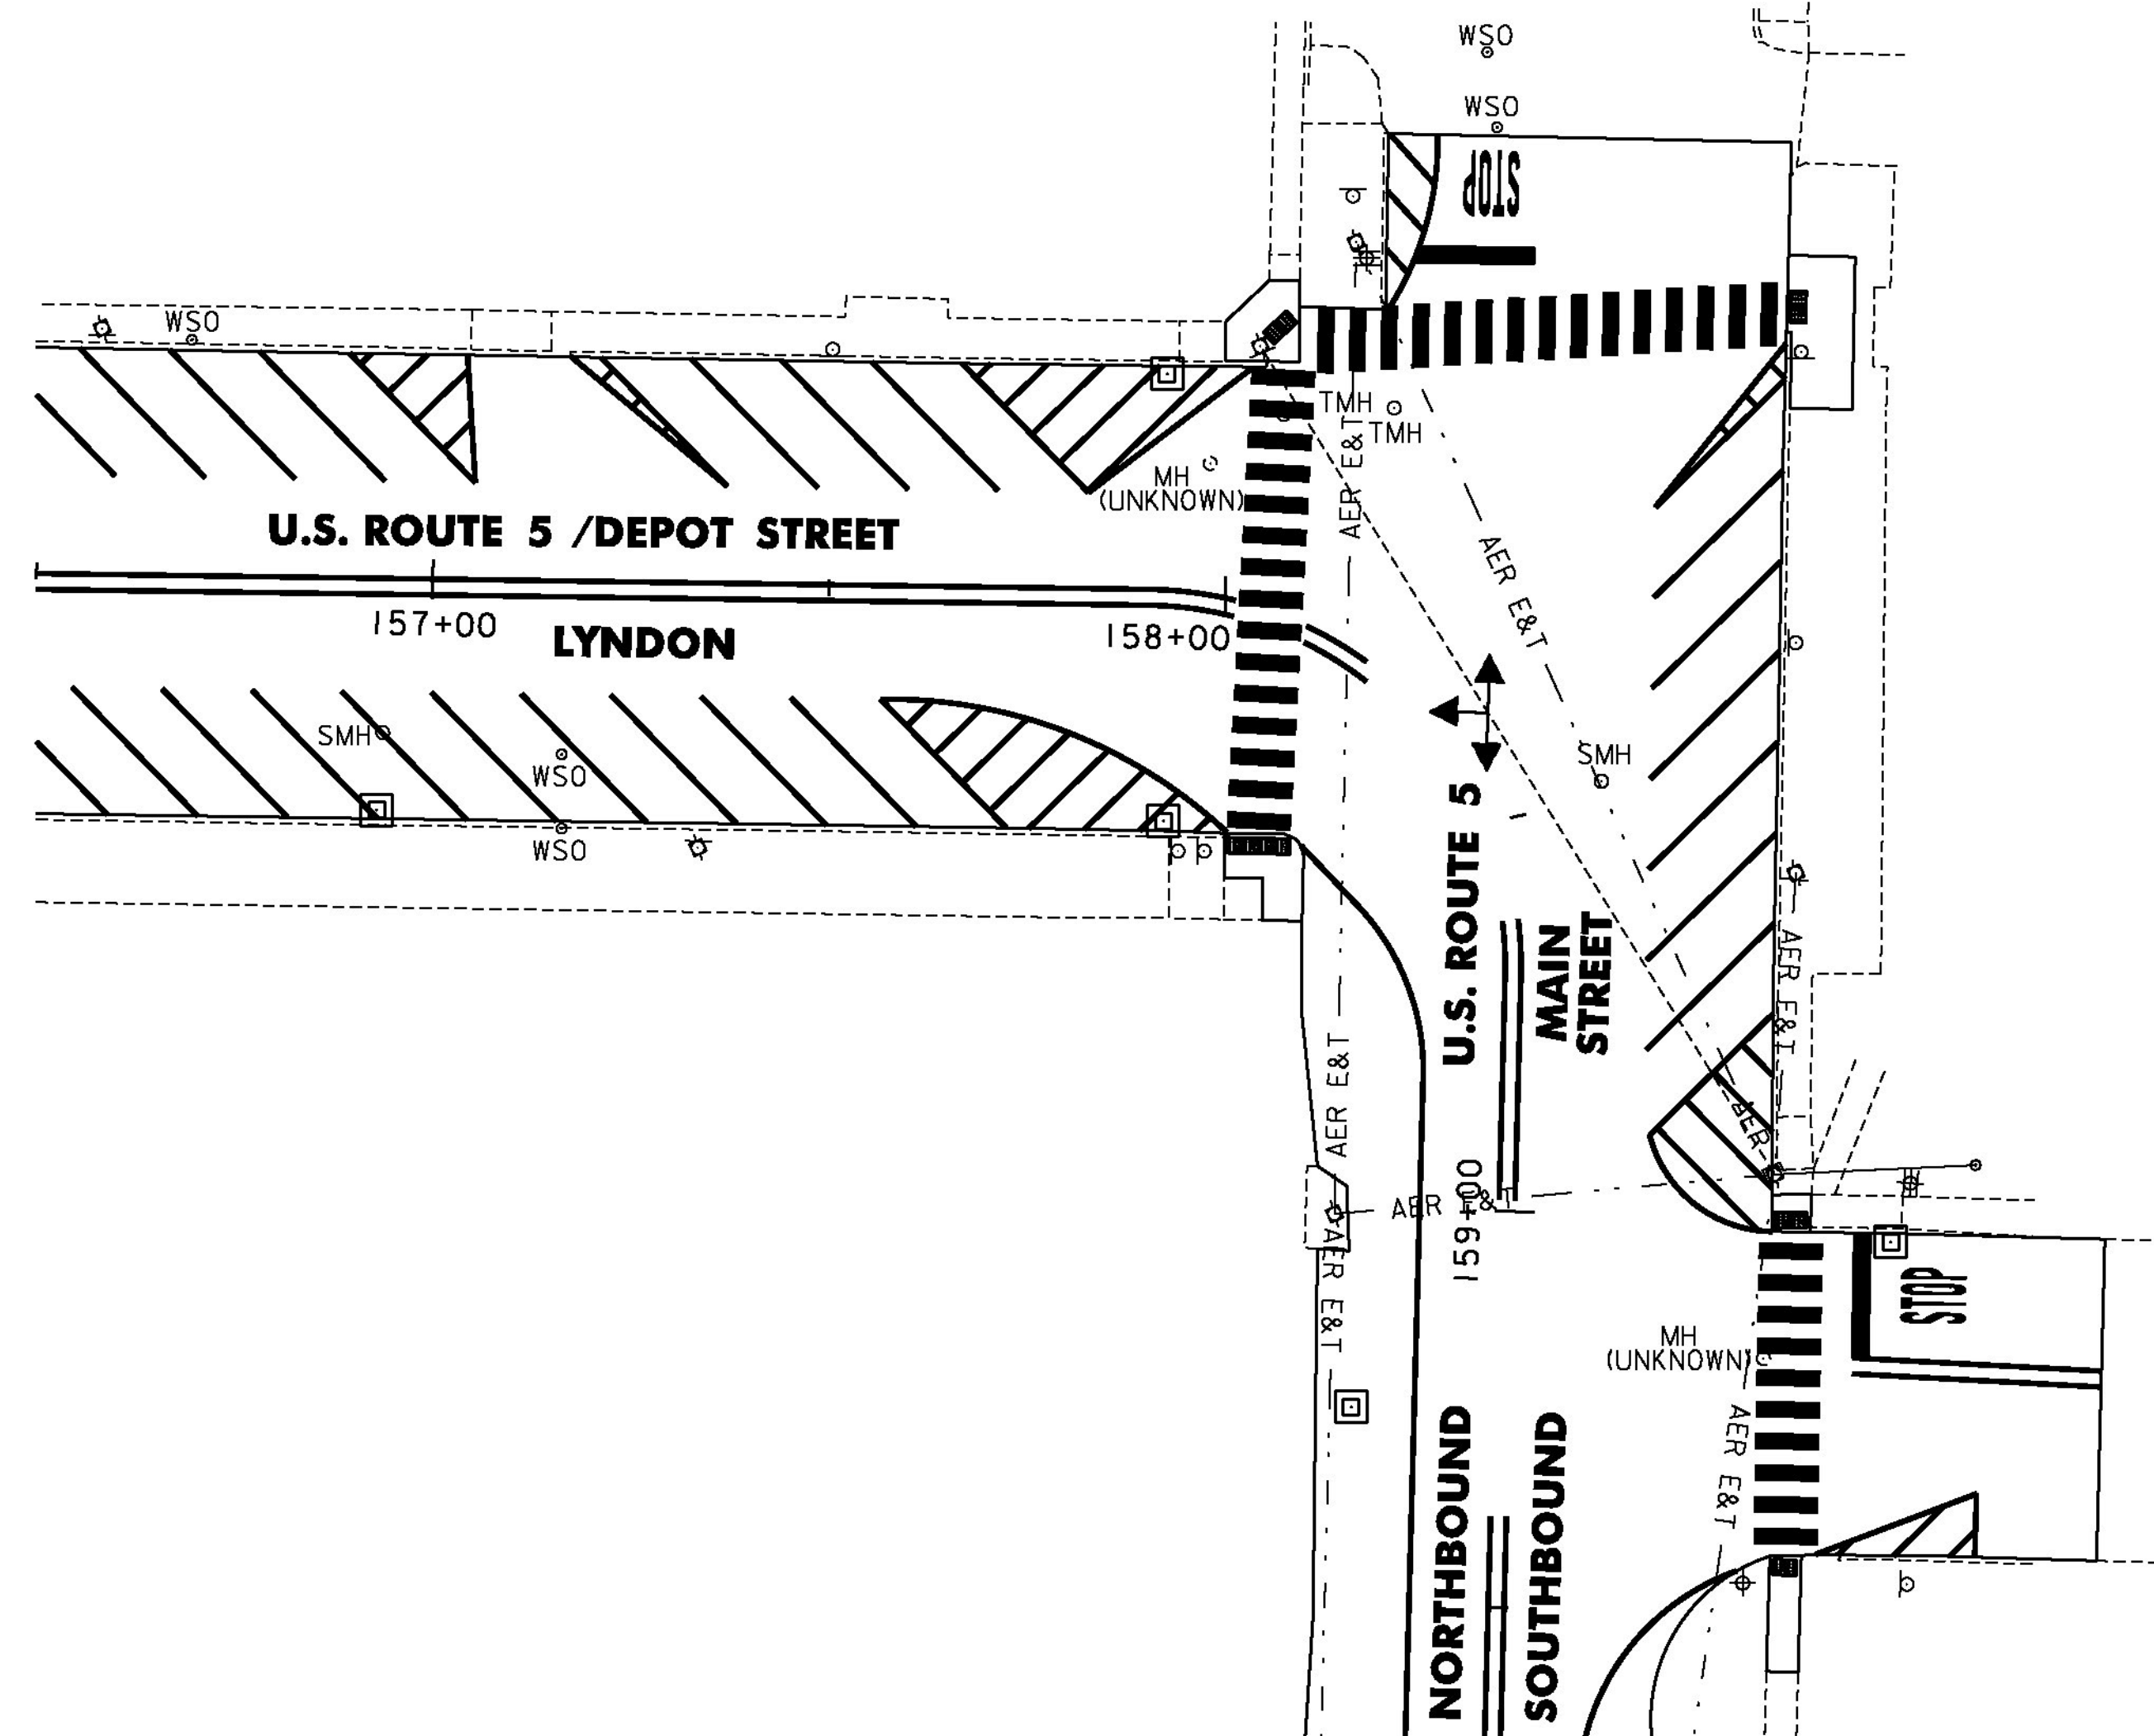

ITEM 900.620 SPECIAL PROVISION (FLASHING BEACON SIGNAL HEADS, LED) (U. S. ROUTE 5 @ MAIN STREET) LYNDON STA. 158+29		
QUANTITY	UNIT	DESCRIPTION
1	EA	FLASHING BEACON SIGNAL HEAD (3 SINGLE SECTIONS WITH MOUNTING HARDWARE)

LEGEND	
DESCRIPTION	
----	EXISTING CONDUIT
□	EXISTING JUNCTION BOX
CT	EXISTING CONTROLLER CABINET
⊕	EXISTING POLE
▭	DETECTION AREA
⊙	PROPOSED STOP BAR DETECTOR
⊙	EXISTING VEHICLE SIGNAL
⊙	PROPOSED VEHICLE SIGNAL
PB	EXISTING PULL BOX
⊙	EXISTING PEDESTRIAN SIGNAL
⊙	PROPOSED COUNT-DOWN PEDESTRIAN SIGNAL

NOTES:

1. THIS PLAN SHEET IS NOT TO SCALE AND SHALL ONLY BE USED AS A GUIDE FOR THE PLACEMENT OF HARDWARE LISTED. THE CONTRACTOR SHALL CONFIRM ALL LOCATIONS IN THE FIELD WITH THE ENGINEER PRIOR TO INSTALLATION. LOCATIONS MAY BE REVISED AS A RESULT OF THE SITE SURVEY.
2. ALL EXISTING FLASHING BEACON SIGNAL HEADS SHALL BE REPLACED WITH NEW SIGNAL HEADS AS SHOWN.
3. UNIFORMED TRAFFIC OFFICERS CAN DIRECT TRAFFIC AND FLAGGERS CAN ONLY STOP AND RELEASE TRAFFIC.
4. EXISTING SIGNAL EQUIPMENT AND MOUNTING HARDWARE WHICH IS REMOVED SHALL BE DELIVERED AS DIRECTED BY THE VILLAGE OF LYNDONVILLE. CONTACT TIM HOOKER, PUBLIC WORKS SUPERVISOR AT 802-535-2936 TO ARRANGE DELIVERY AHEAD OF TIME. THIS IS PAID INCIDENTAL TO OTHER ITEMS OF WORK.

NOT TO SCALE



TRAFFIC SIGNAL SYSTEMS SHEET #4

PROJECT NAME: ST JOHNSBURY - LYNDON
PROJECT NUMBER: STP 2936(I)

FILE NAME: pllc308.dgn
PROJECT LEADER: G. EDWARDS
DESIGNED BY: D. DRAPER

PLOT DATE: 5/5/2014
DRAWN BY: D. DRAPER
CHECKED BY: J. LITTLE
SHEET 245 OF 250