
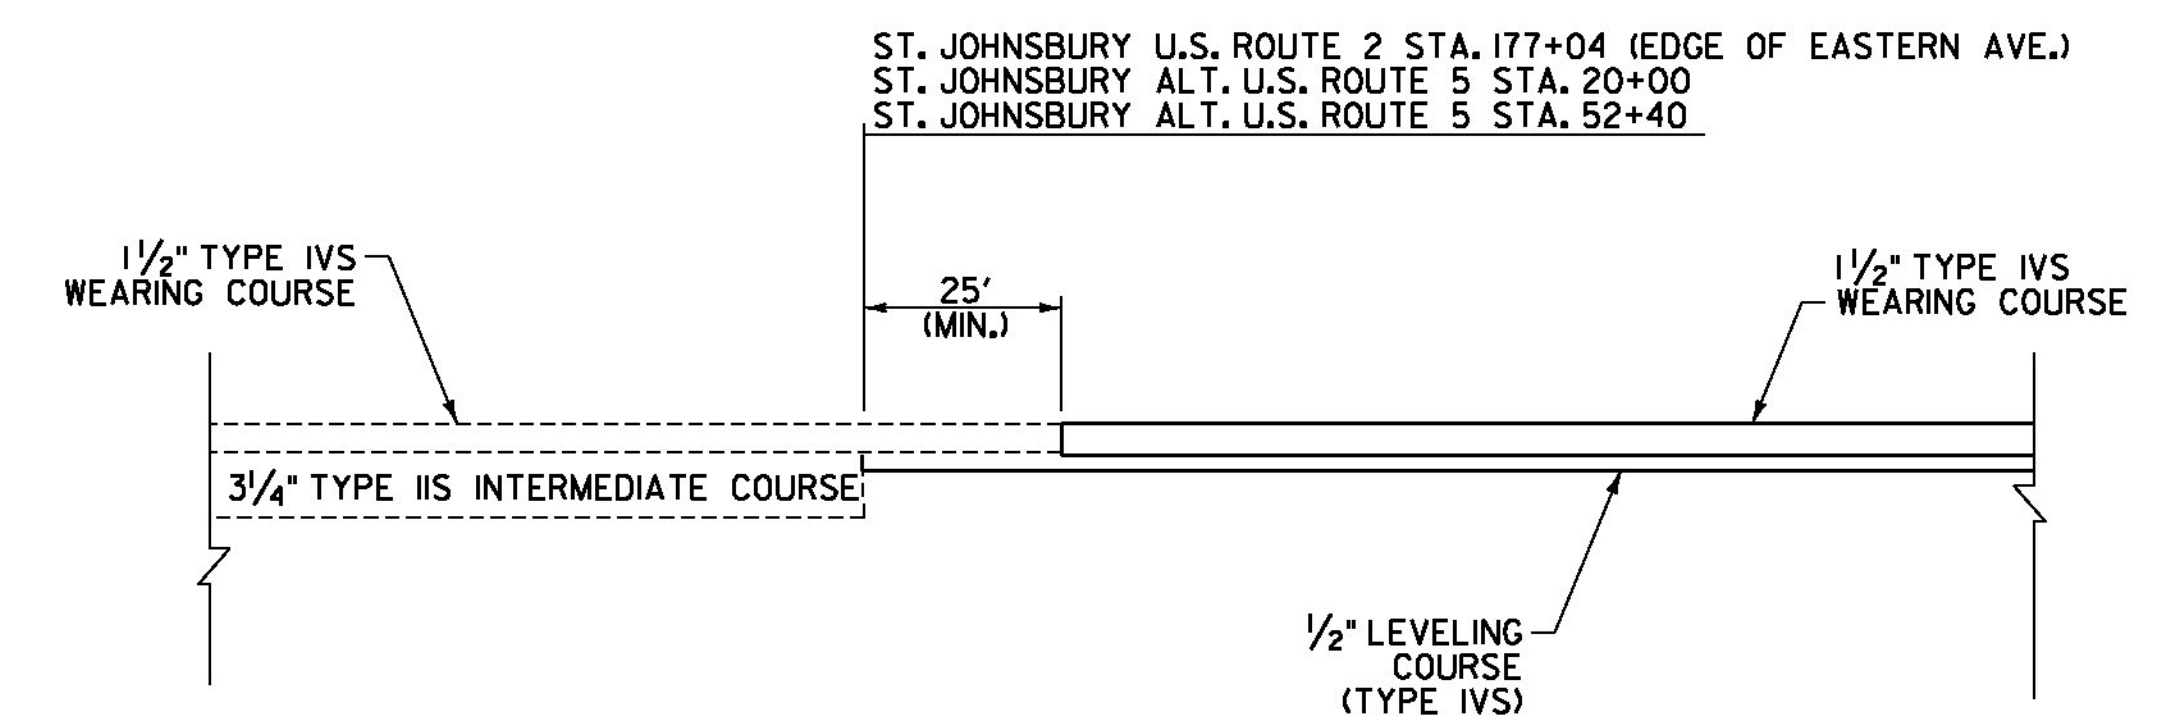
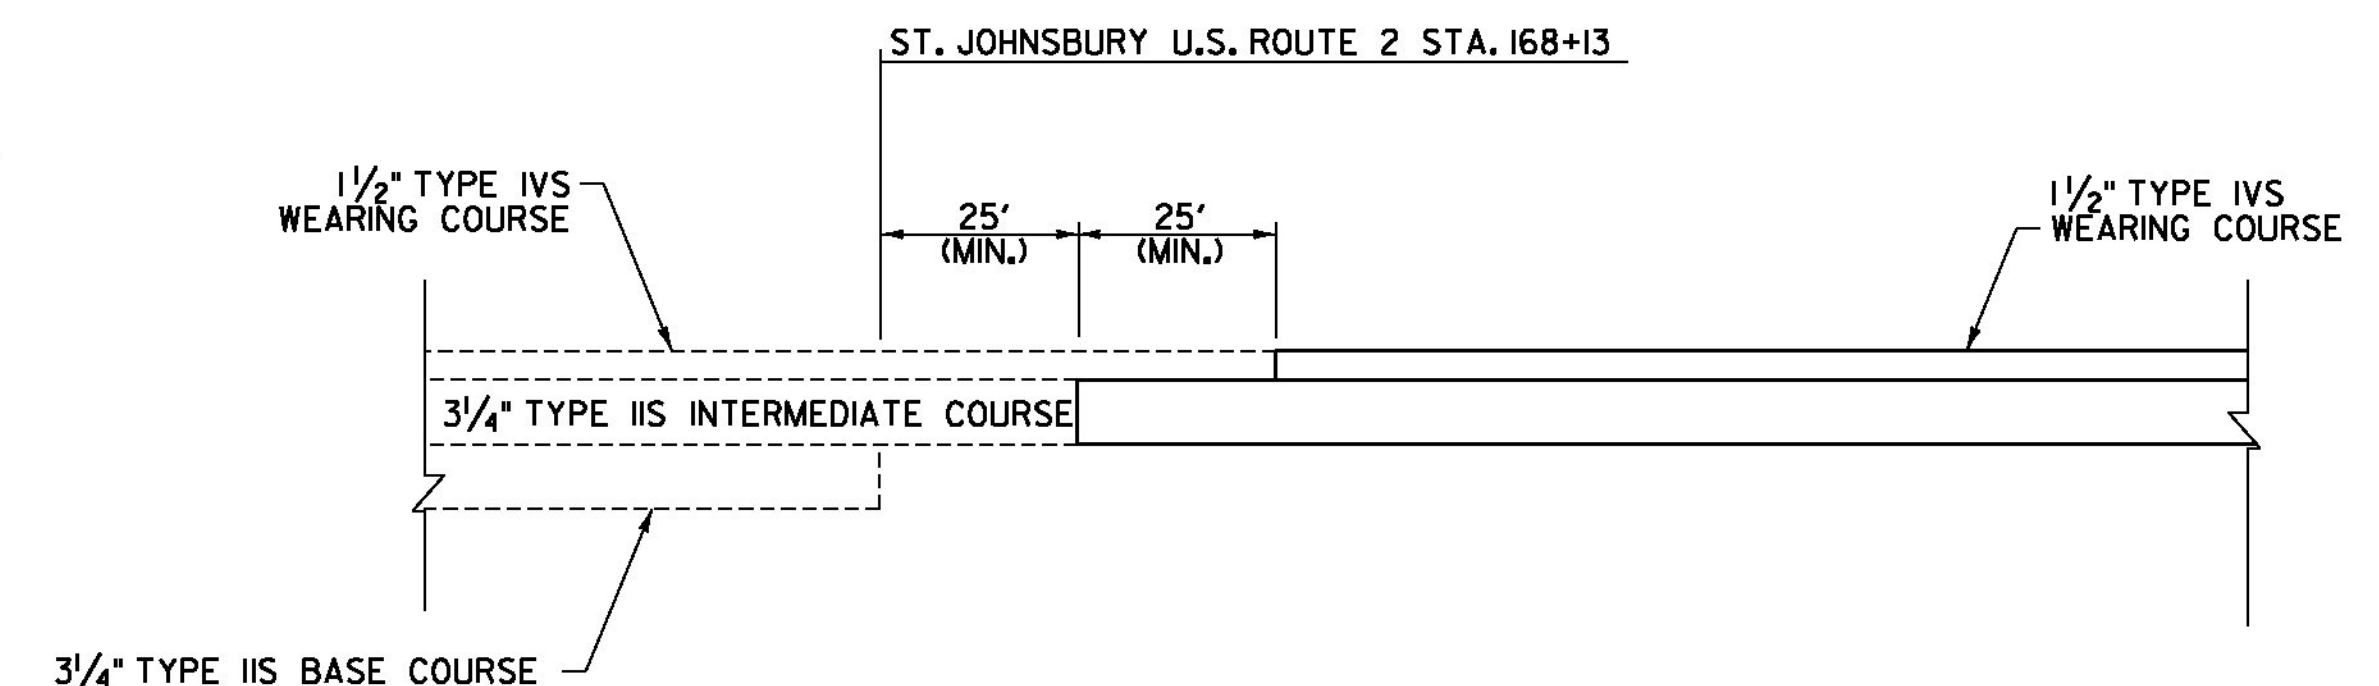
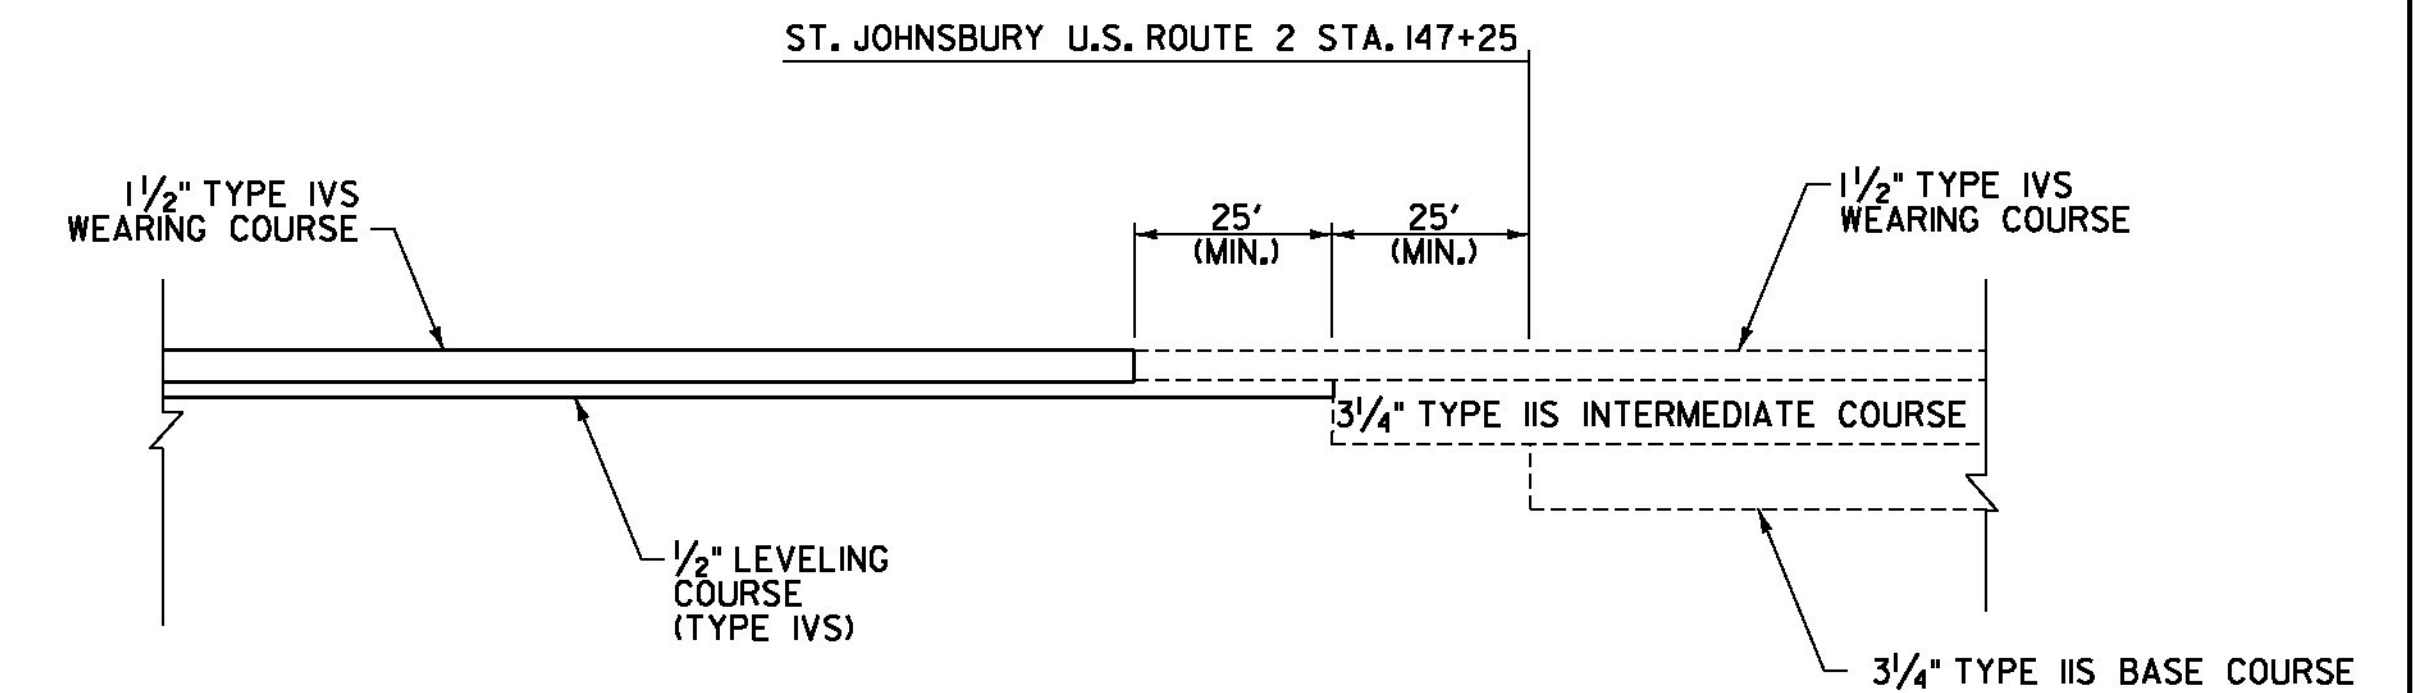
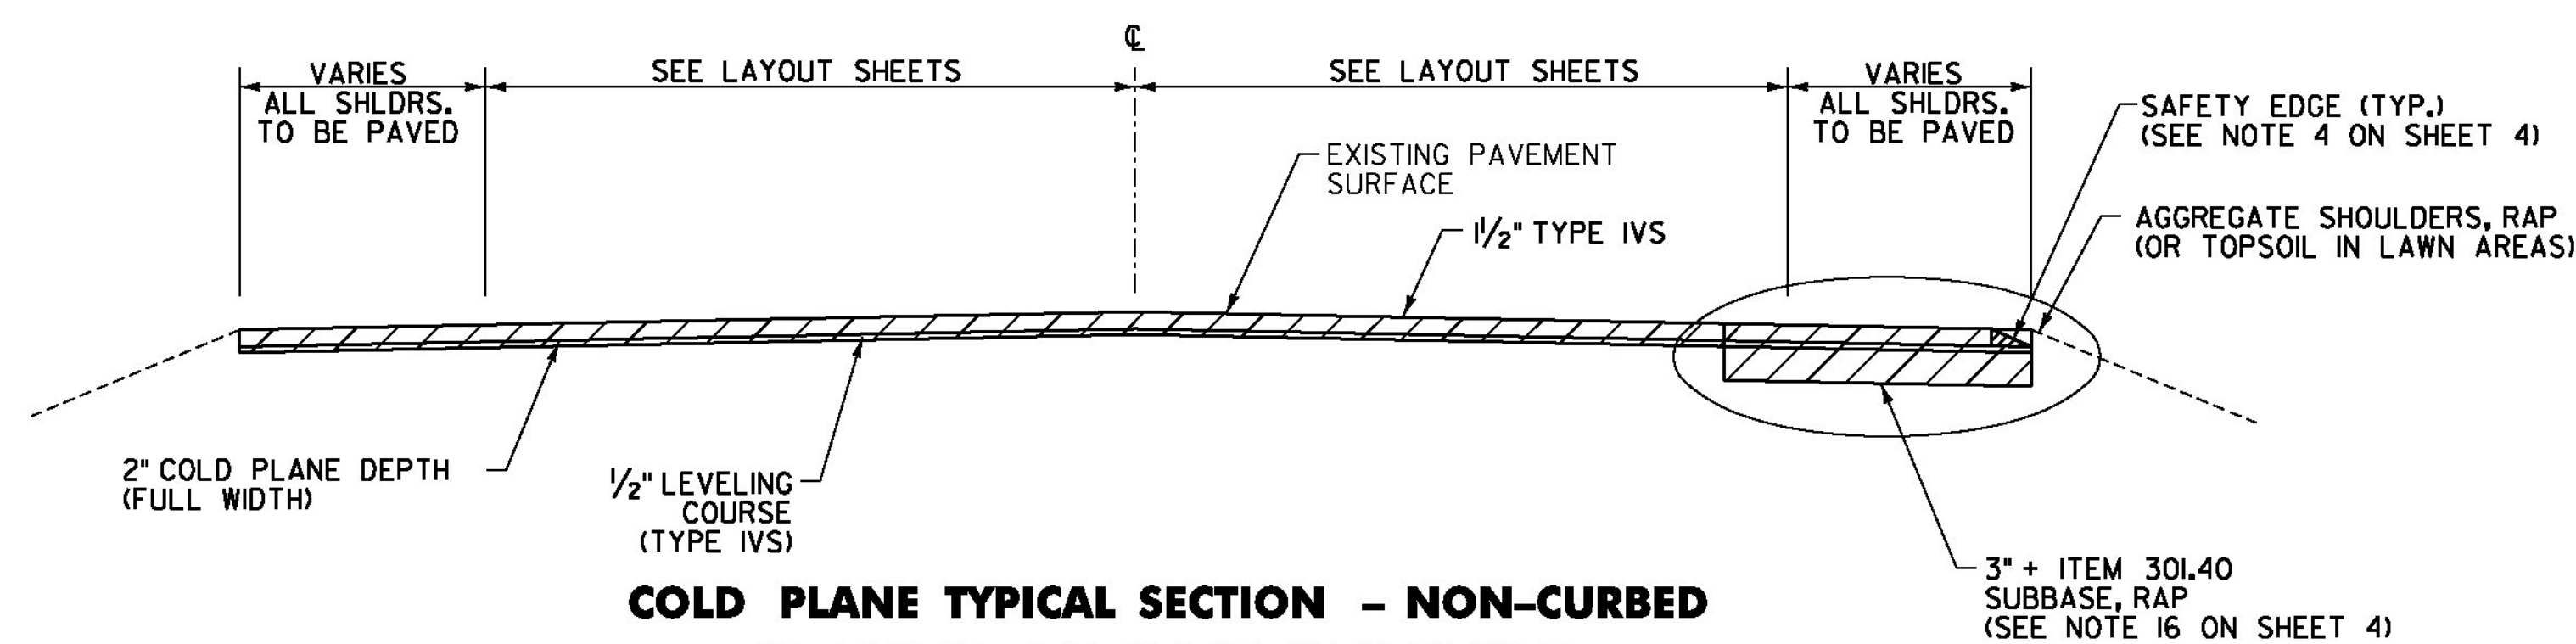
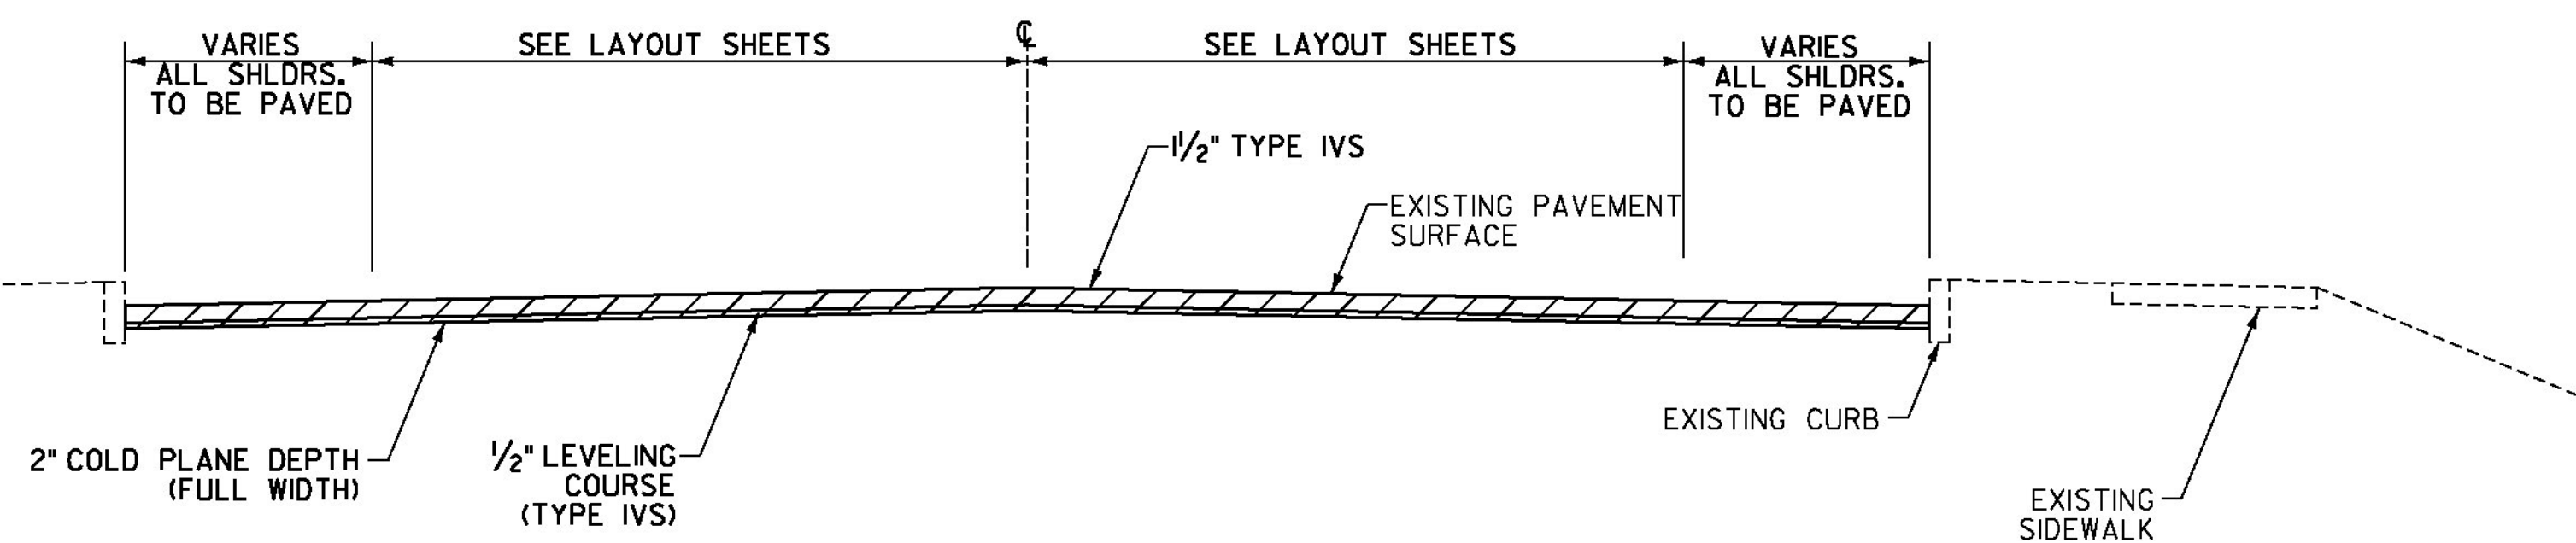
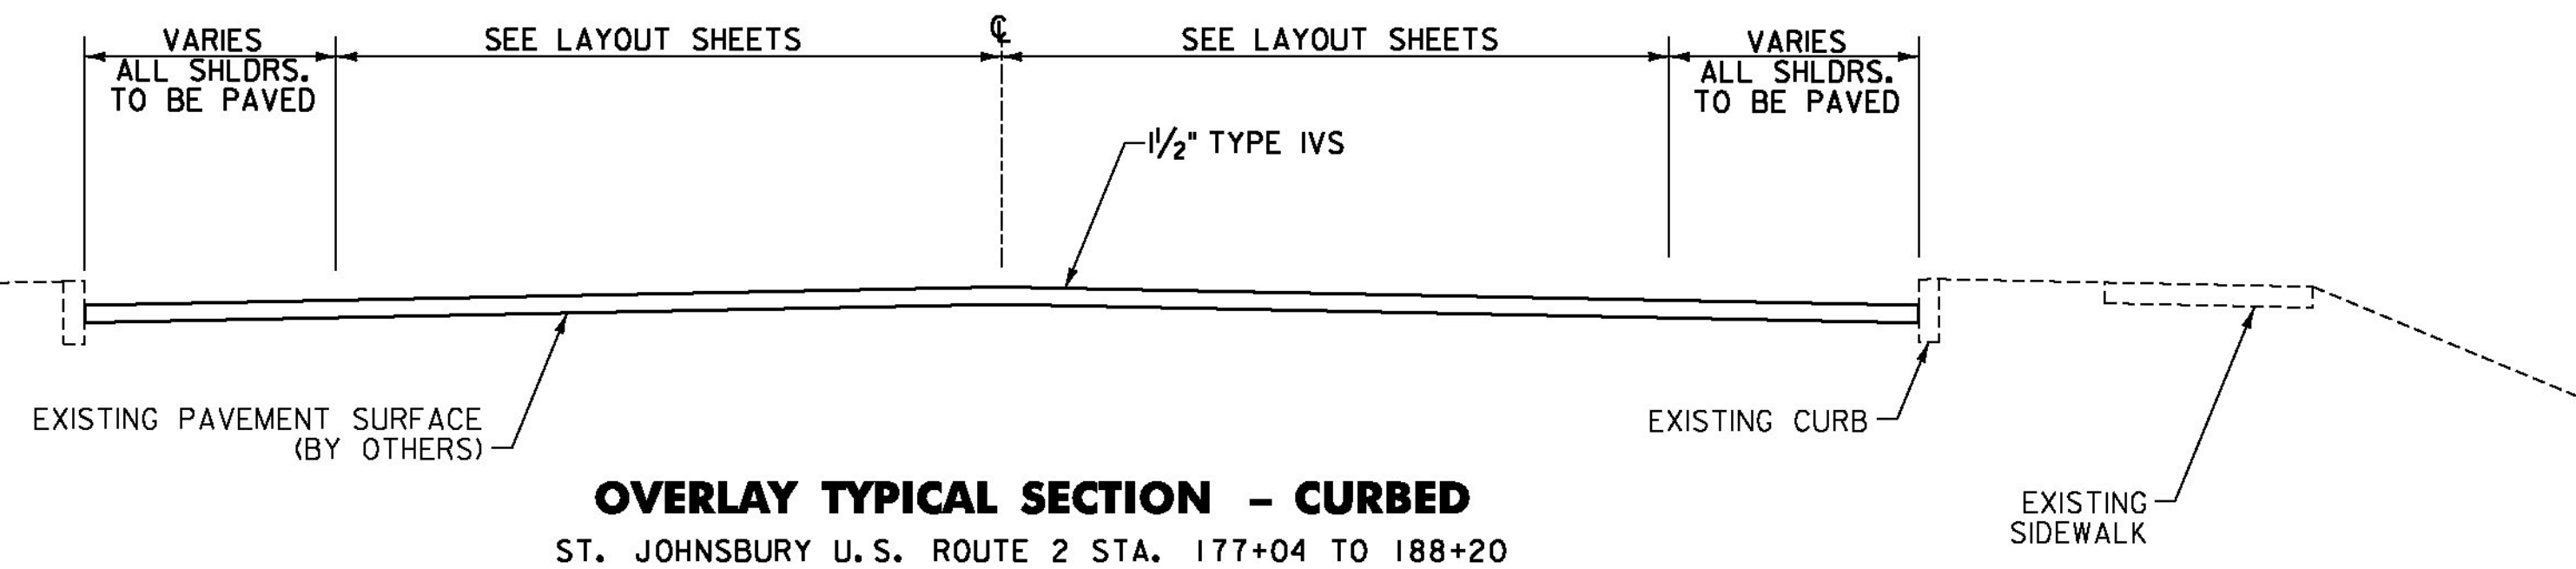


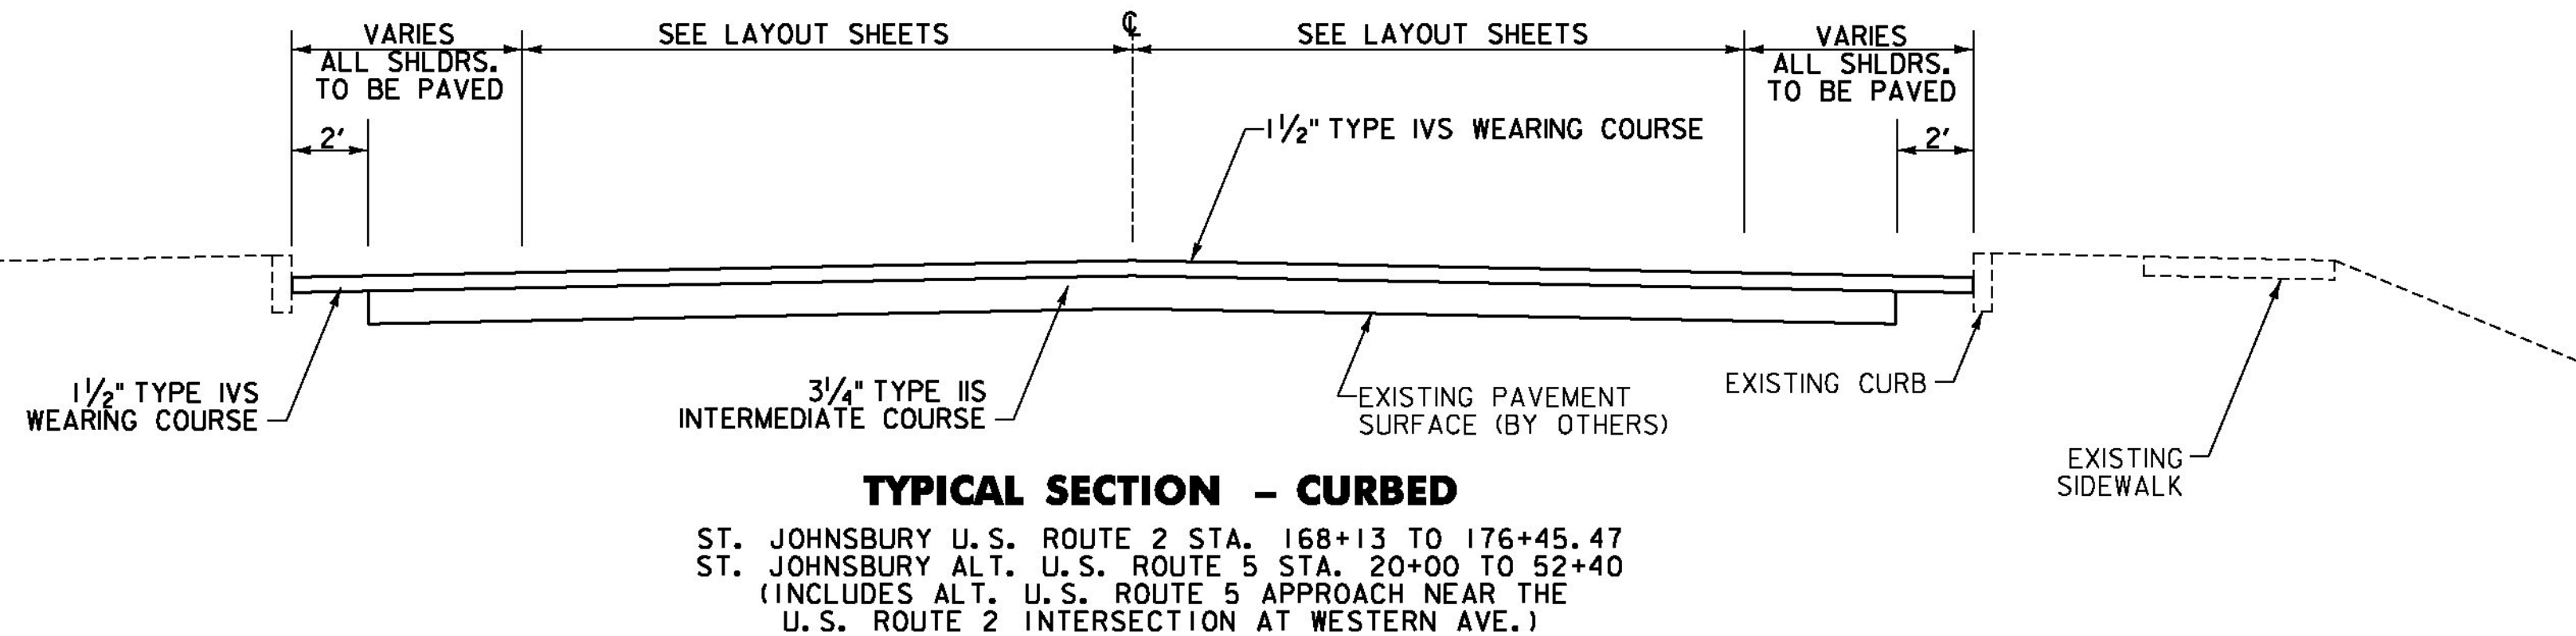

NOT TO SCALE

**PROJECT
TYPICAL
SECTION
SHEET #2**

PROJECT NAME: ST JOHNSBURY - LYNDON
 PROJECT NUMBER: STP 2936(I)
 FILE NAME: pllc308.dgn
 PROJECT LEADER: G. EDWARDS
 DESIGNED BY: D. DRAPER
 PLOT DATE: 5/5/2014
 DRAWN BY: D. DRAPER
 CHECKED BY: J. LITTLE
 SHEET 5 OF 250