


- LEGEND**
- EJT ⊕ EXISTING JOINT
  - IJT ● NEW INSULATED JOINT
  - JT ⊕ NEW JOINT

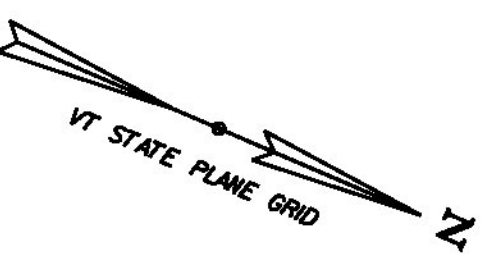

**EXISTING AND PROPOSED RAIL JOINT LAYOUT  
U.S. ROUTE 5 AARDOT #850-919D  
&  
HILL STREET AARDOT #850-918W**

NOT TO SCALE

**RAILROAD  
CROSSING  
DETAIL  
SHEET #16**

**AARDOT #850-919D AND #850-918W**

PROJECT NAME: ST JOHNSBURY - LYNDON	PLOT DATE: 5/5/2014
PROJECT NUMBER: STP 2936(I)	DRAWN BY: D. DRAPER
FILE NAME: pllc308.dgn	CHECKED BY: J. LITTLE
PROJECT LEADER: G. EDWARDS	SHEET 47 OF 250
DESIGNED BY: D. DRAPER	

