

CHANGING ELEVATION OF DIS, CBS OR MHS
SEE SHEET 27

REHAB.
DIS, CBS OR MHS, CLASS I, II OR III
SEE SHEETS 27-28

CHANGING ELEVATION OF SEWER MANHOLES
SEE SHEET 28

PORTLAND CEMENT
CONCRETE SIDEWALK, 5 INCH
STA. 160+45 TO 160+73, RT
STA. 161+08, RT
STA. 161+24 TO 161+84, RT
STA. 163+27, RT
STA. 163+50, RT
STA. 163+88, RT
STA. 163+88, LT

PORTLAND CEMENT
CONCRETE SIDEWALK, 8 INCH
STA. 161+84 TO 162+31, RT

DETECTABLE WARNING SURFACE

STA. 160+88, RT
STA. 161+08, RT
STA. 163+27, RT
STA. 163+50, RT
STA. 163+88, RT
STA. 163+88, LT

VERTICAL GRANITE CURB

STA. 160+64 TO 160+72, RT (BARKER AVE. TH-360)
STA. 160+95 TO 161+24, RT (BARKER AVE. TH-360)

REMOVING AND RESETTNG CURB

STA. 160+46 TO 160+73, RT
STA. 161+24 TO 161+91, RT
STA. 163+85 TO 163+90, LT

ADJUST ELEVATION OF VALVE BOX
SEE SHEETS 28-29

DURABLE & TEMPORARY 4 INCH WHITE LINE
(ALL LINES WILL INCLUDE EDGE LINE BREAKS
AND RADII FOR SIDE ROADS)
STA. 160+00 TO 165+00, SOLID LT & RT
STA. 161+02 TO 162+75, SOLID LT (LANE LINE)
STA. 162+75 TO 164+00, DOTTED LT

DURABLE & TEMPORARY 4 INCH YELLOW LINE
(ALL LINES WILL INCLUDE E BREAKS FOR
SIDE ROADS & CROSSWALKS)
STA. 160+00 TO 160+77, DOUBLE SOLID LT & RT
STA. 160+87, DOUBLE SOLID RT (BARKER AVE. TH-360)
STA. 161+20 TO 165+00, SOLID LT & RT
STA. 161+81, DOUBLE SOLID LT (TOWN GARAGE)

DURABLE & TEMPORARY 8 INCH YELLOW LINE
STA. 160+00 TO 160+70, LT & RT (DIAGONALS)
SEE SHEET 55

DURABLE & TEMPORARY 24 INCH STOP BAR
STA. 160+87, RT (BARKER AVE. TH-360)
STA. 161+81, LT (TOWN GARAGE)
STA. 163+39, RT (BELVIDERE ST. TH-362)


DURABLE LETTER OR SYMBOL, TYPE D TAPE
STA. 160+87, RT "STOP" (BARKER AVE. TH-360)
STA. 161+25, LT ARROW
STA. 161+81, LT "STOP" (TOWN GARAGE)
STA. 161+98, LT "ONLY"
STA. 162+71, LT ARROW
STA. 163+39, RT "STOP" (BELVIDERE ST. TH-362)

DURABLE CROSSWALK MARKING, TYPE A TAPE
STA. 160+87, RT (BARKER AVE. TH-360)
STA. 163+39, RT (BELVIDERE ST. TH-362)
STA. 163+88, LT - RT
SEE SHEET 55 (TYP.)

TEMPORARY LETTER OR SYMBOL, PAINT
STA. 160+87, RT "STOP" (BARKER AVE. TH-360)
STA. 161+25, LT ARROW
STA. 161+81, LT "STOP" (TOWN GARAGE)
STA. 162+71, LT ARROW
STA. 163+39, RT "STOP" (BELVIDERE ST. TH-362)

TEMPORARY CROSSWALK MARKING, PAINT
STA. 160+87, RT (BARKER AVE. TH-360)
STA. 163+39, RT (BELVIDERE ST. TH-362)
STA. 163+88, LT - RT
SEE SHEET 55 (TYP.)

REMOVING SIGNS
AS SHOWN - 25

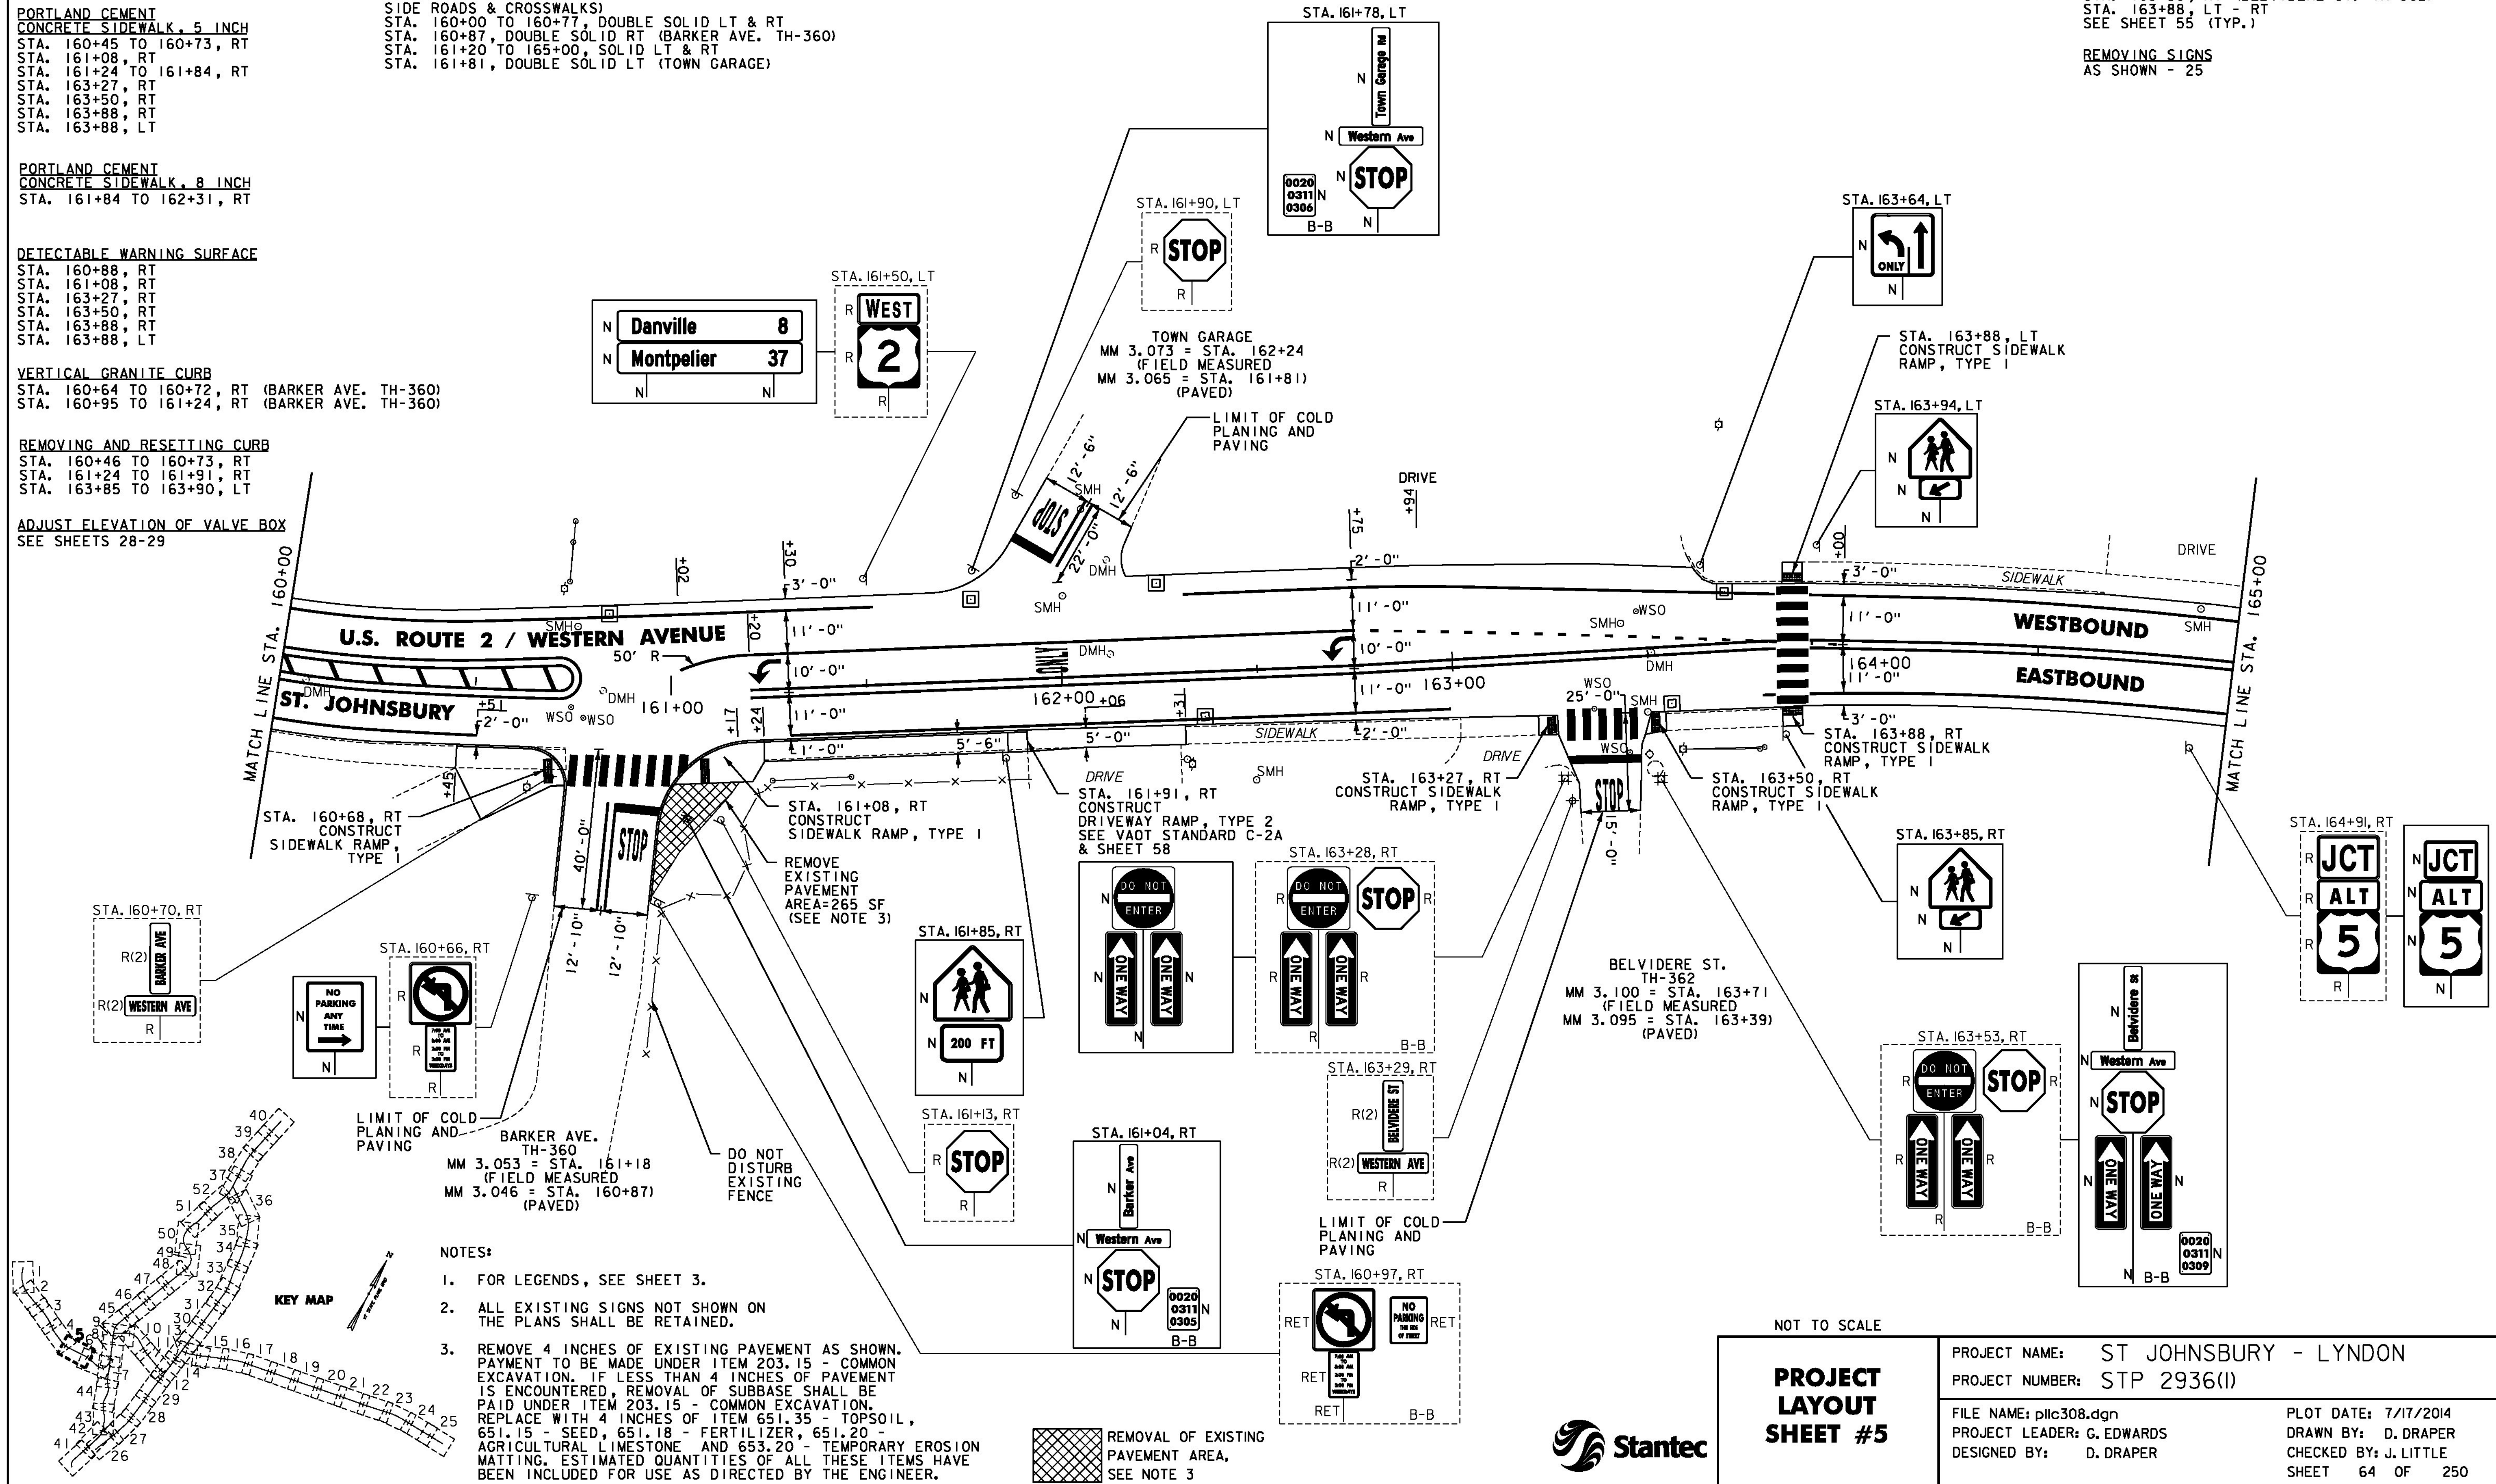

NOT TO SCALE

PROJECT
LAYOUT
SHEET #5

PROJECT NAME: ST JOHNSBERRY - LYNDON
PROJECT NUMBER: STP 2936(1)

FILE NAME: pllc308.dgn
PROJECT LEADER: G. EDWARDS
DESIGNED BY: D. DRAPER

PLOT DATE: 7/17/2014
DRAWN BY: D. DRAPER
CHECKED BY: J. LITTLE
SHEET 64 OF 250