

REHAB.
Dis, CBs OR MHS, CLASS I, II OR III
SEE SHEETS 27-28

CHANGING ELEVATION OF SEWER MANHOLES
SEE SHEET 28

PORTLAND CEMENT
CONCRETE SIDEWALK, 5 INCH
STA. 226+38, LT

DETECTABLE WARNING SURFACE
STA. 226+38, LT

ADJUST ELEVATION OF VALVE BOX
SEE SHEETS 28-29

DURABLE & TEMPORARY 4 INCH WHITE LINE
(ALL LINES WILL INCLUDE 6" BREAKS FOR SIDE ROADS)
STA. 225+00 TO 230+00, SOLID LT & RT

DURABLE & TEMPORARY 4 INCH YELLOW LINE
(ALL LINES WILL INCLUDE 6" BREAKS FOR SIDE ROADS)
STA. 225+00 TO 230+00, SOLID LT & RT
STA. 226+58, DOUBLE SOLID LT (ELY ST. TH-486)


DURABLE & TEMPORARY 8 INCH WHITE LINE
STA. 226+91 TO 227+11, SOLID LT (HYDRANT)
SEE SHEET 55

DURABLE & TEMPORARY 24 INCH STOP BAR
STA. 226+58, LT (ELY ST. TH-486)


DURABLE & TEMPORARY LETTER OR SYMBOL
STA. 226+58, LT "STOP" (ELY ST. TH-486)

DURABLE CROSSWALK MARKING, TYPE A TAPE
STA. 226+58, LT (ELY ST. TH-486)
SEE SHEET 55 (TYP.)

TEMPORARY CROSSWALK MARKING, PAINT
STA. 226+58, LT (ELY ST. TH-486)
SEE SHEET 55 (TYP.)

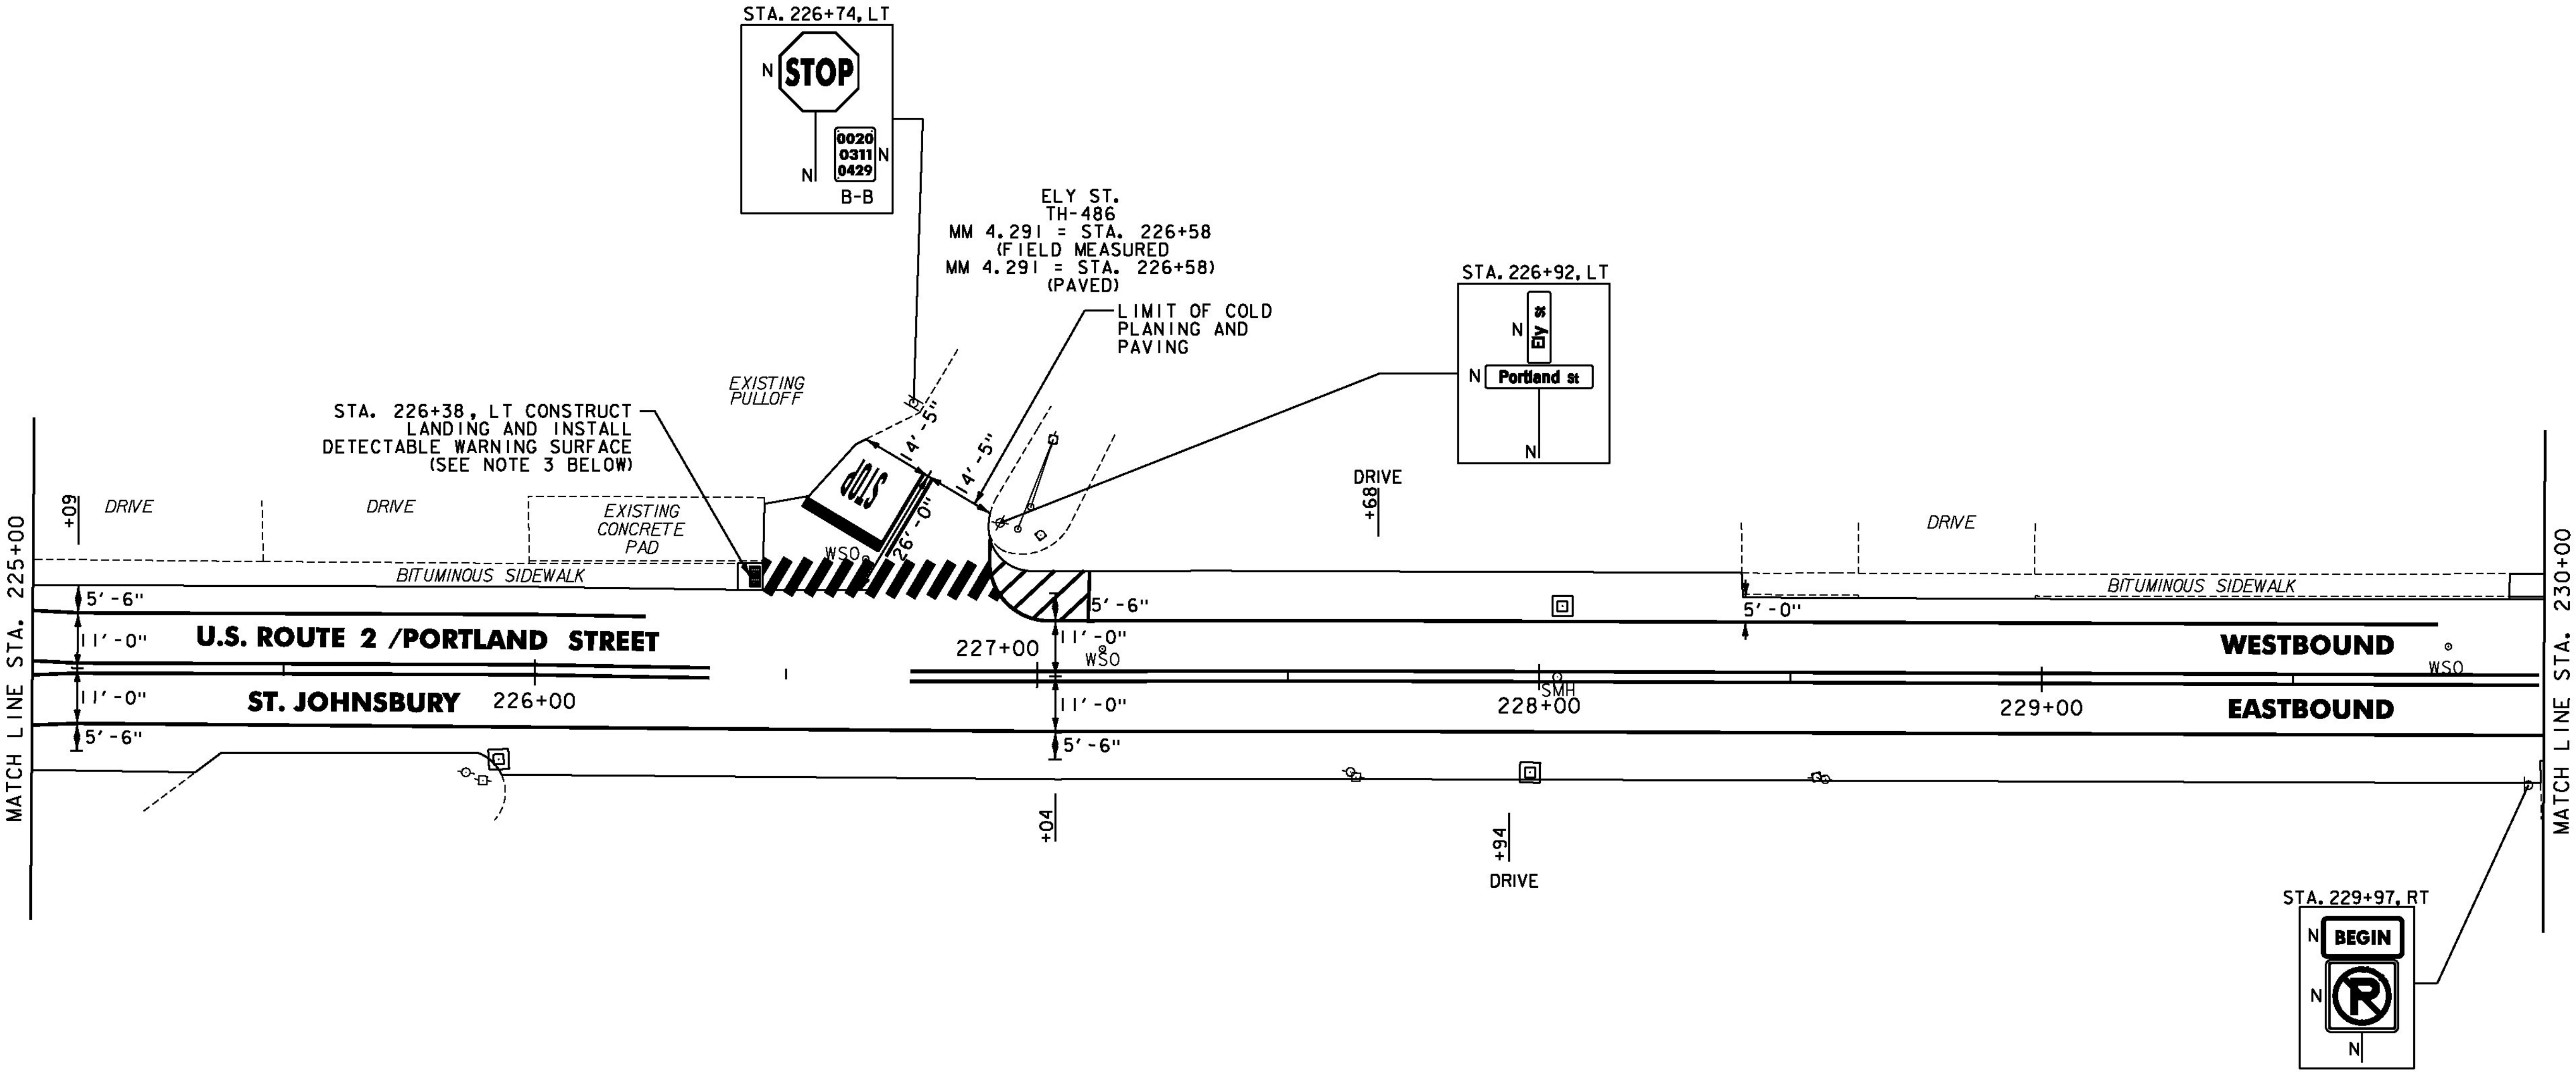

- NOTES:
- FOR LEGENDS, SEE SHEET 3.
 - ALL EXISTING SIGNS NOT SHOWN ON THE PLANS SHALL BE RETAINED.
 - THE SIDEWALK "LANDINGS" NOTED CONSIST OF THE REMOVAL AND REPLACEMENT OF A SINGLE SLAB OF CONCRETE SIDEWALK IN ORDER TO INSTALL A NEW DETECTABLE WARNING SURFACE. SEE SHEETS 12-25.

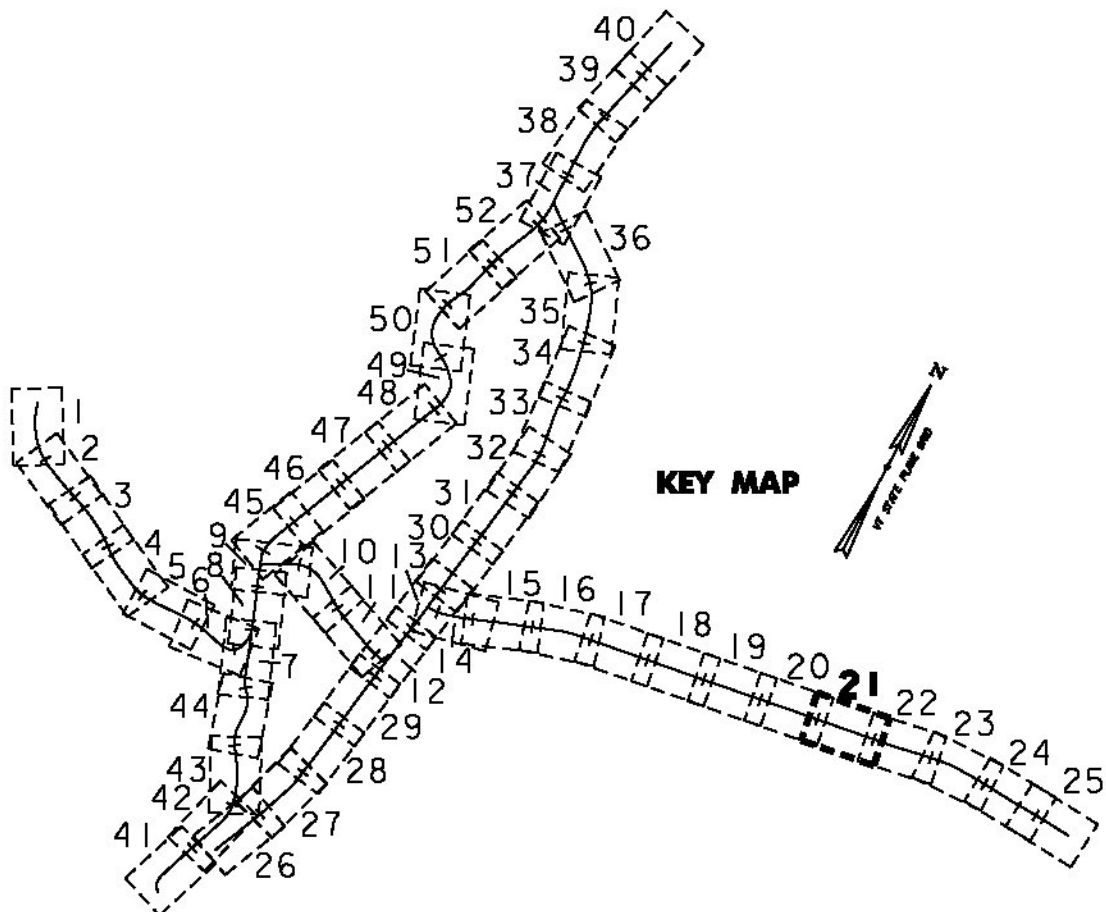

NOT TO SCALE

**PROJECT
LAYOUT
SHEET #21**

PROJECT NAME: ST JOHNSBURY - LYNDON
PROJECT NUMBER: STP 2936(I)

FILE NAME: pllc308.dgn
PROJECT LEADER: G. EDWARDS
DESIGNED BY: D. DRAPER

PLOT DATE: 5/5/2014
DRAWN BY: D. DRAPER
CHECKED BY: J. LITTLE
SHEET 83 OF 250