

REHAB.
DIS. CBS OR MHS. CLASS I, II OR III
SEE SHEETS 27-28

CAST-IN-PLACE CONCRETE CURB, TYPE B
STA. 75+90, LT

REMOVAL OF EXISTING CURB
STA. 75+90, LT

PORTLAND CEMENT
CONCRETE SIDEWALK, 5 INCH

STA. 75+00, LT
STA. 75+90, LT
STA. 79+05, LT

DETECTABLE WARNING SURFACE

STA. 75+00, LT
STA. 75+90, LT
STA. 79+05, LT

ADJUST ELEVATION OF VALVE BOX
SEE SHEETS 28-29

DURABLE & TEMPORARY 4 INCH WHITE LINE
(ALL LINES WILL INCLUDE EDGE LINE BREAKS
AND RADII FOR SIDE ROADS)

STA. 75+00 TO 80+00, SOLID LT & RT

DURABLE & TEMPORARY 4 INCH YELLOW LINE

(ALL LINES WILL INCLUDE C BREAKS FOR SIDE

ROADS & CROSSWALKS)

STA. 75+00 TO 80+00, SOLID LT & RT

STA. 75+11, DOUBLE SOLID LT (PEARL ST. TH-372)

DURABLE & TEMPORARY 8 INCH WHITE LINE
STA. 79+86 TO 80+00, LT (HYDRANT)
SEE SHEET 55

DURABLE & TEMPORARY 24 INCH STOP BAR
STA. 75+11, LT (PEARL ST. TH-372)

DURABLE & TEMPORARY LETTER OR SYMBOL
STA. 75+11, LT "STOP" (PEARL ST. TH-372)

DURABLE CROSSWALK MARKING, TYPE D TAPE

STA. 75+11, LT (PEARL ST. TH-372)

STA. 79+06, LT TO 79+08, RT

SEE SHEET 55 (TYP.)


TEMPORARY CROSSWALK MARKING, PAINT

STA. 75+11, LT (PEARL ST. TH-372)

STA. 79+06, LT TO 79+08, RT


SEE SHEET 55 (TYP.)

REMOVING SIGNS
AS SHOWN - 5

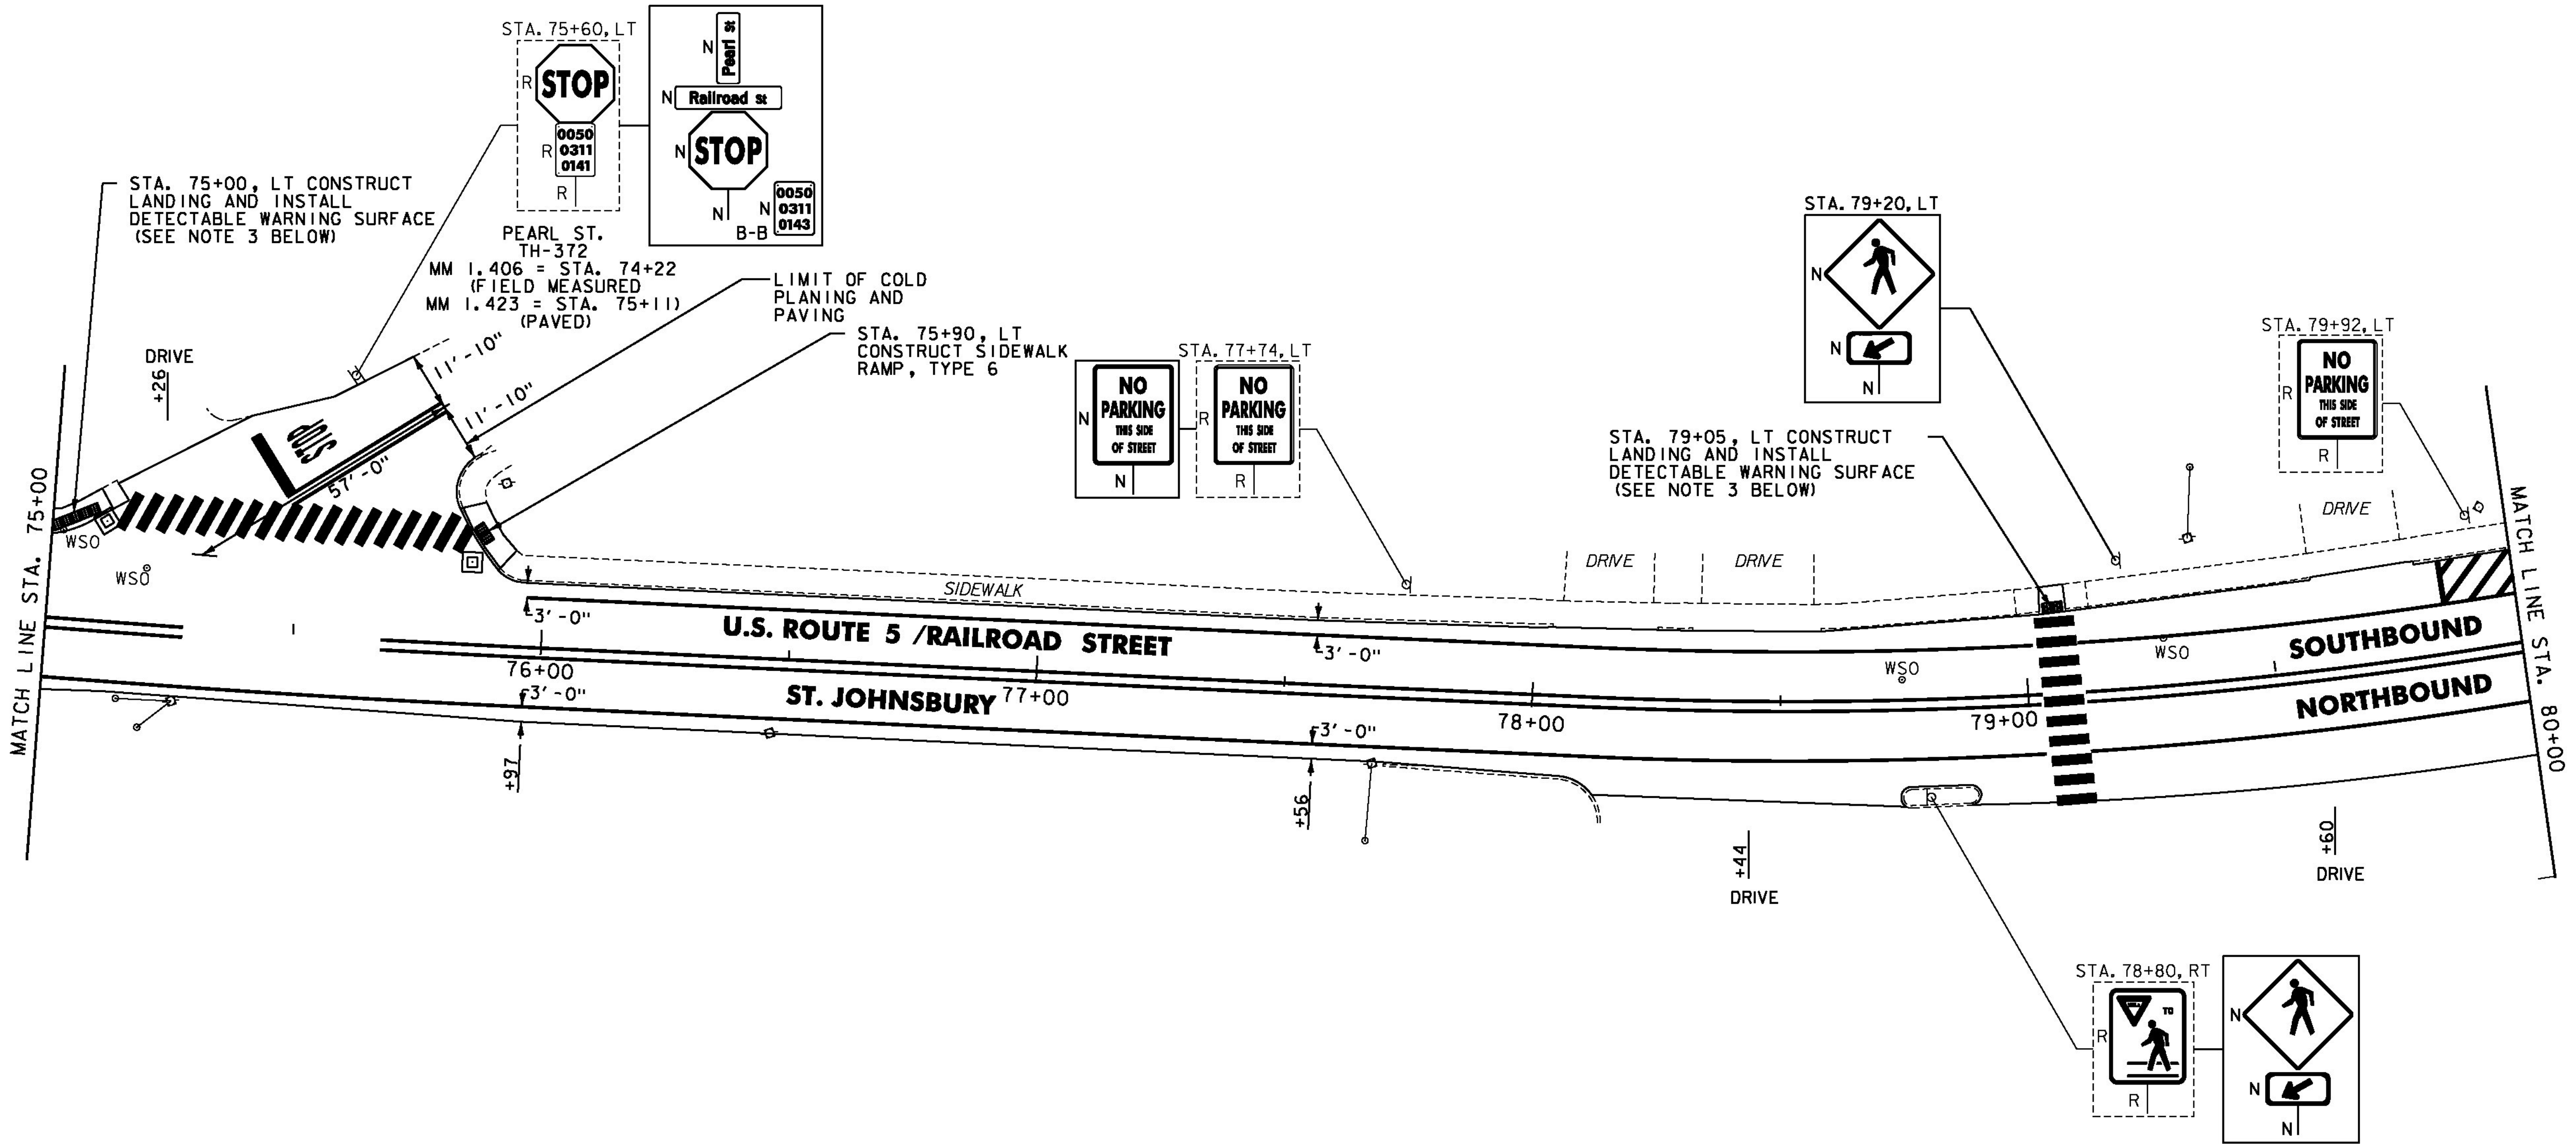

NOTES:

- FOR LEGENDS, SEE SHEET 3.
- ALL EXISTING SIGNS NOT SHOWN ON THE PLANS SHALL BE RETAINED.
- THE SIDEWALK "LANDINGS" NOTED CONSIST OF THE REMOVAL AND REPLACEMENT OF A SINGLE SLAB OF CONCRETE SIDEWALK IN ORDER TO INSTALL A NEW DETECTABLE WARNING SURFACE. SEE SHEETS 12-25.

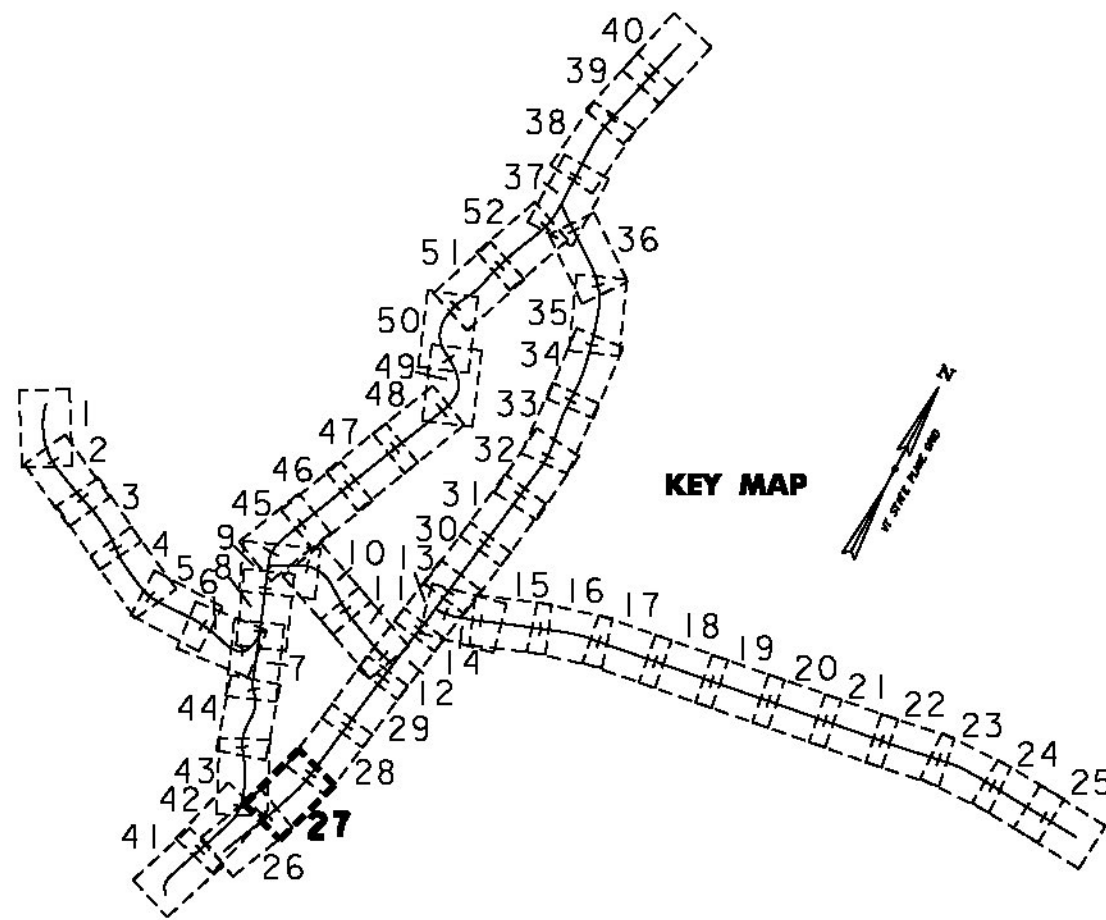

NOT TO SCALE



PROJECT
LAYOUT
SHEET #27

PROJECT NAME: ST JOHNSBURY - LYNDON
PROJECT NUMBER: STP 2936(I)

FILE NAME: pllc308.dgn
PROJECT LEADER: G. EDWARDS
DESIGNED BY: D. DRAPER

PLOT DATE: 5/5/2014
DRAWN BY: D. DRAPER
CHECKED BY: J. LITTLE
SHEET 89 OF 250