

THINNING AND TRIMMING FOR SIGNS  
STA. 106+19, RT  
SEE SHEET 241 (TYP.)

REHAB.  
DIS, CBS OR MHS, CLASS I, II OR III  
SEE SHEETS 27-28

CHANGING ELEVATION OF SEWER MANHOLES  
SEE SHEET 28

CAST-IN-PLACE CONCRETE CURB, TYPE B  
STA. 104+83, LT  
STA. 105+13, LT

REMOVAL OF EXISTING CURB  
STA. 104+83, LT  
STA. 105+13, LT

PORTLAND CEMENT  
CONCRETE SIDEWALK, 5 INCH  
STA. 104+83, LT  
STA. 105+13, LT

DETECTABLE WARNING SURFACE  
STA. 104+83, LT  
STA. 105+13, LT

ADJUST ELEVATION OF VALVE BOX  
SEE SHEETS 28-29

DURABLE & TEMPORARY 4 INCH WHITE LINE  
(ALL LINES WILL INCLUDE EDGE LINE BREAKS  
AND RADII FOR SIDE ROADS)  
STA. 104+00 TO 109+00, SOLID LT & RT

DURABLE & TEMPORARY 4 INCH YELLOW LINE  
(ALL LINES WILL INCLUDE & BREAKS FOR SIDE ROADS)  
STA. 104+00 TO 109+00, SOLID LT & RT  
STA. 104+99, DOUBLE SOLID LT (BAGLEY ST. TH-394)

DURABLE & TEMPORARY 8 INCH WHITE LINE  
STA. 108+13 TO 108+33, RT (HYDRANT)  
SEE SHEET 55

DURABLE & TEMPORARY 24 INCH STOP BAR  
STA. 104+99, LT (BAGLEY ST. TH-394)



DURABLE & TEMPORARY LETTER OR SYMBOL  
STA. 104+99, LT "STOP" (BAGLEY ST. TH-394)

DURABLE CROSSWALK MARKING, TYPE D TAPE  
STA. 104+99, LT (BAGLEY ST. TH-394)  
SEE SHEET 55 (TYP.)

TEMPORARY CROSSWALK MARKING, PAINT  
STA. 104+99, LT (BAGLEY ST. TH-394)  
SEE SHEET 55 (TYP.)

REMOVING SIGNS  
AS SHOWN - 8

ERECTING SALVAGED SIGNS  
AS SHOWN - 1

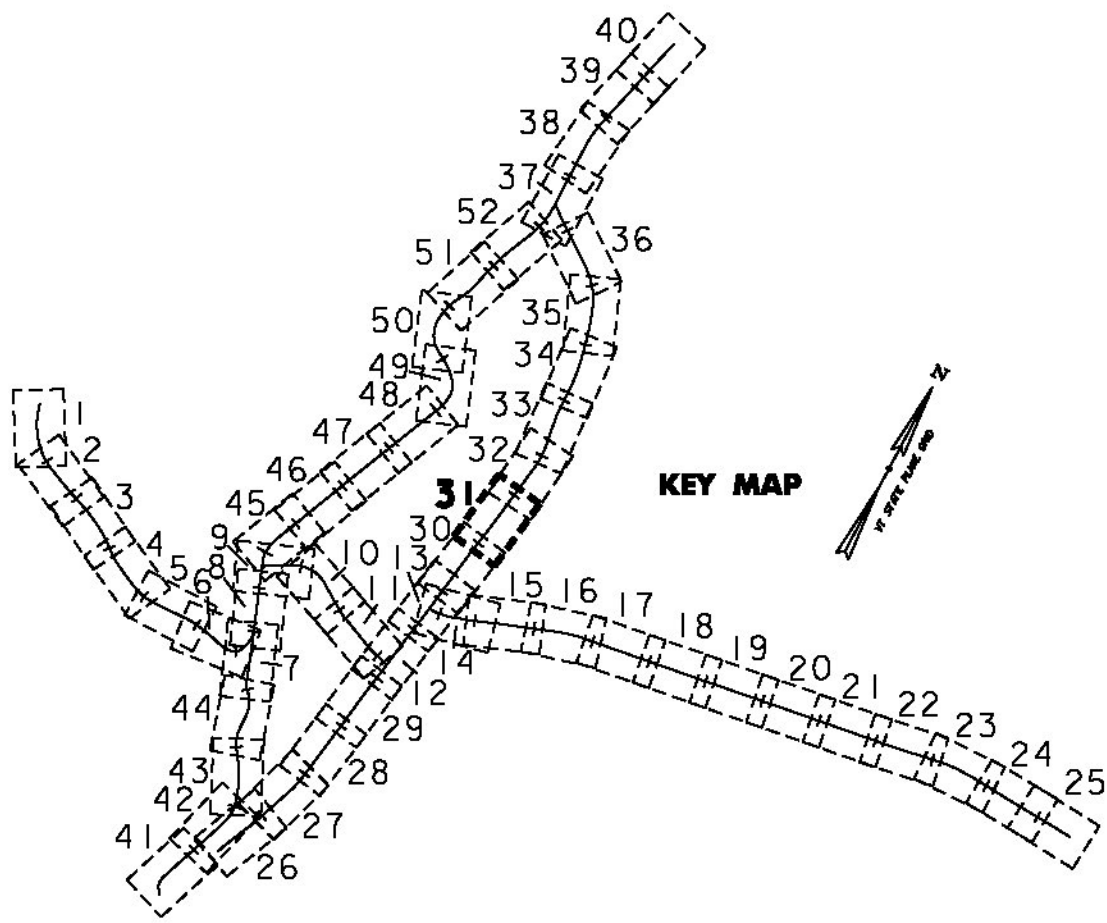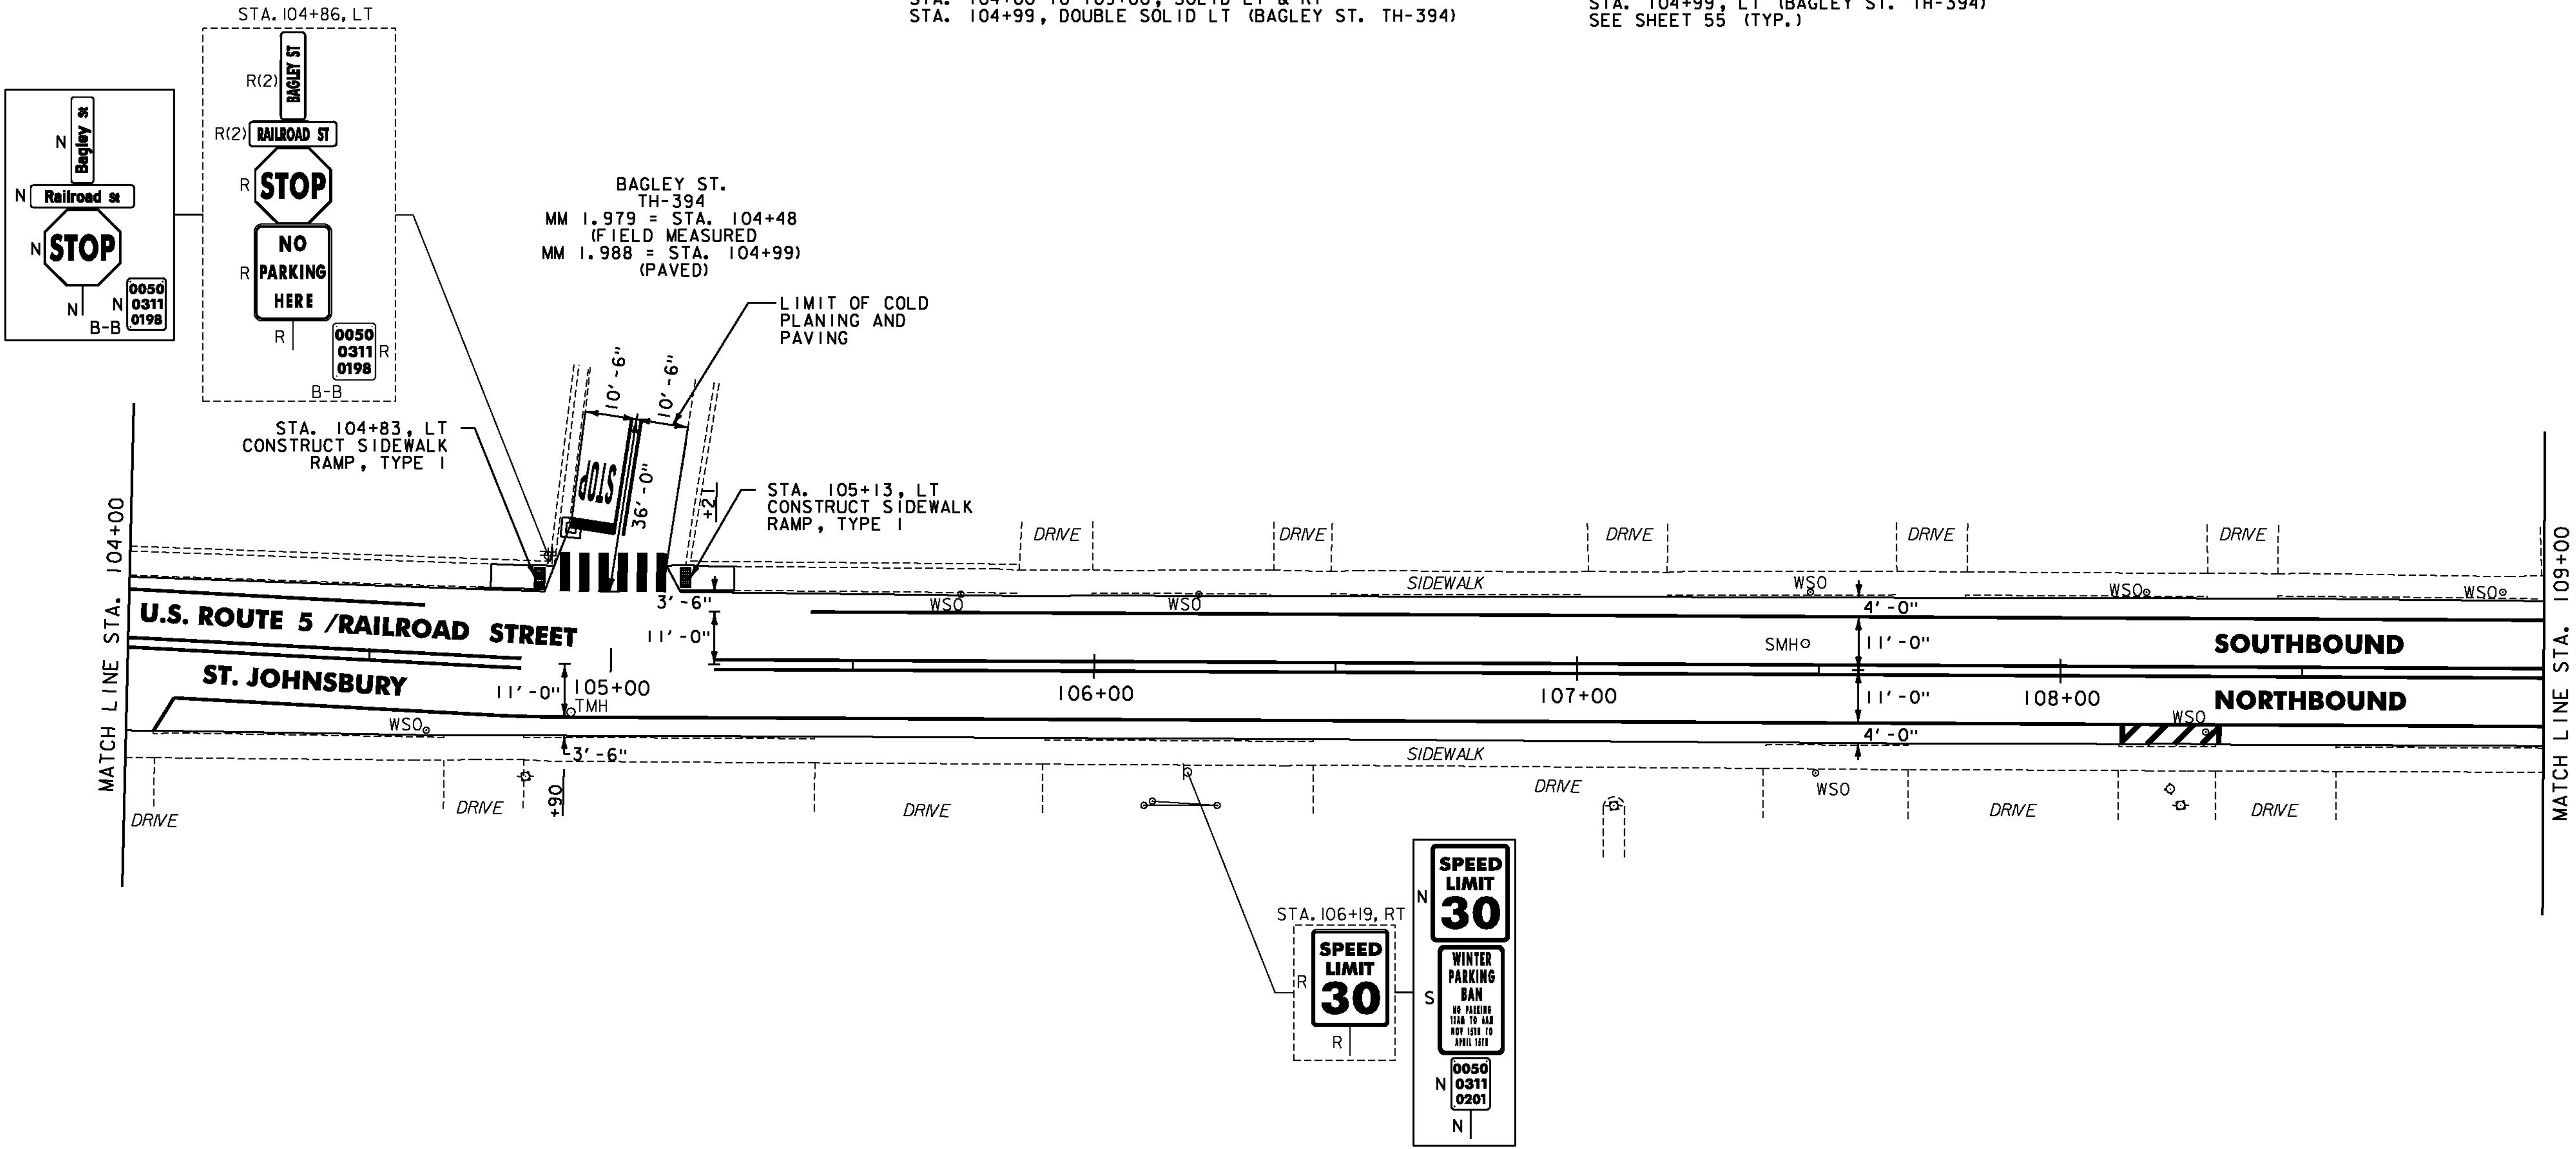

- NOTES:
- FOR LEGENDS, SEE SHEET 3.
  - ALL EXISTING SIGNS NOT SHOWN ON THE PLANS SHALL BE RETAINED.



NOT TO SCALE

**PROJECT  
LAYOUT  
SHEET #31**

PROJECT NAME: ST JOHNSBURY - LYNDON  
PROJECT NUMBER: STP 2936(I)

FILE NAME: pllc308.dgn  
PROJECT LEADER: G. EDWARDS  
DESIGNED BY: D. DRAPER

PLOT DATE: 5/5/2014  
DRAWN BY: D. DRAPER  
CHECKED BY: J. LITTLE  
SHEET 93 OF 250