

REHAB.
DLS, CBS OR MHS, CLASS I, II OR III
SEE SHEETS 27-28

VERTICAL GRANITE CURB
STA. 112+79, RT (MILL ST. TH-470)

CAST-IN-PLACE CONCRETE CURB, TYPE B
STA. 111+13, RT
STA. 111+31, LT

REMOVING AND RESETTNG CURB
STA. 112+79, RT (MILL ST. TH-470)

REMOVAL OF EXISTING CURB
STA. 111+13, RT
STA. 111+31, LT

PORTLAND CEMENT
CONCRETE SIDEWALK, 5 INCH
STA. 112+79, RT (MILL ST. TH-470)
STA. 112+97, RT (MILL ST. TH-470)
(FOR DETAILS, SEE SHEET 57)
STA. 111+13, RT
STA. 111+31, LT

DETECTABLE WARNING SURFACE
STA. 112+79, RT (MILL ST. TH-470)
STA. 112+97, RT (MILL ST. TH-470)
STA. 111+13, RT
STA. 111+31, LT
ADJUST ELEVATION OF VALVE BOX
SEE SHEETS 28-29

RAILROAD CROSSING SYMBOL
STA. 114+35, RT (MILL ST. TH-470)

DURABLE & TEMPORARY 4 INCH WHITE LINE
(ALL LINES WILL INCLUDE EDGE LINE BREAKS
AND RADII FOR SIDE ROADS)
STA. 109+00 TO 113+00, SOLID LT & RT

DURABLE & TEMPORARY 4 INCH YELLOW LINE
(ALL LINES WILL INCLUDE 4 BREAKS FOR SIDE
ROADS & CROSSWALKS)
STA. 109+00 TO 113+00, SOLID LT & RT
STA. 110+93, DOUBLE SOLID RT (MILL ST. TH-470)

DURABLE & TEMPORARY 24 INCH STOP BAR
STA. 110+93, RT (MILL ST. TH-470)

DURABLE & TEMPORARY LETTER OR SYMBOL
STA. 110+93, RT "STOP" (MILL ST. TH-470)


DURABLE CROSSWALK MARKING, TYPE A TAPE
STA. 111+14, RT - 111+31, LT
SEE SHEET 55 (TYP.)

DURABLE RAILROAD CROSSING SYMBOL, TYPE D TAPE
STA. 111+90, RT (MILL ST. TH-470)

TEMPORARY CROSSWALK MARKING, PAINT
STA. 111+14, RT - 111+31, LT
SEE SHEET 55 (TYP.)

TEMPORARY RAILROAD CROSSING SYMBOL, PAINT
STA. 111+90, RT (MILL ST. TH-470)

REMOVING SIGNS
AS SHOWN - 12
ERECTING SALVAGED SIGNS
AS SHOWN - 1

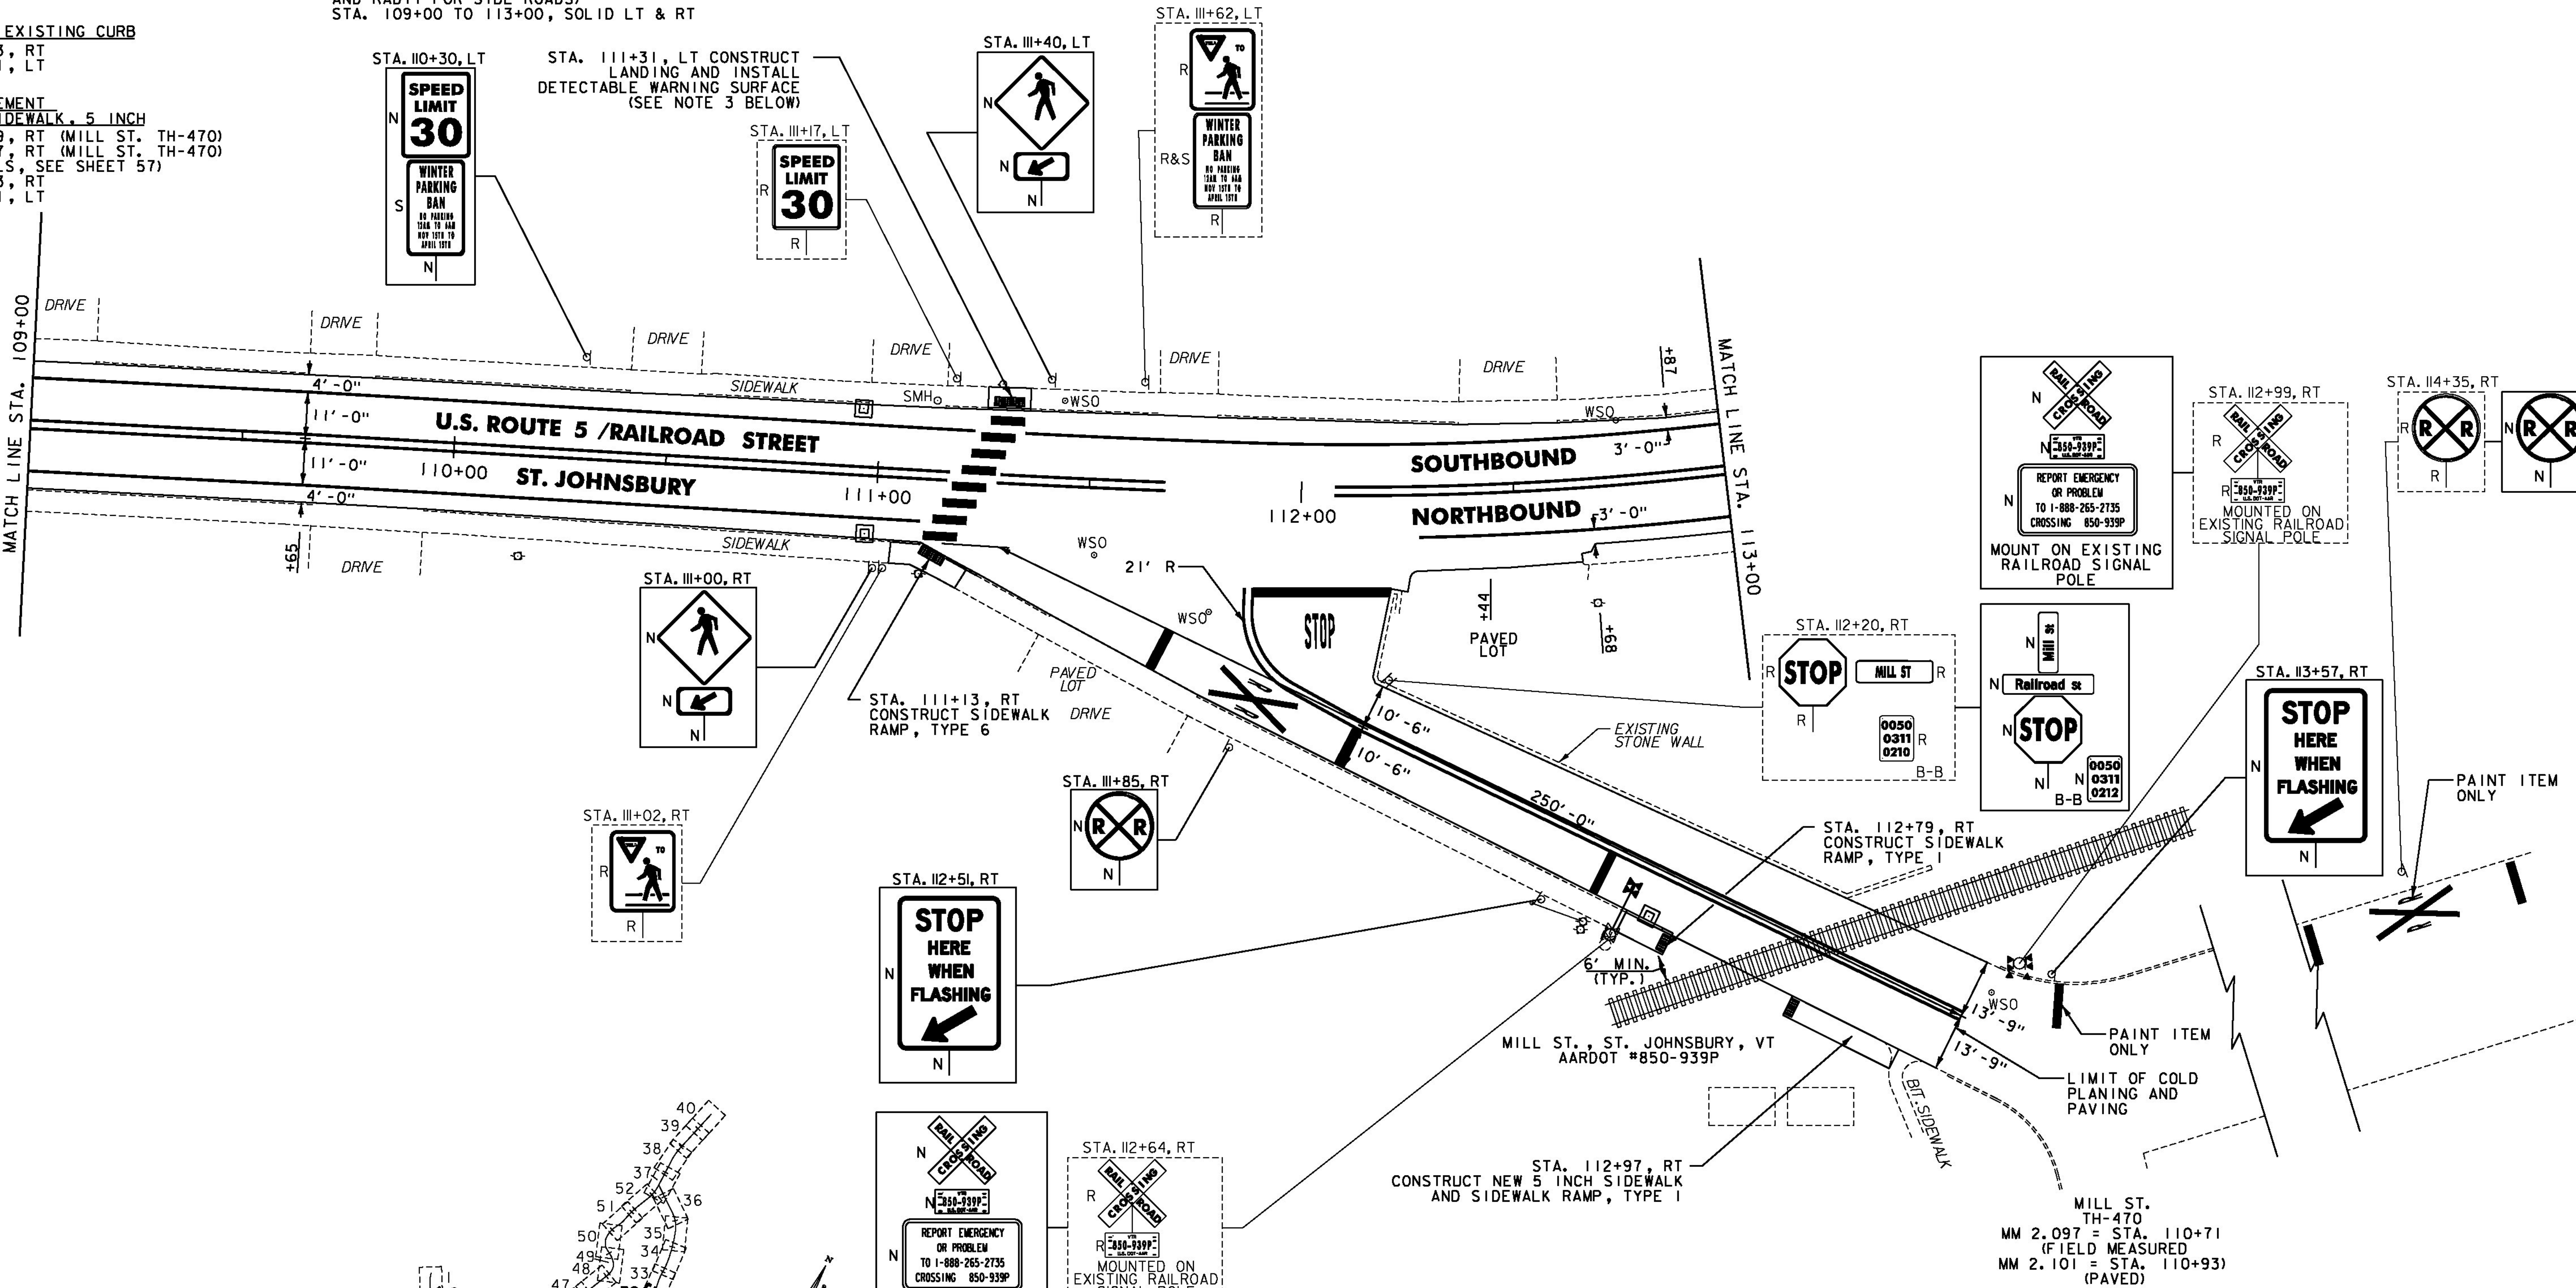

NOTES:

- FOR LEGENDS, SEE SHEET 3.
- ALL EXISTING SIGNS NOT SHOWN ON THE PLANS SHALL BE RETAINED.
- THE SIDEWALK "LANDINGS" NOTED CONSIST OF THE REMOVAL AND REPLACEMENT OF A SINGLE SLAB OF CONCRETE SIDEWALK IN ORDER TO INSTALL A NEW DETECTABLE WARNING SURFACE. SEE SHEETS 12-25.
- SEE SHEETS 32-36 FOR RAILROAD CROSSING DETAILS.

NOT TO SCALE

PROJECT
LAYOUT
SHEET #32

PROJECT NAME: ST JOHNSBURY - LYNDON
PROJECT NUMBER: STP 2936(I)

FILE NAME: pllc308.dgn
PROJECT LEADER: G. EDWARDS
DESIGNED BY: D. DRAPER

PLOT DATE: 5/5/2014
DRAWN BY: D. DRAPER
SHEET 94 OF 250

