

REHAB,
DIS, C&S OR MHS, CLASS I, II OR III
SEE SHEETS 27-28



CHANGING ELEVATION OF SEWER MANHOLES
SEE SHEET 28

ADJUST ELEVATION OF VALVE BOX
SEE SHEETS 28-29

DURABLE & TEMPORARY 4 INCH WHITE LINE
(ALL LINES WILL INCLUDE EDGE LINE BREAKS
AND RADII FOR SIDE ROADS)
STA. 113+00 TO 118+00, SOLID LT & RT

DURABLE & TEMPORARY 4 INCH YELLOW LINE
(ALL LINES WILL INCLUDE & BREAKS FOR SIDE ROADS)
STA. 113+00 TO 118+00, SOLID LT & RT

REMOVING SIGNS
AS SHOWN - 2

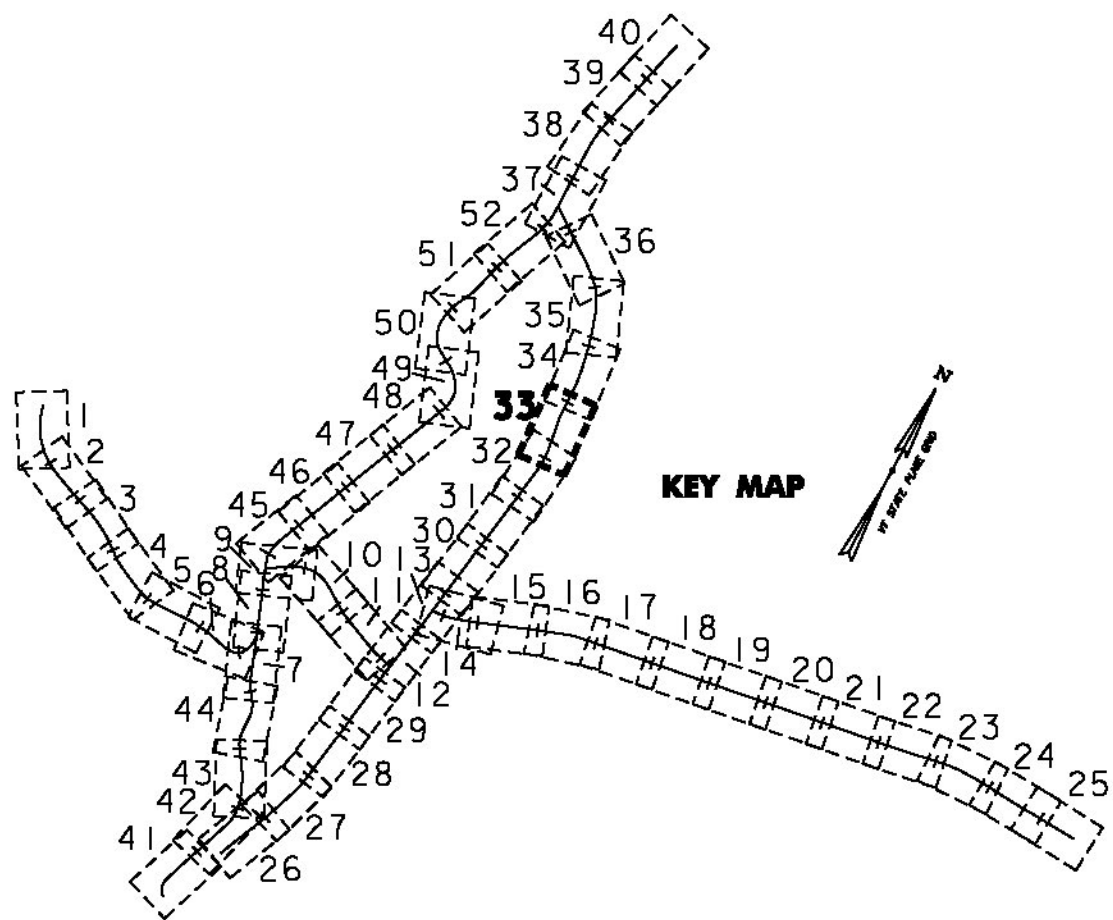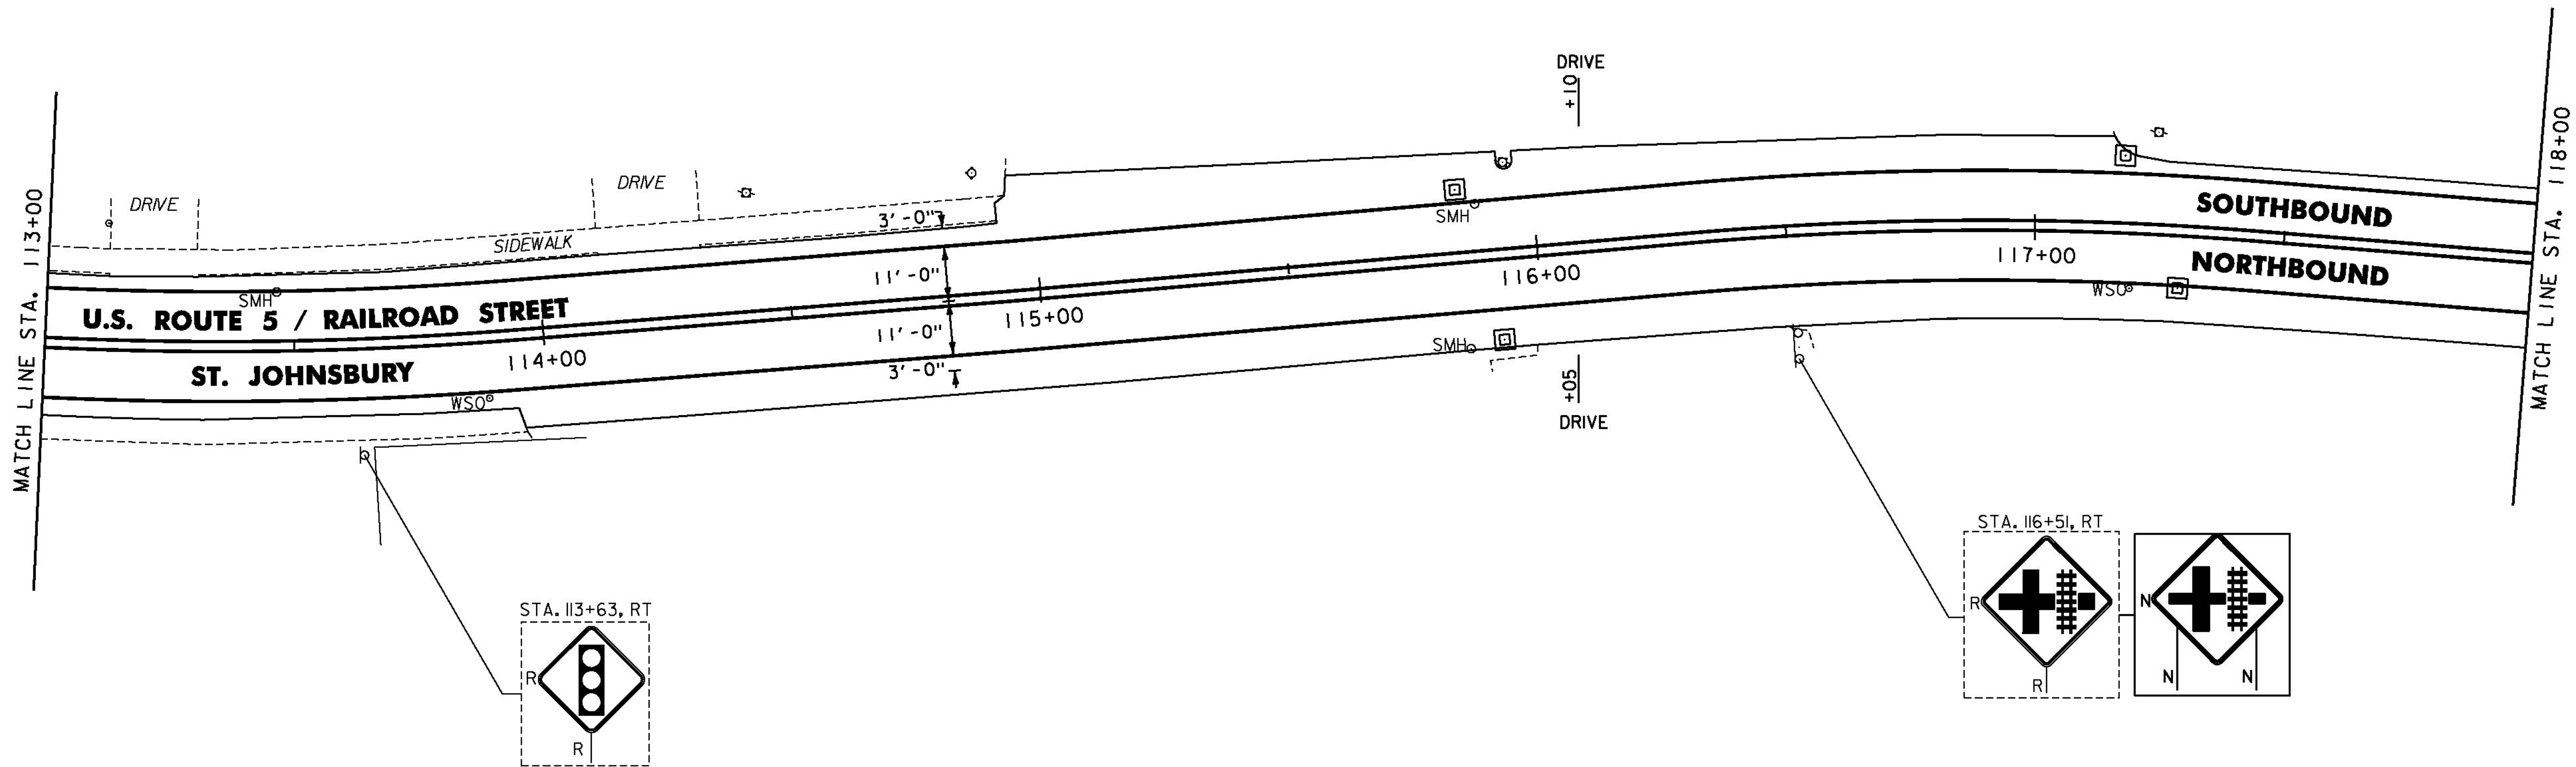

- NOTES:
1. FOR LEGENDS, SEE SHEET 3.
 2. ALL EXISTING SIGNS NOT SHOWN ON THE PLANS SHALL BE RETAINED.



NOT TO SCALE

**PROJECT
LAYOUT
SHEET #33**

PROJECT NAME: ST JOHNSBURY - LYNDON
PROJECT NUMBER: STP 2936(I)

FILE NAME: pllc308.dgn
PROJECT LEADER: G. EDWARDS
DESIGNED BY: D. DRAPER

PLOT DATE: 5/5/2014
DRAWN BY: D. DRAPER
CHECKED BY: J. LITTLE
SHEET 95 OF 250