


FOR ALL CONSTRUCTION NOTES
SEE SHEET 100

U.S. ROUTE 5
STA. 135+64.32 (MM 2.569) =
ALT U.S. ROUTE 5
STA. 67+53.12 (MM 1.279)



- NOTES:
1. FOR LEGENDS, SEE SHEET 3.
 2. ALL EXISTING SIGNS NOT SHOWN ON THE PLANS SHALL BE RETAINED.
 3. THE SIDEWALK "LANDINGS" NOTED CONSIST OF THE REMOVAL AND REPLACEMENT OF A SINGLE SLAB OF CONCRETE SIDEWALK IN ORDER TO INSTALL A NEW DETECTABLE WARNING SURFACE. SEE SHEETS 12-25.
 4. SEE SHEET 244 FOR TRAFFIC SIGNAL DETAILS.

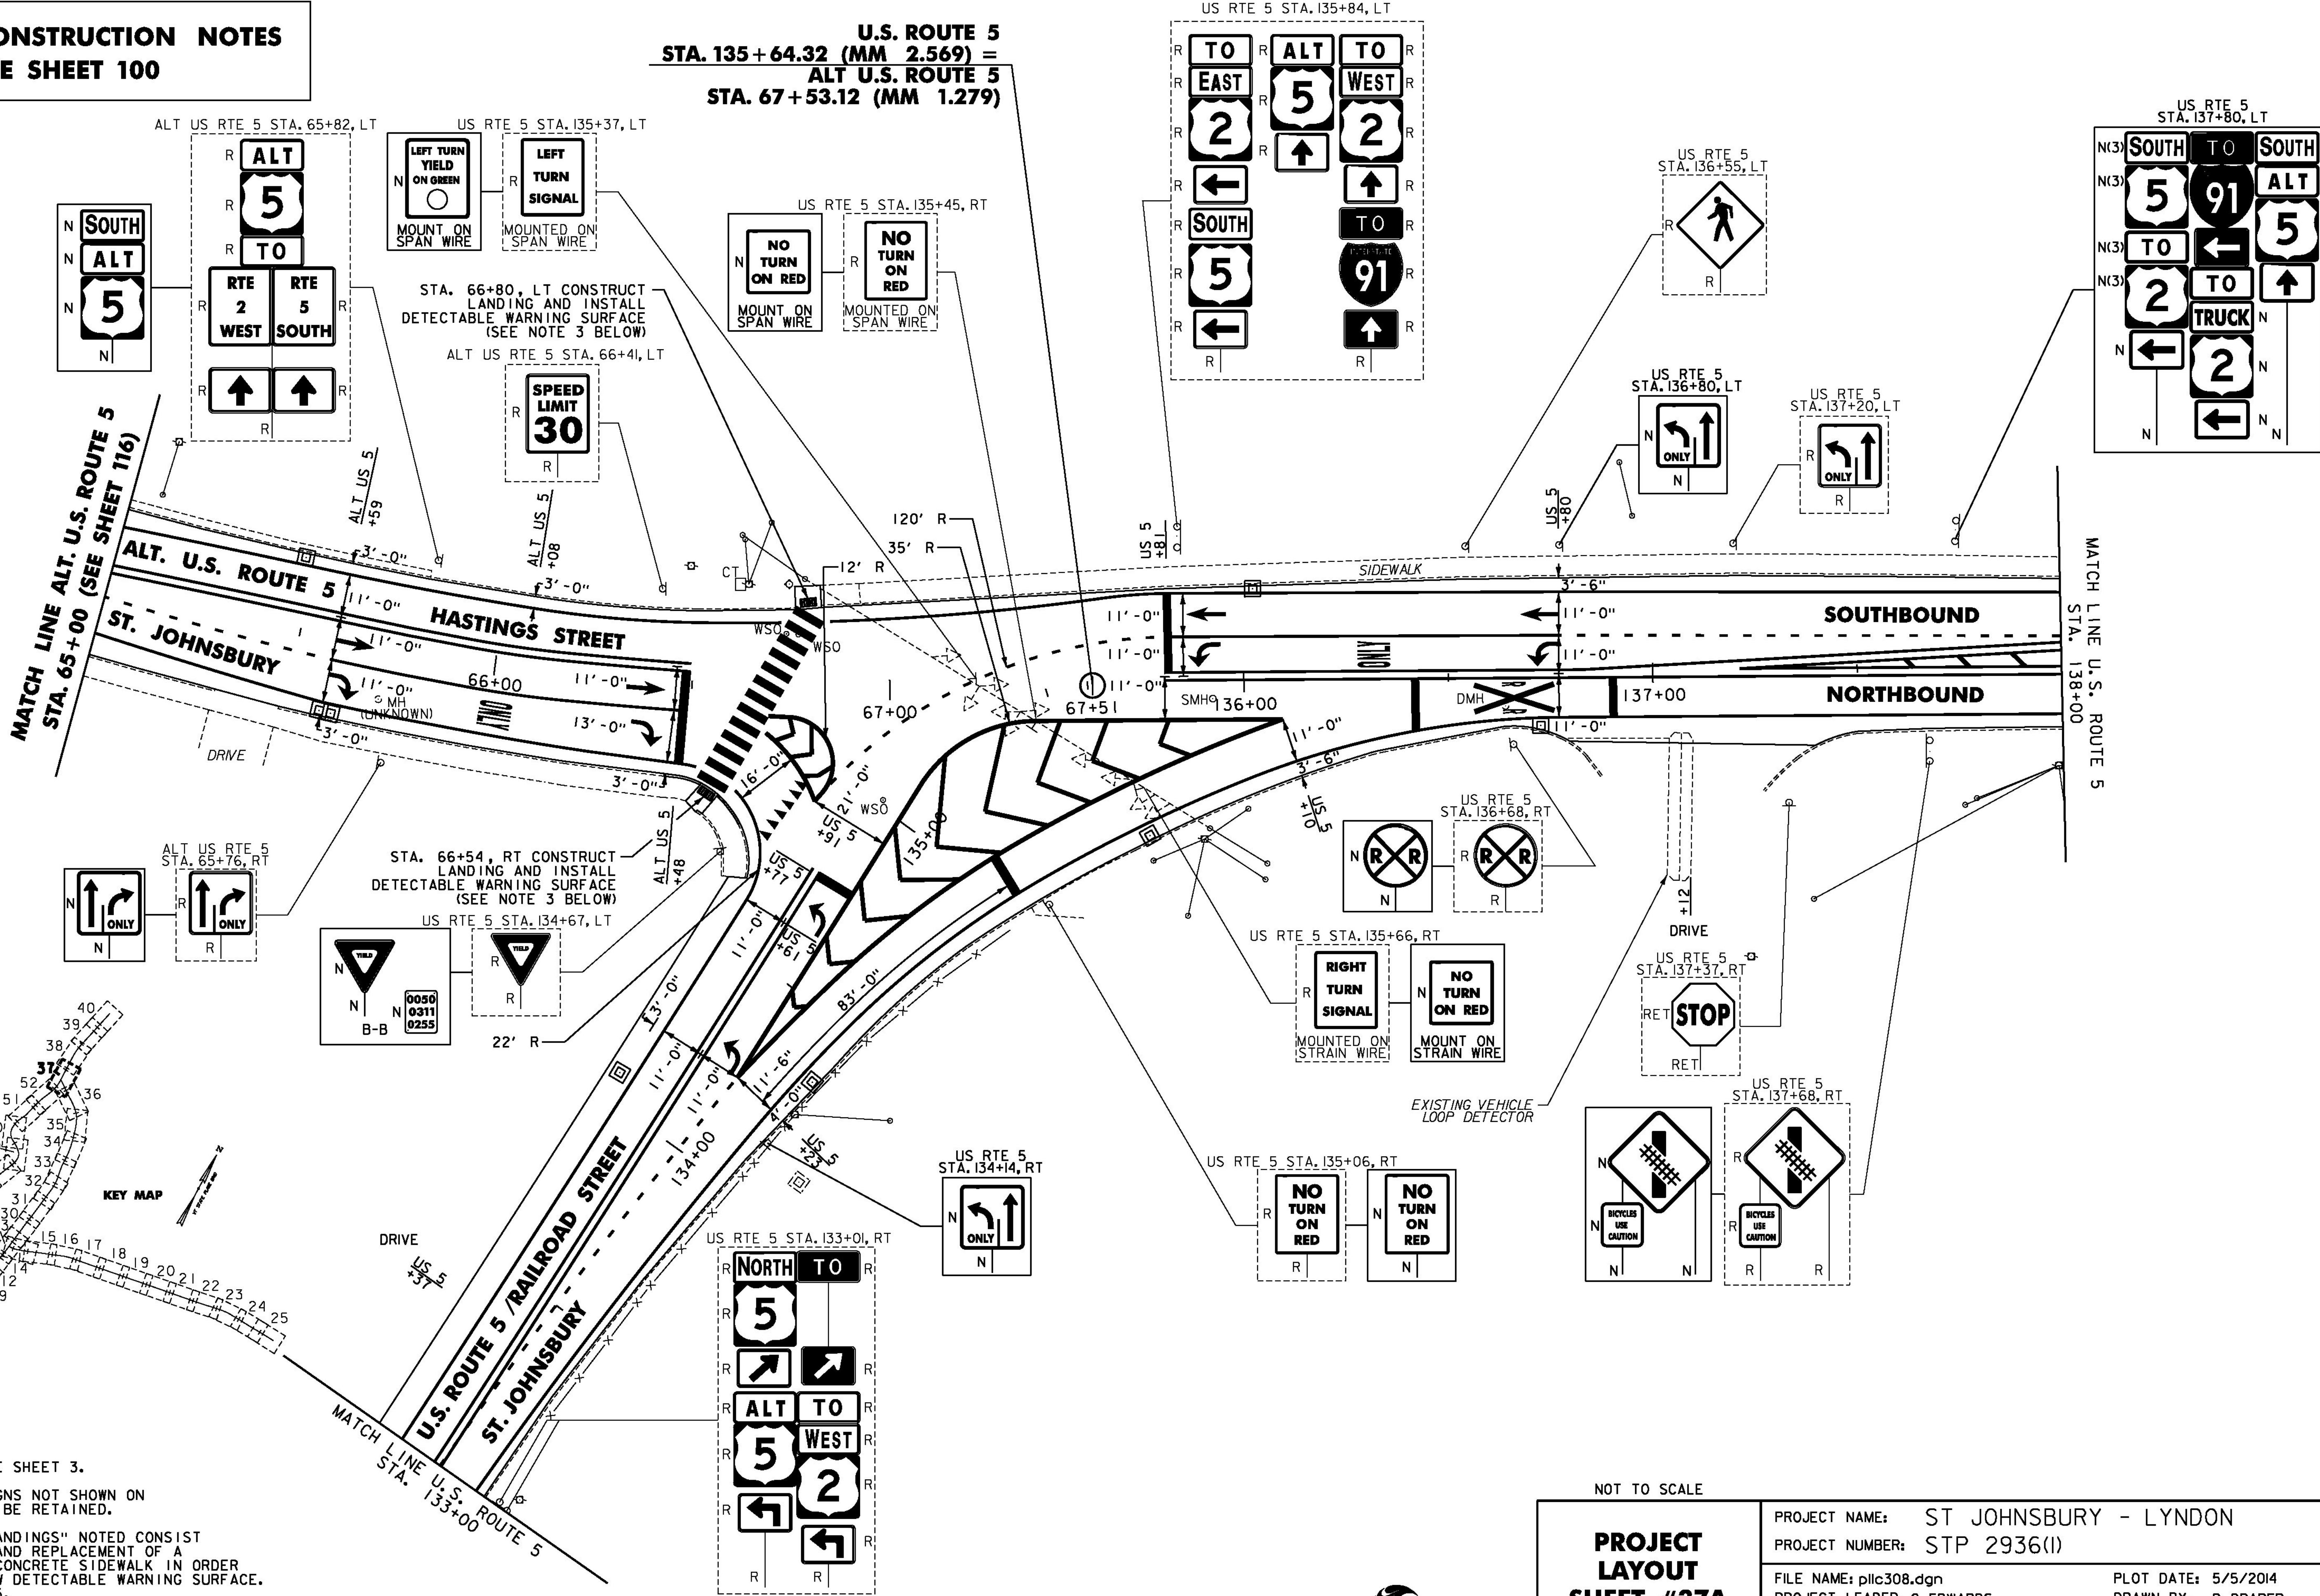

NOT TO SCALE	
PROJECT LAYOUT SHEET #37A	
PROJECT NAME: ST JOHNSBURY - LYNDON	PLOT DATE: 5/5/2014
PROJECT NUMBER: STP 2936(I)	DRAWN BY: D. DRAPER
FILE NAME: pllc308.dgn	CHECKED BY: J. LITTLE
PROJECT LEADER: G. EDWARDS	SHEET 99 OF 250
DESIGNED BY: D. DRAPER	