


REMOVING SIGNS
AS SHOWN - 3



PLOT DATE: 5/5/2014
DRAWN BY: D. DRAPER
CHECKED BY: J. LITTLE
SHEET 106 OF 250

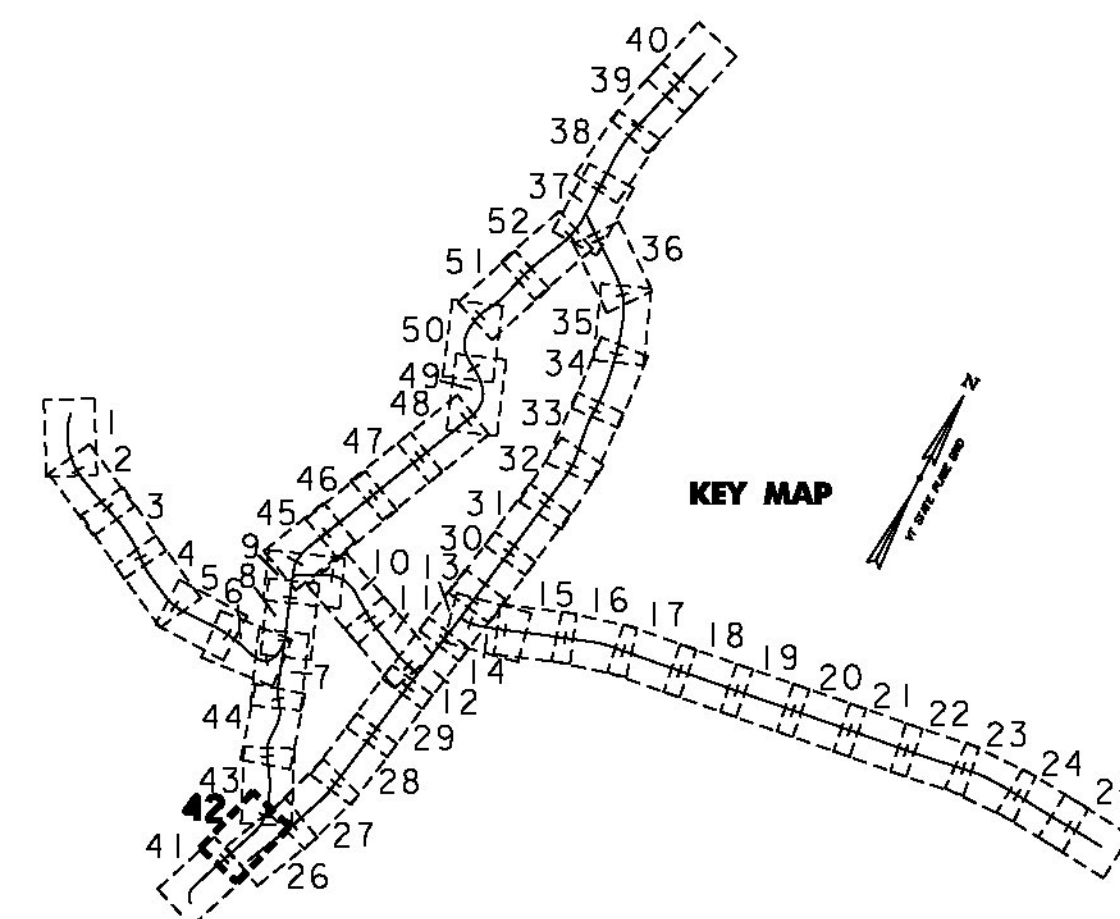