

STEEL BEAM GUARDRAIL, GALVANIZED W/8 FEET POSTS
STA. 15+00 TO 17+50, RT


DURABLE & TEMPORARY 4 INCH WHITE LINE
(ALL LINES WILL INCLUDE EDGE LINE BREAKS
AND RADIUS FOR SIDE ROADS)
STA. 15+00 TO 21+00, SOLID LT & RT
STA. 20+56, SOLID LT (EDGELINES, FAIRBANKS DR. TH-364)

DURABLE & TEMPORARY 24 INCH STOP BAR
STA. 20+56, LT (FAIRBANKS DR. TH-364)

DURABLE CROSSWALK MARKING, TYPE A TAPE
STA. 20+56, LT (FAIRBANKS DR. TH-364)
SEE SHEET 55 (TYP.)

TEMPORARY CROSSWALK MARKING, PAINT
STA. 20+56, LT (FAIRBANKS DR. TH-364)
SEE SHEET 55 (TYP.)

ERECTING SALVAGED SIGNS
AS SHOWN - 1

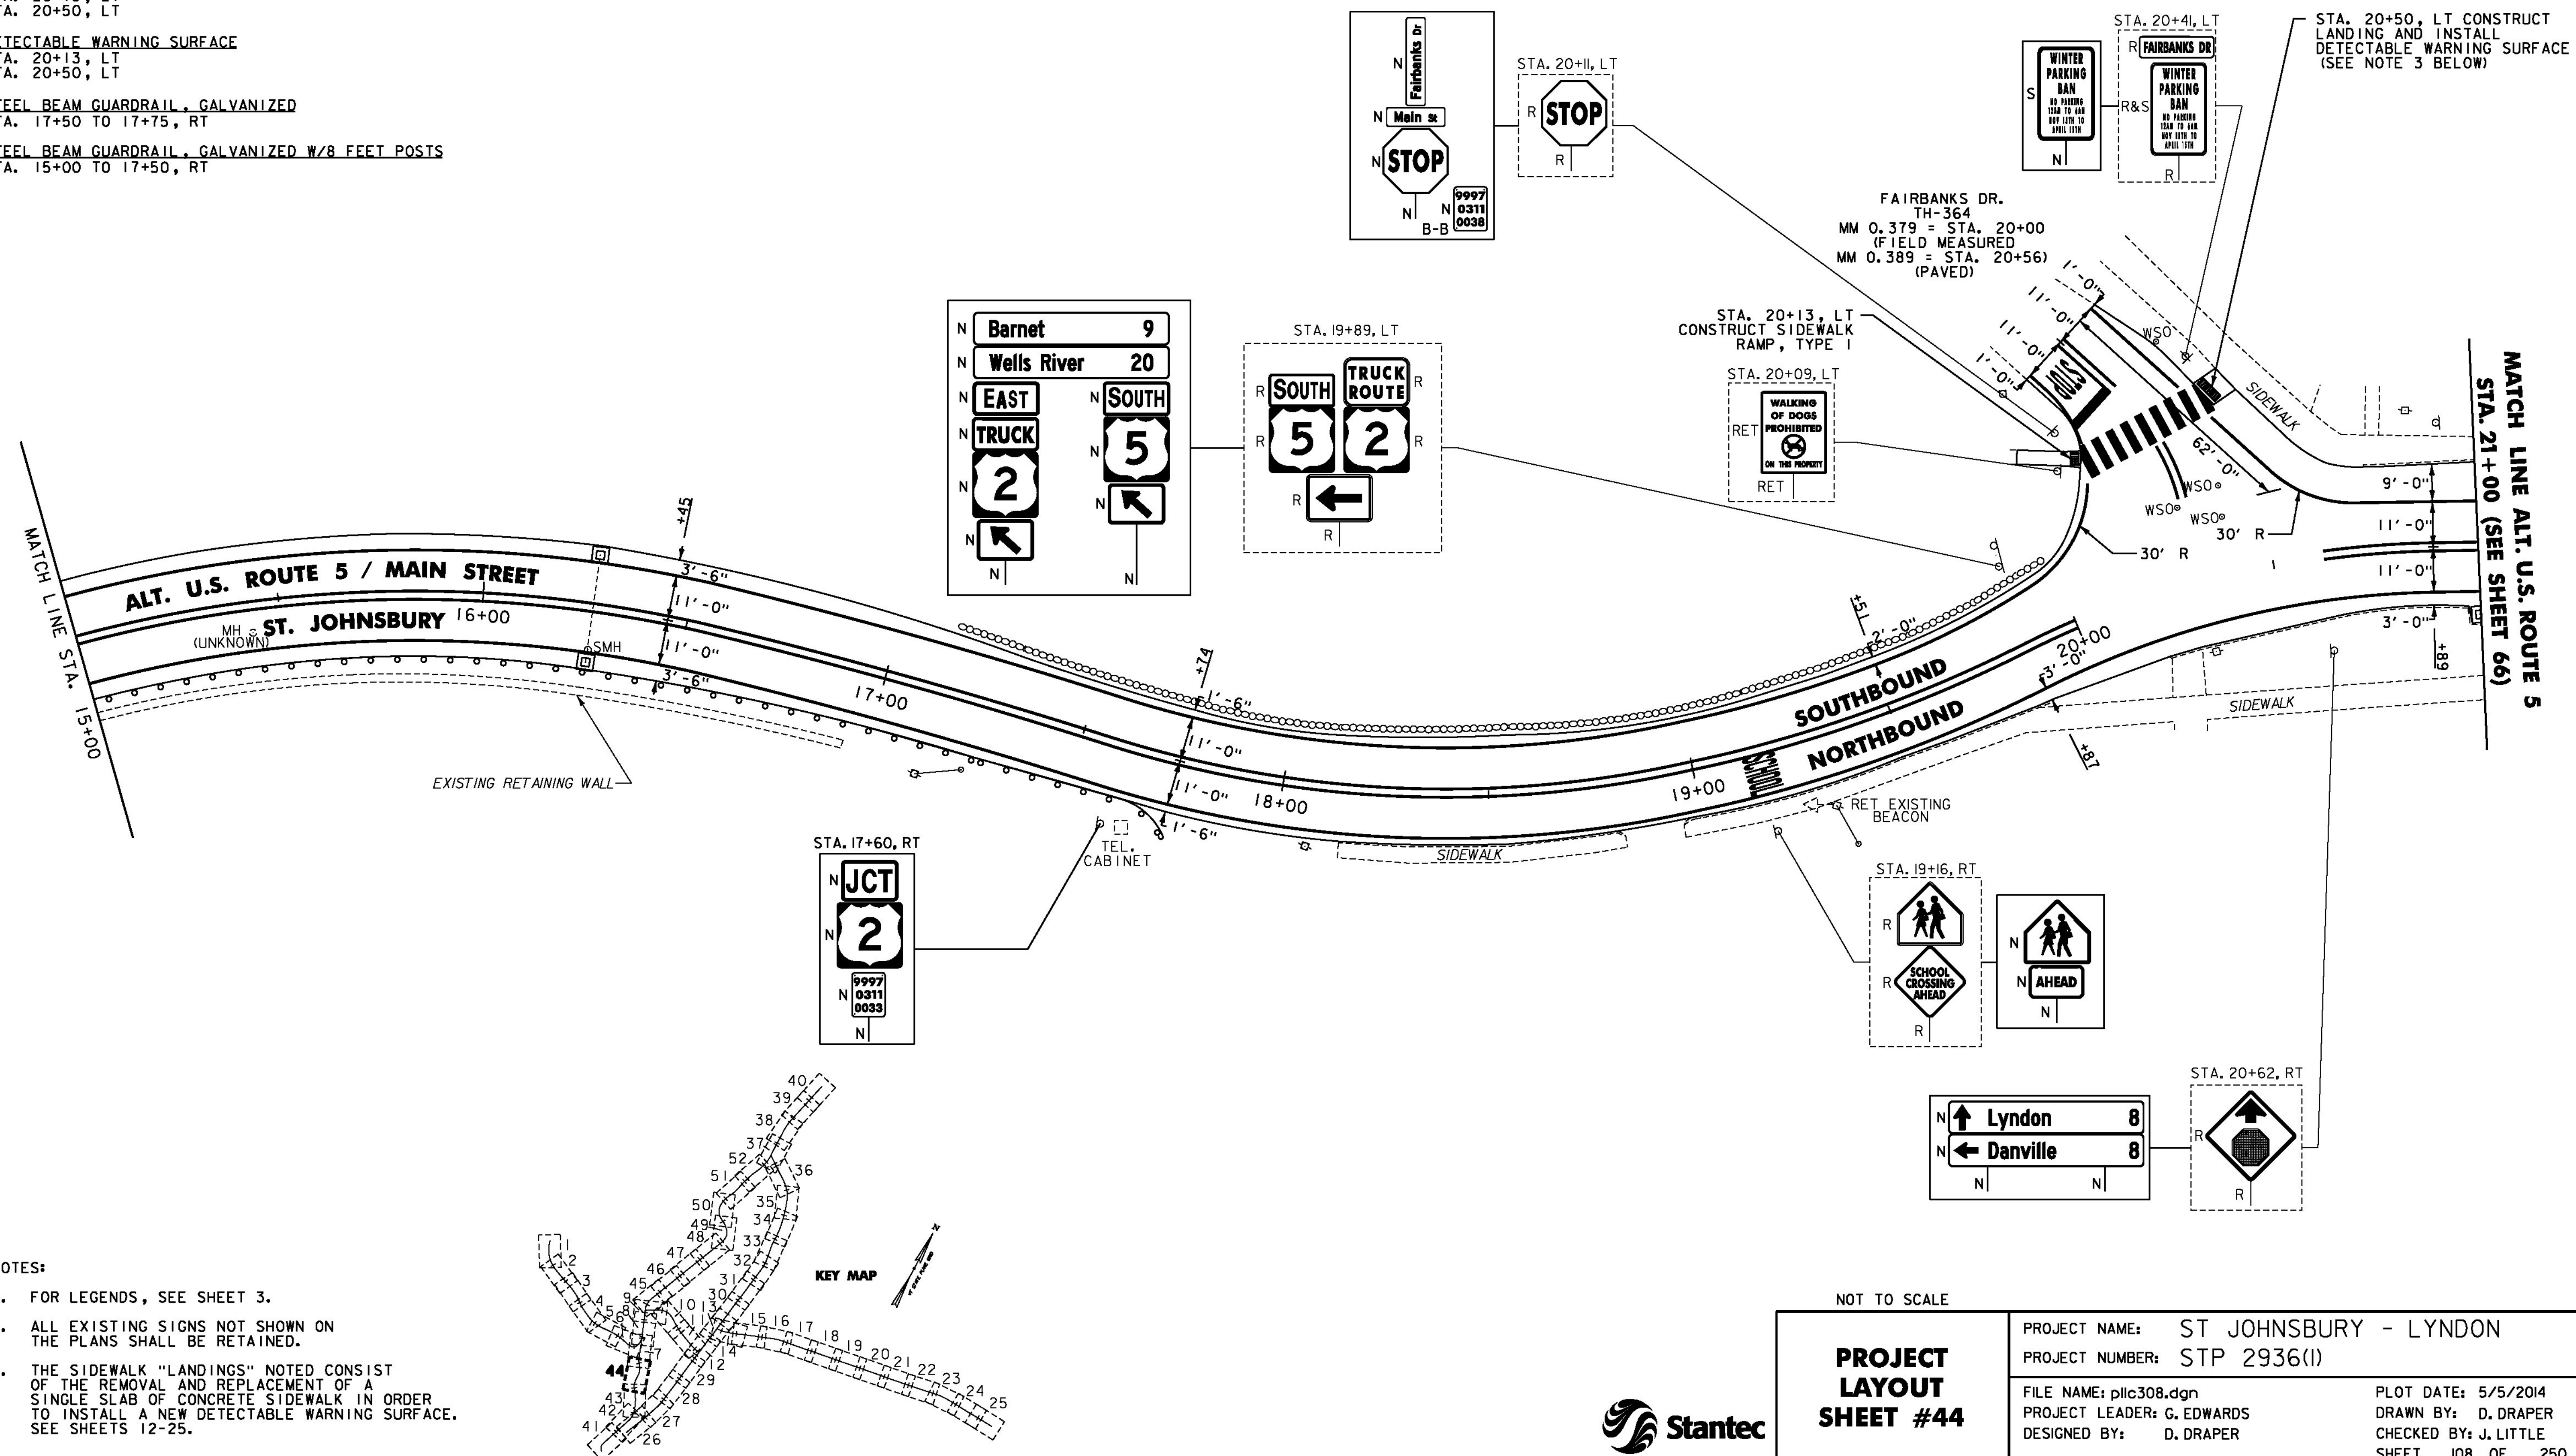

NOT TO SCALE

PROJECT LAYOUT SHEET #44

PROJECT NAME:	ST JOHNSBURY - LYNDON
PROJECT NUMBER:	STP 2936(I)

FILE NAME: pll308.dgn
PROJECT LEADER: G. EDWARDS
DESIGNED BY: D. DRAPER

PLOT DATE: 5/5/2014
DRAWN BY: D. DRAPER
CHECKED BY: J. LITTLE
SHEET 108 OF 250

