

STA. 36+40, LT
SEE SHEET 241 (TYP.)
STA. 37+63, RT

REHAB.
DIS. CBS OR MHS. CLASS I, II, OR III
SEE SHEETS 27-28

CAST-IN-PLACE CONCRETE CURB.

TYPE B
STA. 37+47, LT

REMOVAL OF EXISTING CURB
STA. 37+47, LT

PORTLAND CEMENT
CONCRETE SIDEWALK, 5 INCH

STA. 36+37, LT
STA. 36+53, RT
STA. 36+61, RT
STA. 36+92, RT
STA. 37+47, LT
STA. 37+81, LT

DETECTABLE WARNING SURFACE

STA. 36+37, LT
STA. 36+53, RT
STA. 36+61, RT
STA. 36+92, RT
STA. 37+47, LT
STA. 37+81, LT

ADJUST ELEVATION OF VALVE BOX
SEE SHEETS 28-29

DURABLE & TEMPORARY 4 INCH WHITE LINE
(ALL LINES WILL INCLUDE EDGE LINE BREAKS
AND RADII FOR SIDE ROADS)
STA. 35+00 TO 40+00, SOLID LT & RT (EDGELINES & DIAGONALS)

DURABLE & TEMPORARY 4 INCH YELLOW LINE
(ALL LINES WILL INCLUDE 4 BREAKS FOR
SIDE ROADS & CROSSWALKS)
STA. 35+00 TO 40+00, SOLID LT & RT
STA. 36+76, DOUBLE SOLID RT (MAPLE ST.)
STA. 37+65, DOUBLE SOLID LT (WINTER ST. TH-324)

DURABLE & TEMPORARY 8 INCH WHITE LINE
STA. 36+61 TO 36+86, LT (HYDRANT)
SEE SHEET 55

DURABLE & TEMPORARY 24 INCH STOP BAR
STA. 36+76, RT (MAPLE ST.)
STA. 37+65, LT (WINTER ST. TH-324)


DURABLE & TEMPORARY LETTER OR SYMBOL
STA. 36+76, RT "STOP" (MAPLE ST.)
STA. 37+65, LT "STOP" (WINTER ST. TH-324)

DURABLE CROSSWALK MARKING, TYPE A TAPE
STA. 36+37, LT TO 36+53, RT
STA. 36+76, RT (MAPLE ST.)
STA. 37+65, LT (WINTER ST. TH-324)
SEE SHEET 55 (TYP.)

TEMPORARY CROSSWALK MARKING, PAINT
STA. 36+37, LT TO 36+53, RT
STA. 36+76, RT (MAPLE ST.)
STA. 37+65, LT (WINTER ST. TH-324)
SEE SHEET 55 (TYP.)

REMOVING SIGNS
AS SHOWN - 21

ERECTING SALVAGED SIGNS
AS SHOWN - 1

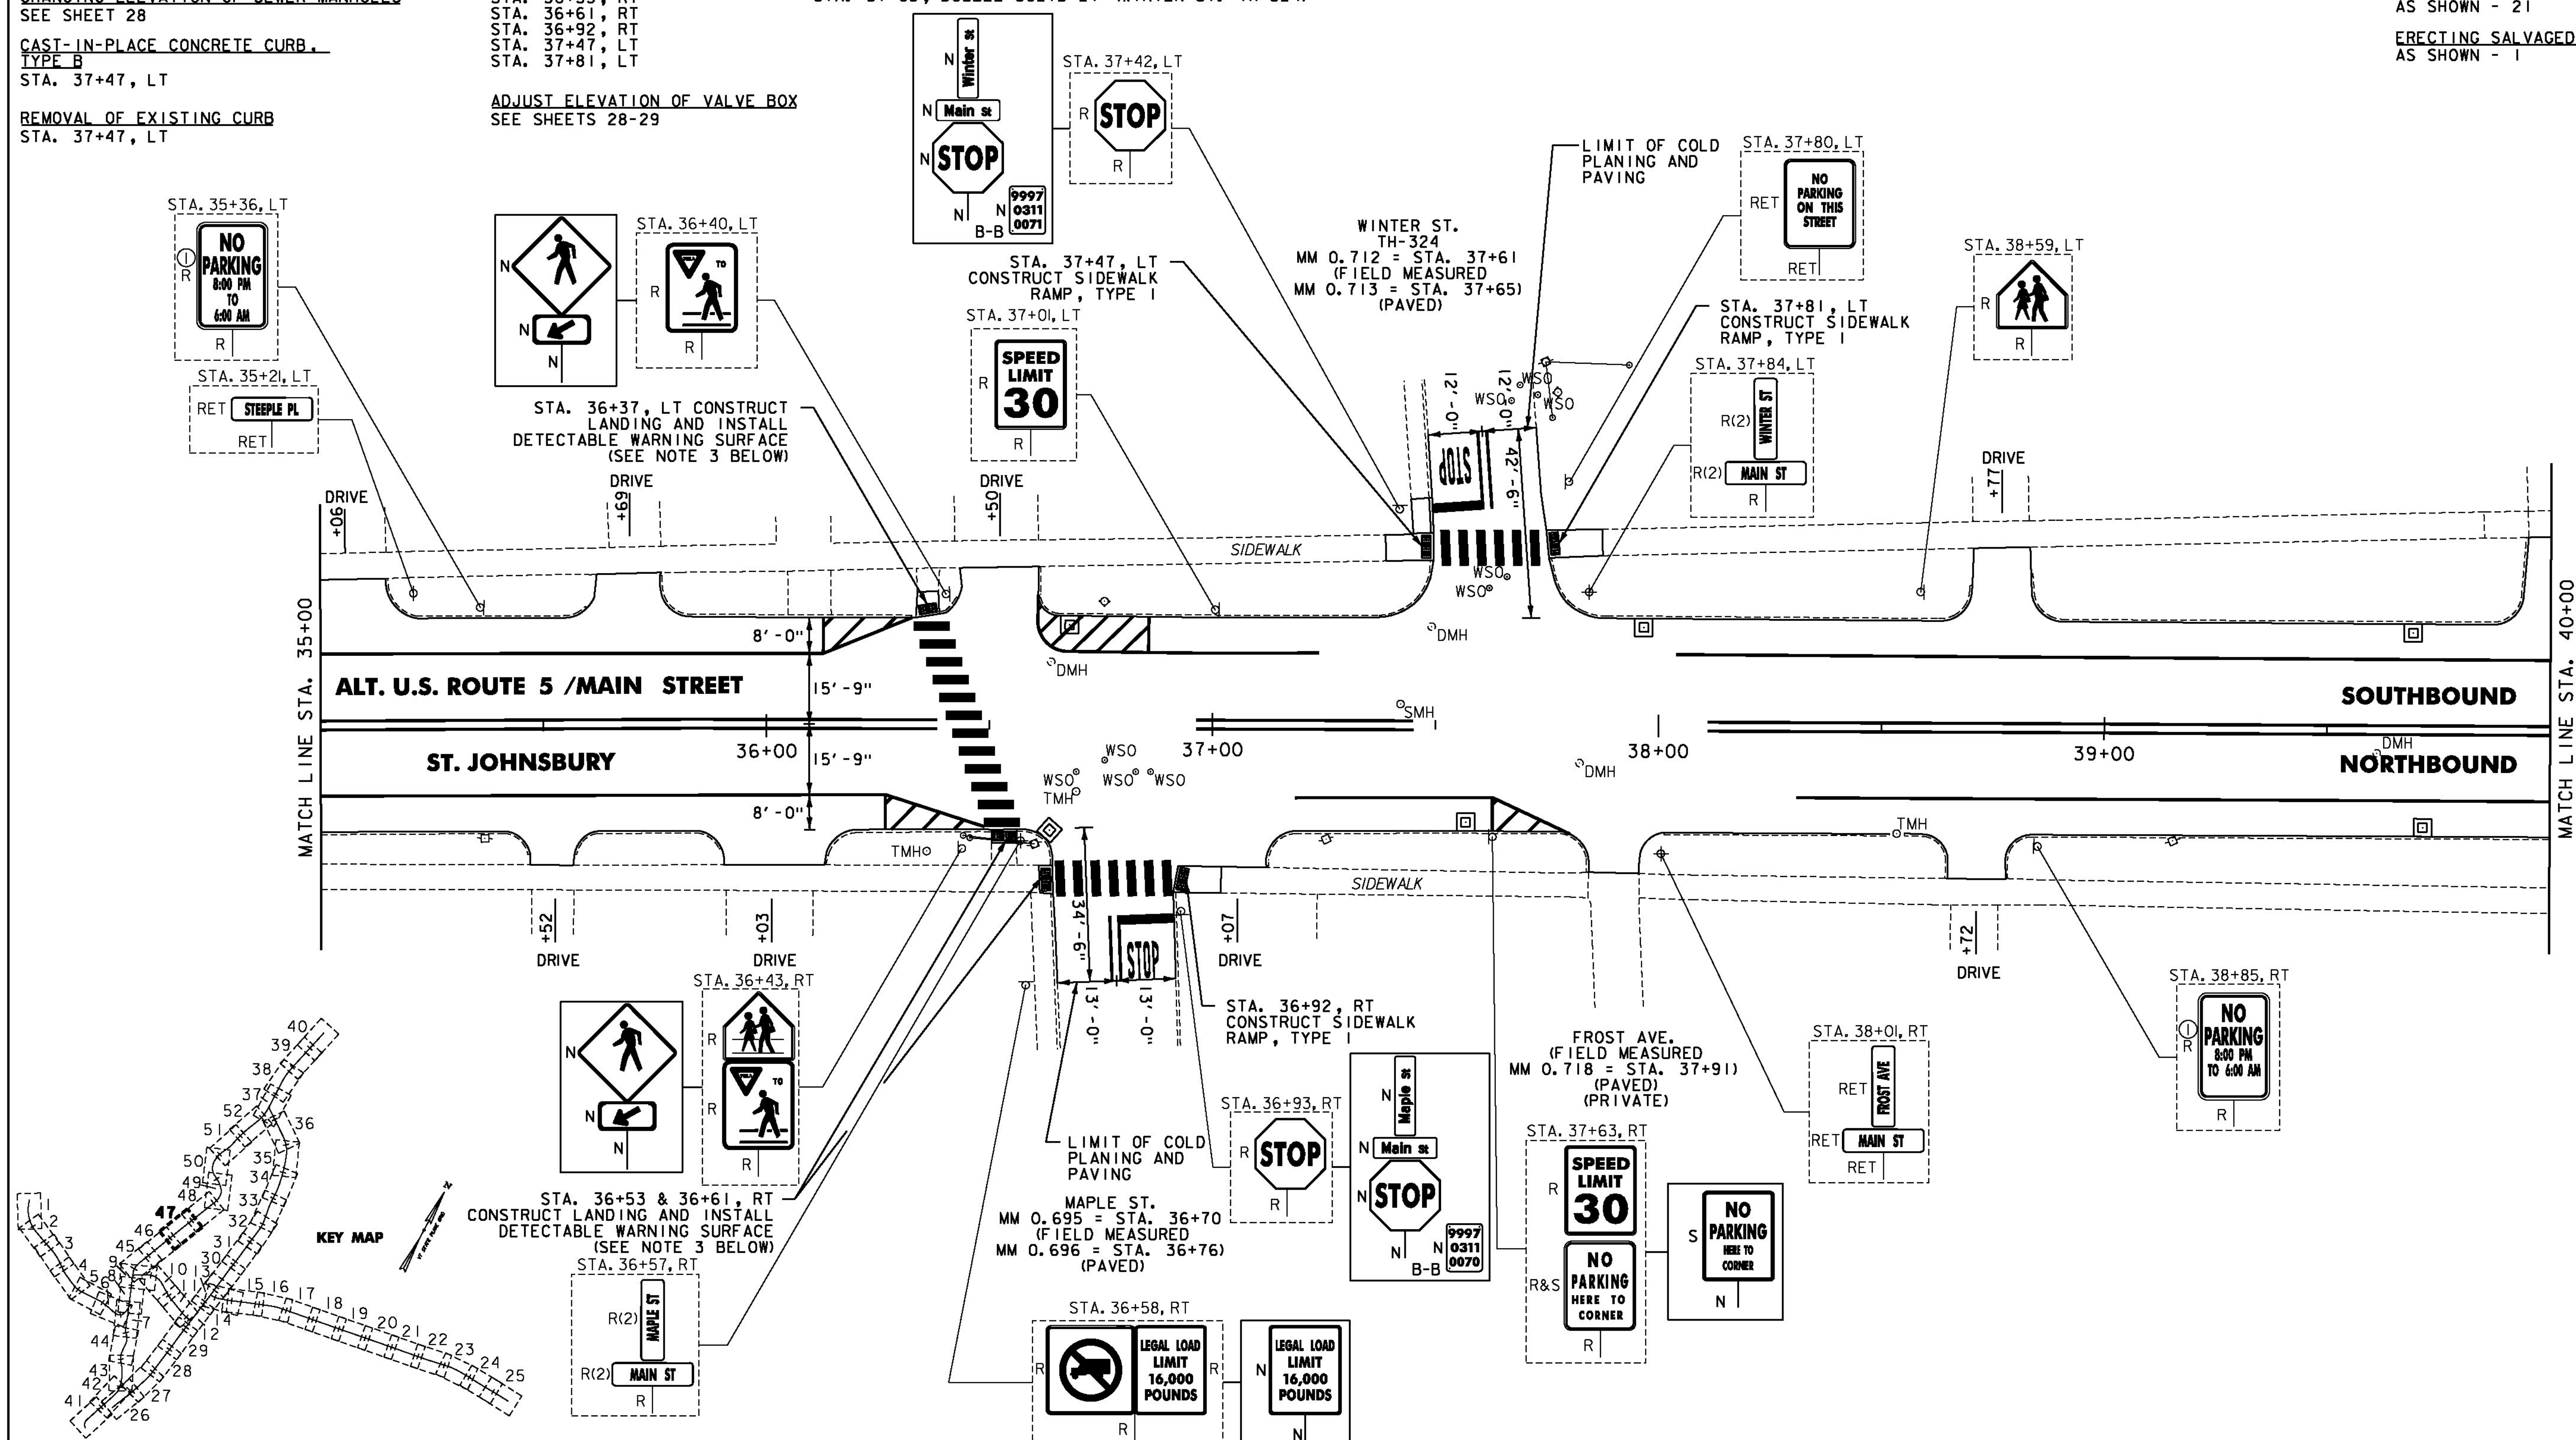

1. FOR LEGENDS, SEE SHEET 3.
2. ALL EXISTING SIGNS NOT SHOWN ON THE PLANS SHALL BE RETAINED.
3. THE SIDEWALK "LANDINGS" NOTED CONSIST OF THE REMOVAL AND REPLACEMENT OF A SINGLE SLAB OF CONCRETE SIDEWALK IN ORDER TO INSTALL A NEW DETECTABLE WARNING SURFACE. SEE SHEETS 12-25.

NOT TO SCALE

PROJECT LAYOUT SHEET #47



PROJECT NAME:	ST JOHNSBURY - LYNDON
PROJECT NUMBER:	STP 2936(I)

FILE NAME: plic308.dgn	PLOT DATE: 5/5/2014
PROJECT LEADER: G. EDWARDS	DRAWN BY: D. DRAPER
DESIGNED BY: D. DRAPER	CHECKED BY: J. LITTLE
	SHEET III OF 250