

THINNING AND TRIMMING FOR SIGNS

STA. 48+63, RT
SEE SHEET 241 (TYP.)

CHANGING ELEVATION OF DIS, CBS OR MHS
SEE SHEET 27

REHAB.
DIS, CBS OR MHS, CLASS I, II, OR III
SEE SHEETS 27-28

CHANGING ELEVATION OF SEWER MANHOLES
SEE SHEET 28

CAST-IN-PLACE CONCRETE CURB,
TYPE B
STA. 48+22, LT

REMOVAL OF EXISTING CURB
STA. 48+22, LT

PORTLAND CEMENT
CONCRETE SIDEWALK, 5 INCH
STA. 48+22, LT
STA. 48+35, RT
STA. 48+60, RT

DETECTABLE WARNING SURFACE
STA. 48+22, LT
STA. 48+35, RT
STA. 48+60, RT

ADJUST ELEVATION OF VALVE BOX
SEE SHEETS 28-29

DURABLE & TEMPORARY 4 INCH WHITE LINE

(ALL LINES WILL INCLUDE EDGE LINE BREAKS
AND RADII FOR SIDE ROADS)
STA. 45+00 TO 48+00, SOLID RT
STA. 45+00 TO 50+00, SOLID LT
STA. 45+00 TO 46+70, DOTTED RT
STA. 45+11, SOLID RT (EDGE LINES, MAIN ST. TH-404)
STA. 47+67 TO 50+00, DOTTED RT
STA. 48+37 TO 49+60, DOTTED LT
STA. 49+60 TO 50+00, SOLID LT (LANE LINE)

DURABLE & TEMPORARY 4 INCH YELLOW LINE

(ALL LINES WILL INCLUDE E BREAKS FOR
SIDE ROADS & CROSSWALKS)
STA. 45+00 TO 50+00, SOLID LT & RT
STA. 45+11, DOUBLE SOLID RT (MAIN ST. TH-404)
STA. 49+69, DOUBLE SOLID RT (MAIN ST. TH-310)

DURABLE & TEMPORARY 8 INCH WHITE LINE

STA. 47+99 TO 48+13, RT (HYDRANT)
SEE SHEET 55

DURABLE & TEMPORARY 24 INCH STOP BAR

STA. 45+11, RT (MAIN ST. TH-404)
STA. 49+69, RT (MAIN ST. TH-310)

DURABLE & TEMPORARY LETTER OR SYMBOL

STA. 45+11, RT "STOP" (MAIN ST. TH-404)
STA. 49+64, LT ARROW
STA. 49+69, RT "STOP" (MAIN ST. TH-310)


DURABLE CROSSWALK MARKING, TYPE A TAPE

STA. 48+16, RT (BOYNTON AVE. TH-364)
STA. 48+24, LT TO 48+57, RT
SEE SHEET 55 (TYP.)

TEMPORARY CROSSWALK MARKING, PAINT

STA. 48+16, RT (BOYNTON AVE. TH-364)
STA. 48+24, LT TO 48+57, RT
SEE SHEET 55 (TYP.)

REMOVING SIGNS
AS SHOWN - 16

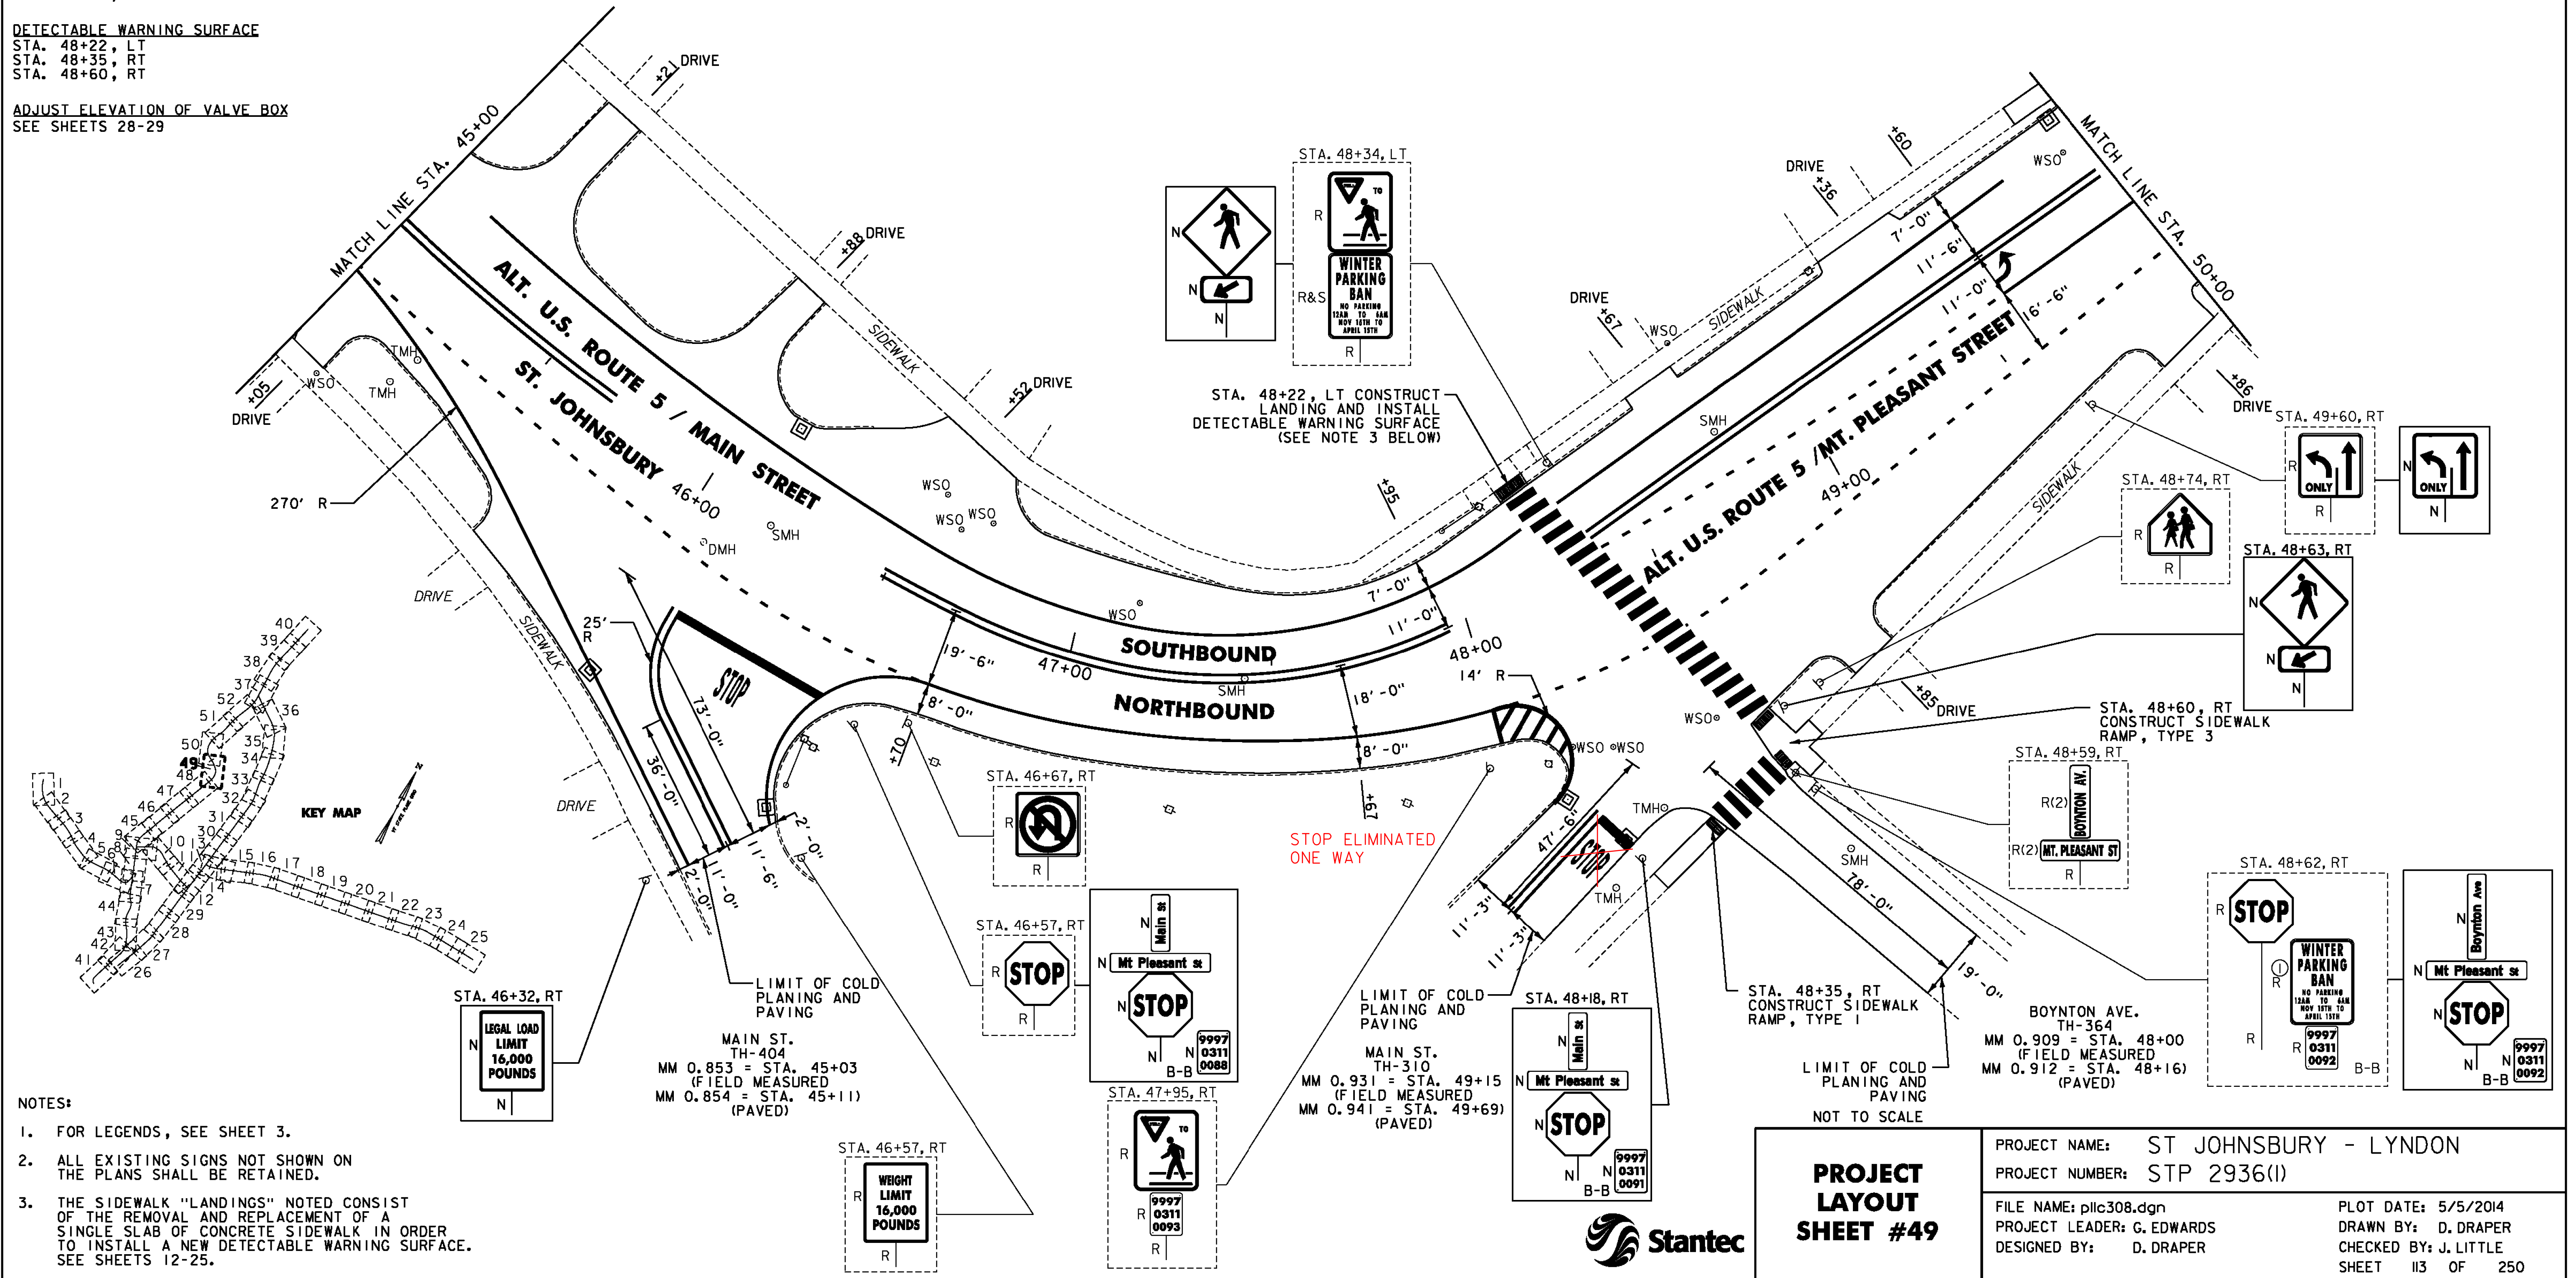

- NOTES:**
- FOR LEGENDS, SEE SHEET 3.
 - ALL EXISTING SIGNS NOT SHOWN ON THE PLANS SHALL BE RETAINED.
 - THE SIDEWALK "LANDINGS" NOTED CONSIST OF THE REMOVAL AND REPLACEMENT OF A SINGLE SLAB OF CONCRETE SIDEWALK IN ORDER TO INSTALL A NEW DETECTABLE WARNING SURFACE. SEE SHEETS 12-25.

	PROJECT LAYOUT SHEET #49	
	PROJECT NAME: ST JOHNSBURY - LYNDON PROJECT NUMBER: STP 2936(I)	
	FILE NAME: pllc308.dgn PROJECT LEADER: G. EDWARDS DESIGNED BY: D. DRAPER	PLOT DATE: 5/5/2014 DRAWN BY: D. DRAPER CHECKED BY: J. LITTLE SHEET 113 OF 250