

REHAB,
Dis. CBs OR MHs, CLASS I, II OR III
SEE SHEETS 27-28


CHANGING ELEVATION OF SEWER MANHOLES
SEE SHEET 28

DURABLE & TEMPORARY 4 INCH WHITE LINE
(ALL LINES WILL INCLUDE EDGE LINE BREAKS
AND RADII FOR SIDE ROADS)
STA. 164+50 TO 169+00, SOLID LT & RT

DURABLE & TEMPORARY 4 INCH YELLOW LINE
(ALL LINES WILL INCLUDE G BREAKS FOR SIDE ROADS)
STA. 164+50 TO 169+00, SOLID LT & RT

DURABLE & TEMPORARY 8 INCH WHITE LINE
STA. 166+95 TO 167+07, RT (HYDRANT)
SEE SHEET 55

REMOVING SIGNS
AS SHOWN - 2

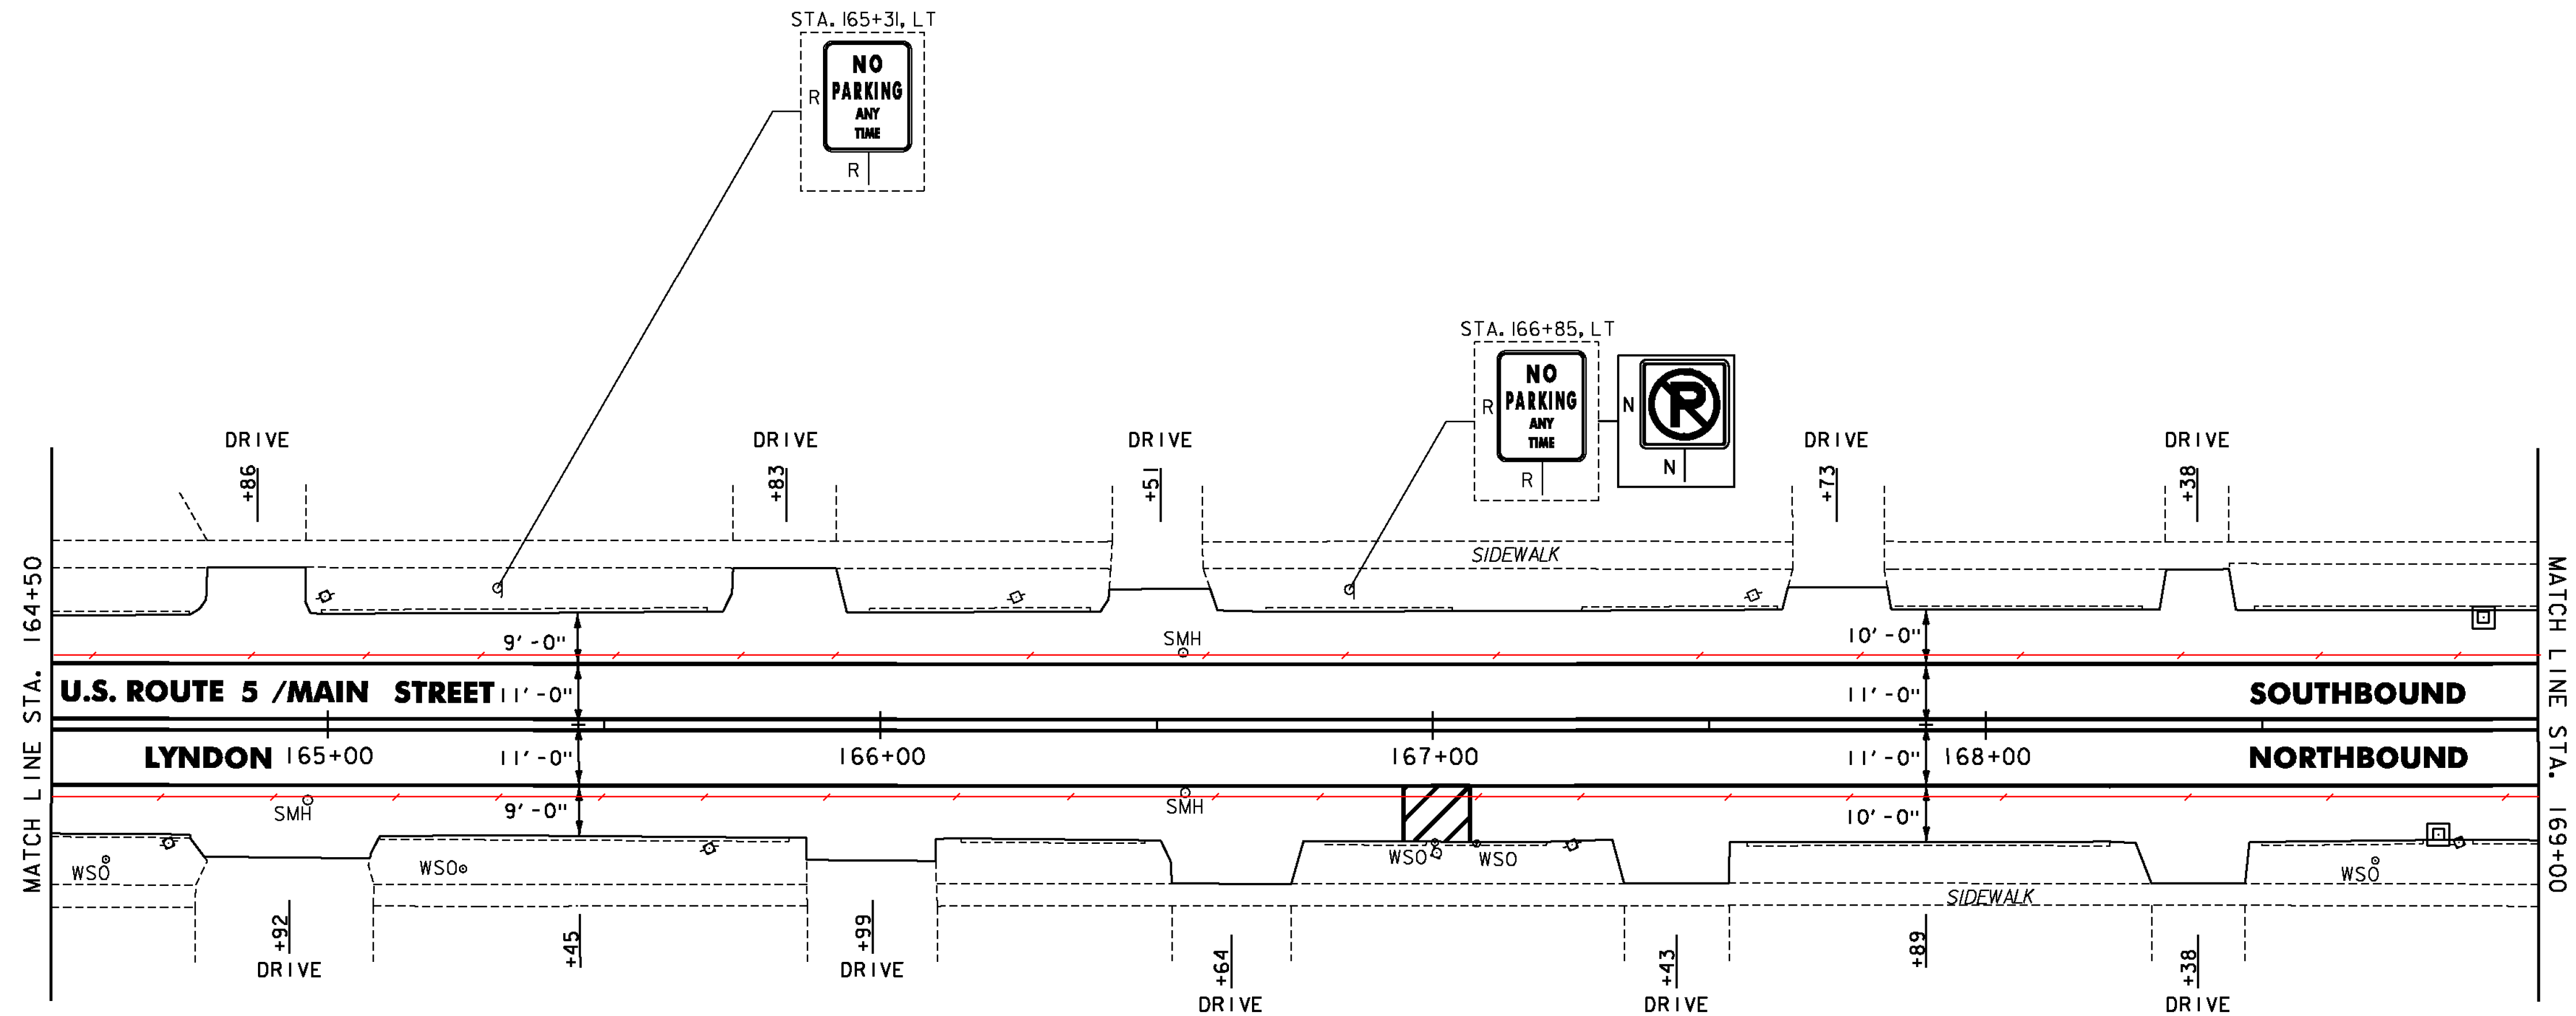

- NOTES:
- FOR LEGENDS, SEE SHEET 3.
 - ALL EXISTING SIGNS NOT SHOWN ON THE PLANS SHALL BE RETAINED.



NOT TO SCALE	
PROJECT LAYOUT SHEET #59	PROJECT NAME: ST JOHNSBURY - LYNDON
	PROJECT NUMBER: STP 2936(I)
	FILE NAME: pllc308.dgn PROJECT LEADER: G. EDWARDS DESIGNED BY: D. DRAPER
	PLOT DATE: 5/5/2014 DRAWN BY: D. DRAPER CHECKED BY: J. LITTLE SHEET 126 OF 250