


REHAB,
DIS, CBS OR MHS, CLASS I, II OR III
SEE SHEETS 27-28
PORTLAND CEMENT
CONCRETE SIDEWALK, 5 INCH
STA. 176+72, LT
DETECTABLE WARNING SURFACE
STA. 176+72, LT

DURABLE & TEMPORARY 4 INCH WHITE LINE
(ALL LINES WILL INCLUDE EDGE LINE BREAKS
AND RADI FOR SIDE ROADS)
STA. 174+50 TO 180+00, SOLID LT & RT
DURABLE & TEMPORARY 4 INCH YELLOW LINE
(ALL LINES WILL INCLUDE & BREAKS FOR SIDE ROADS & CROSSWALKS)
STA. 174+50 TO 180+00, SOLID LT & RT

DURABLE CROSSWALK MARKING, TYPE A TAPE
STA. 176+72, LT - RT
SEE SHEET 55 (TYP.)
TEMPORARY CROSSWALK MARKING, PAINT
STA. 176+72, LT - RT
SEE SHEET 55 (TYP.)

REMOVING SIGNS
AS SHOWN - 2

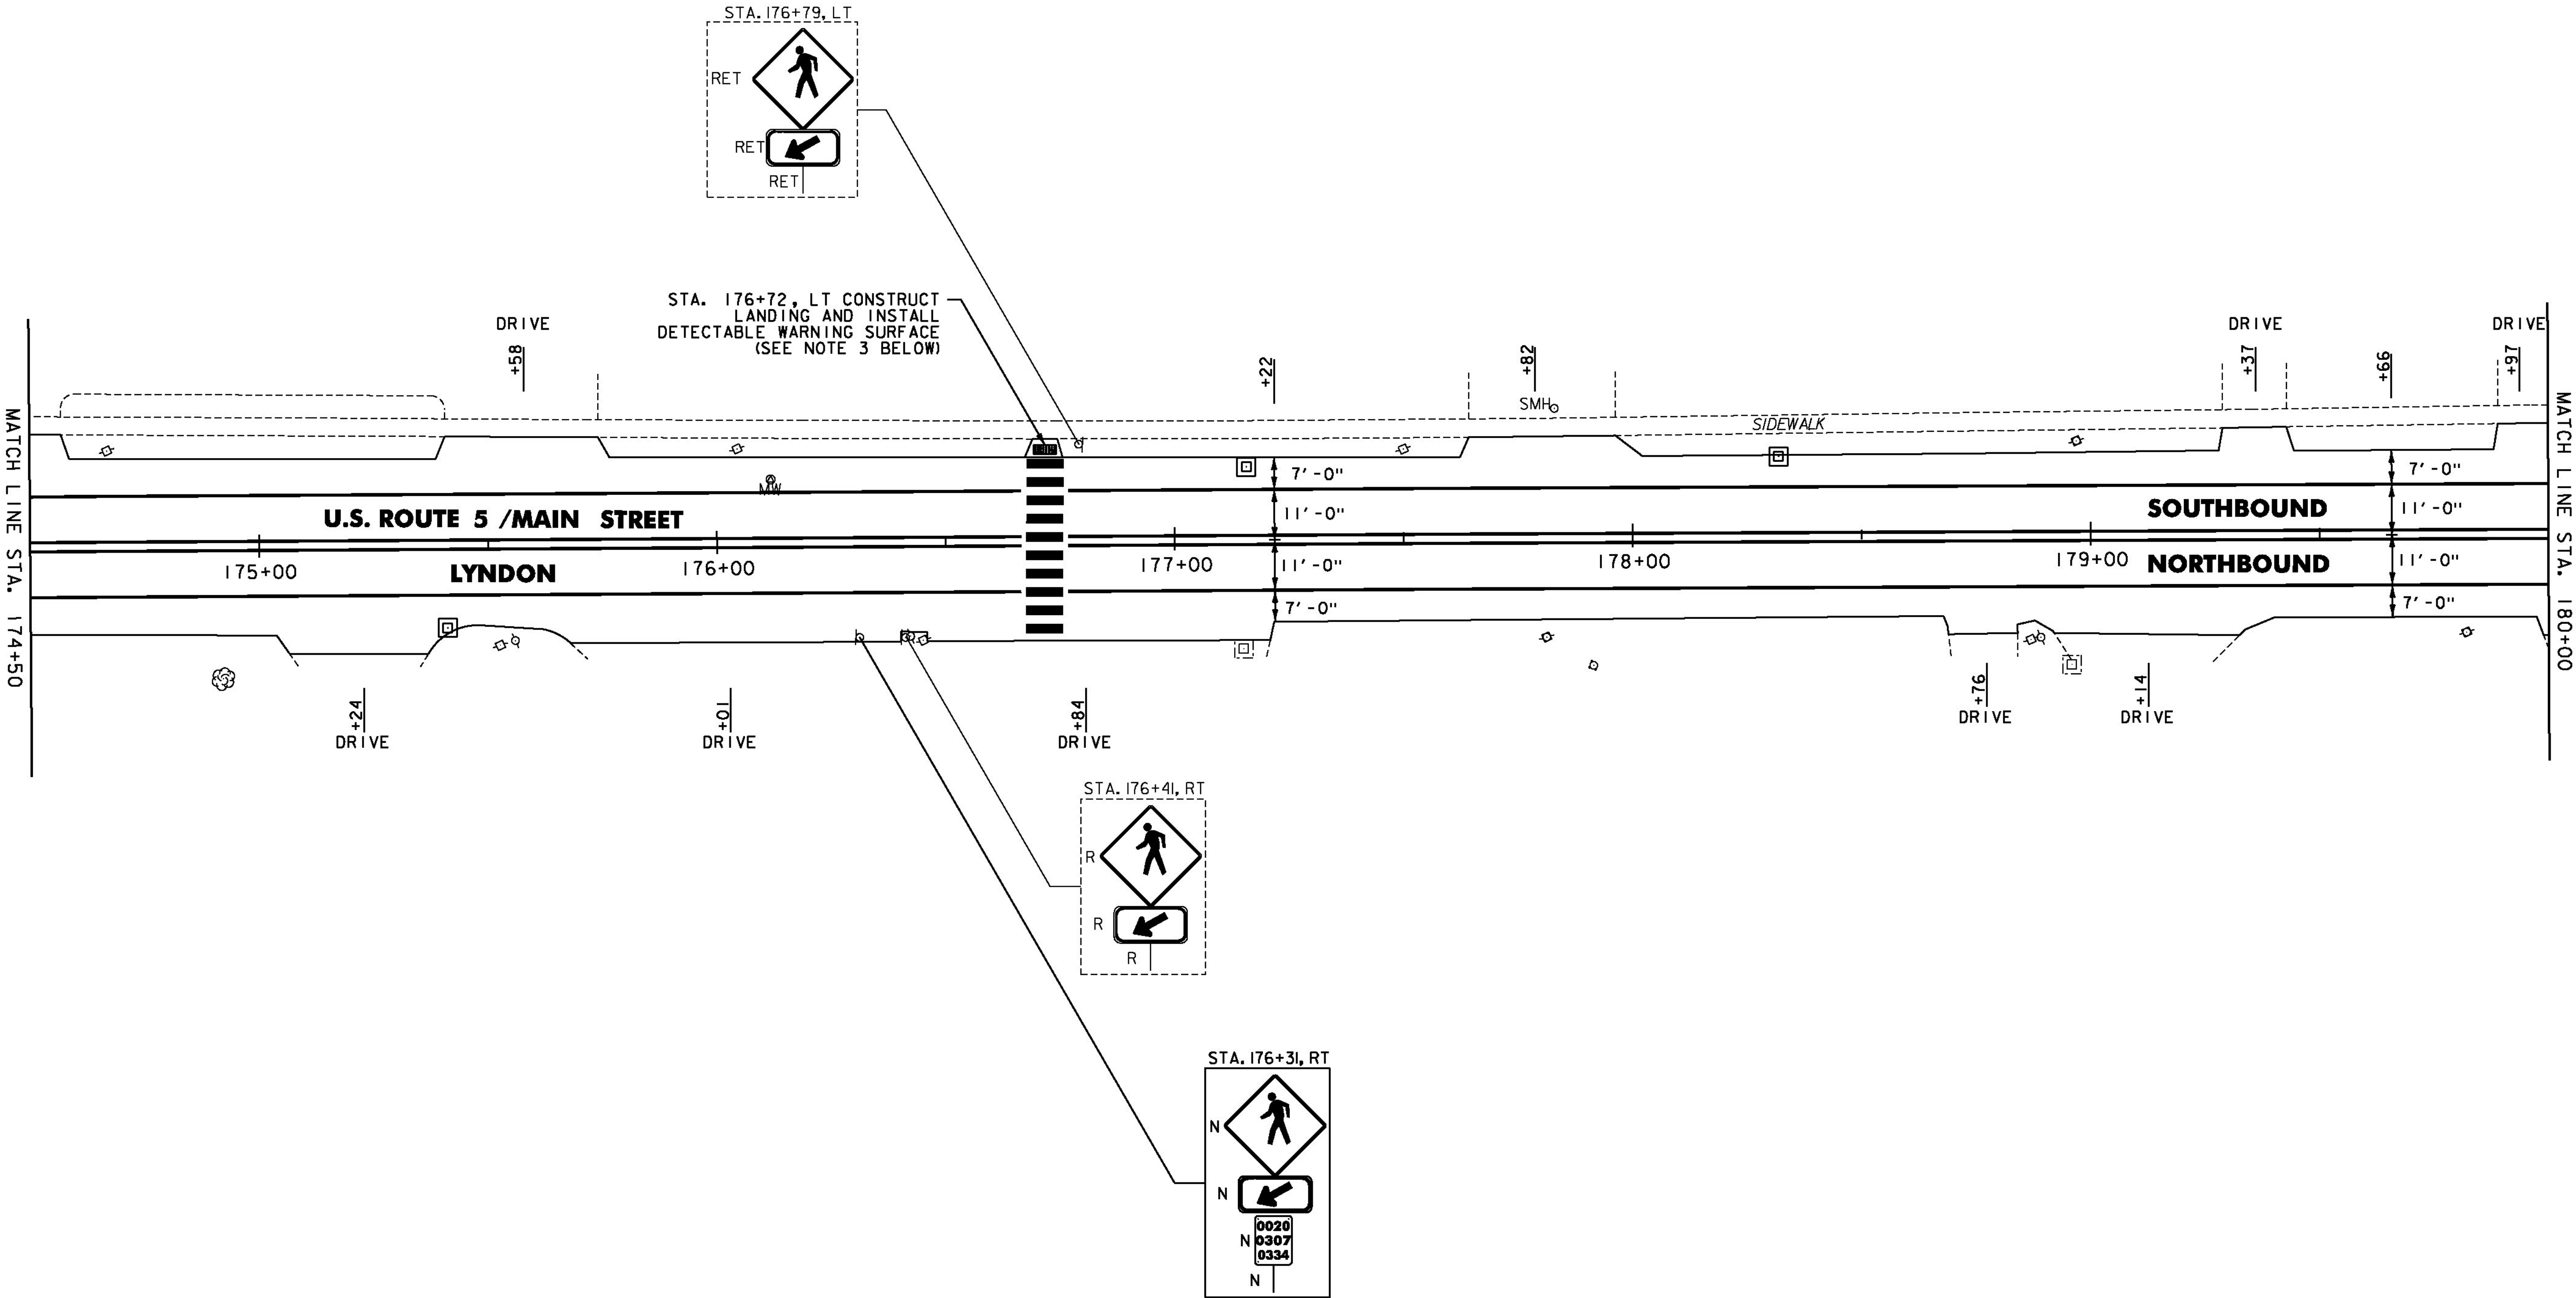

- NOTES:
- FOR LEGENDS, SEE SHEET 3.
 - ALL EXISTING SIGNS NOT SHOWN ON THE PLANS SHALL BE RETAINED.
 - THE SIDEWALK "LANDINGS" NOTED CONSIST OF THE REMOVAL AND REPLACEMENT OF A SINGLE SLAB OF CONCRETE SIDEWALK IN ORDER TO INSTALL A NEW DETECTABLE WARNING SURFACE. SEE SHEETS 12-25.



PROJECT LAYOUT SHEET #61	NOT TO SCALE	
	PROJECT NAME: ST JOHNSBURY - LYNDON	
	PROJECT NUMBER: STP 2936(I)	
FILE NAME: pllc308.dgn		PLOT DATE: 5/5/2014
PROJECT LEADER: G. EDWARDS		DRAWN BY: D. DRAPER
DESIGNED BY: D. DRAPER		CHECKED BY: J. LITTLE
		SHEET 128 OF 250