

REHAB.
Dis, CBs OR MHS, CLASS 1, II OR III
SEE SHEETS 27-28

CHANGING ELEVATION OF SEWER MANHOLES
SEE SHEET 28

BITUMINOUS CONCRETE GUTTERS AND TRAFFIC ISLANDS

STA. 2+37, RT
SEE SHEET 56

PORTLAND CEMENT
CONCRETE SIDEWALK, 5 INCH

STA. 4+90, RT
STA. 5+02, LT
STA. 5+42, RT

DETECTABLE WARNING SURFACE

STA. 4+90, RT
STA. 5+02, LT
STA. 5+42, RT

ADJUST ELEVATION OF VALVE BOX
SEE SHEETS 28-29

DURABLE & TEMPORARY 4 INCH WHITE LINE

(ALL LINES WILL INCLUDE EDGE LINE BREAKS
AND RADIUS FOR SIDE ROADS)
STA. 1+00 TO 6+00, SOLID LT & RT
STA. 5+22, SOLID RT (PARKING SPACES & DIAGONALS, ELM ST.)
SEE SHEET 55

DURABLE & TEMPORARY 4 INCH YELLOW LINE

(ALL LINES WILL INCLUDE $\frac{1}{2}$ BREAKS FOR SIDE ROADS & CROSSWALKS)
STA. 1+00 TO 6+00, SOLID LT & RT
STA. 5+22, DOUBLE SOLID RT (ELM ST.)
STA. 5+26, DOUBLE SOLID LT (SOUTH ST.)

DURABLE & TEMPORARY 8 INCH WHITE LINE

STA. 4+73 TO 4+85, LT (HYDRANT)
SEE SHEET 55

DURABLE & TEMPORARY 24 INCH STOP BAR

STA. 5+22, RT (ELM ST.)
STA. 5+26, LT (SOUTH ST.)

DURABLE & TEMPORARY LETTER OR SYMBOL

STA. 5+22, RT "STOP" (ELM ST.)
STA. 5+26, LT "STOP" (SOUTH ST.)

DURABLE CROSSWALK MARKING, TYPE A TAPE

STA. 4+90, RT TO 5+02, LT
STA. 5+22, RT (ELM ST.)
SEE SHEET 55 (TYP.)


TEMPORARY CROSSWALK MARKING, PAINT

STA. 4+90, RT TO 5+02, LT
STA. 5+22, RT (ELM ST.)
SEE SHEET 55 (TYP.)

REMOVING SIGNS
AS SHOWN - 9

ERECTING SALVAGED SIGNS
AS SHOWN - 1

MATCH LINE ALT. VT. ROUTE 122
STA. 1+00 (SEE SHEET 120)

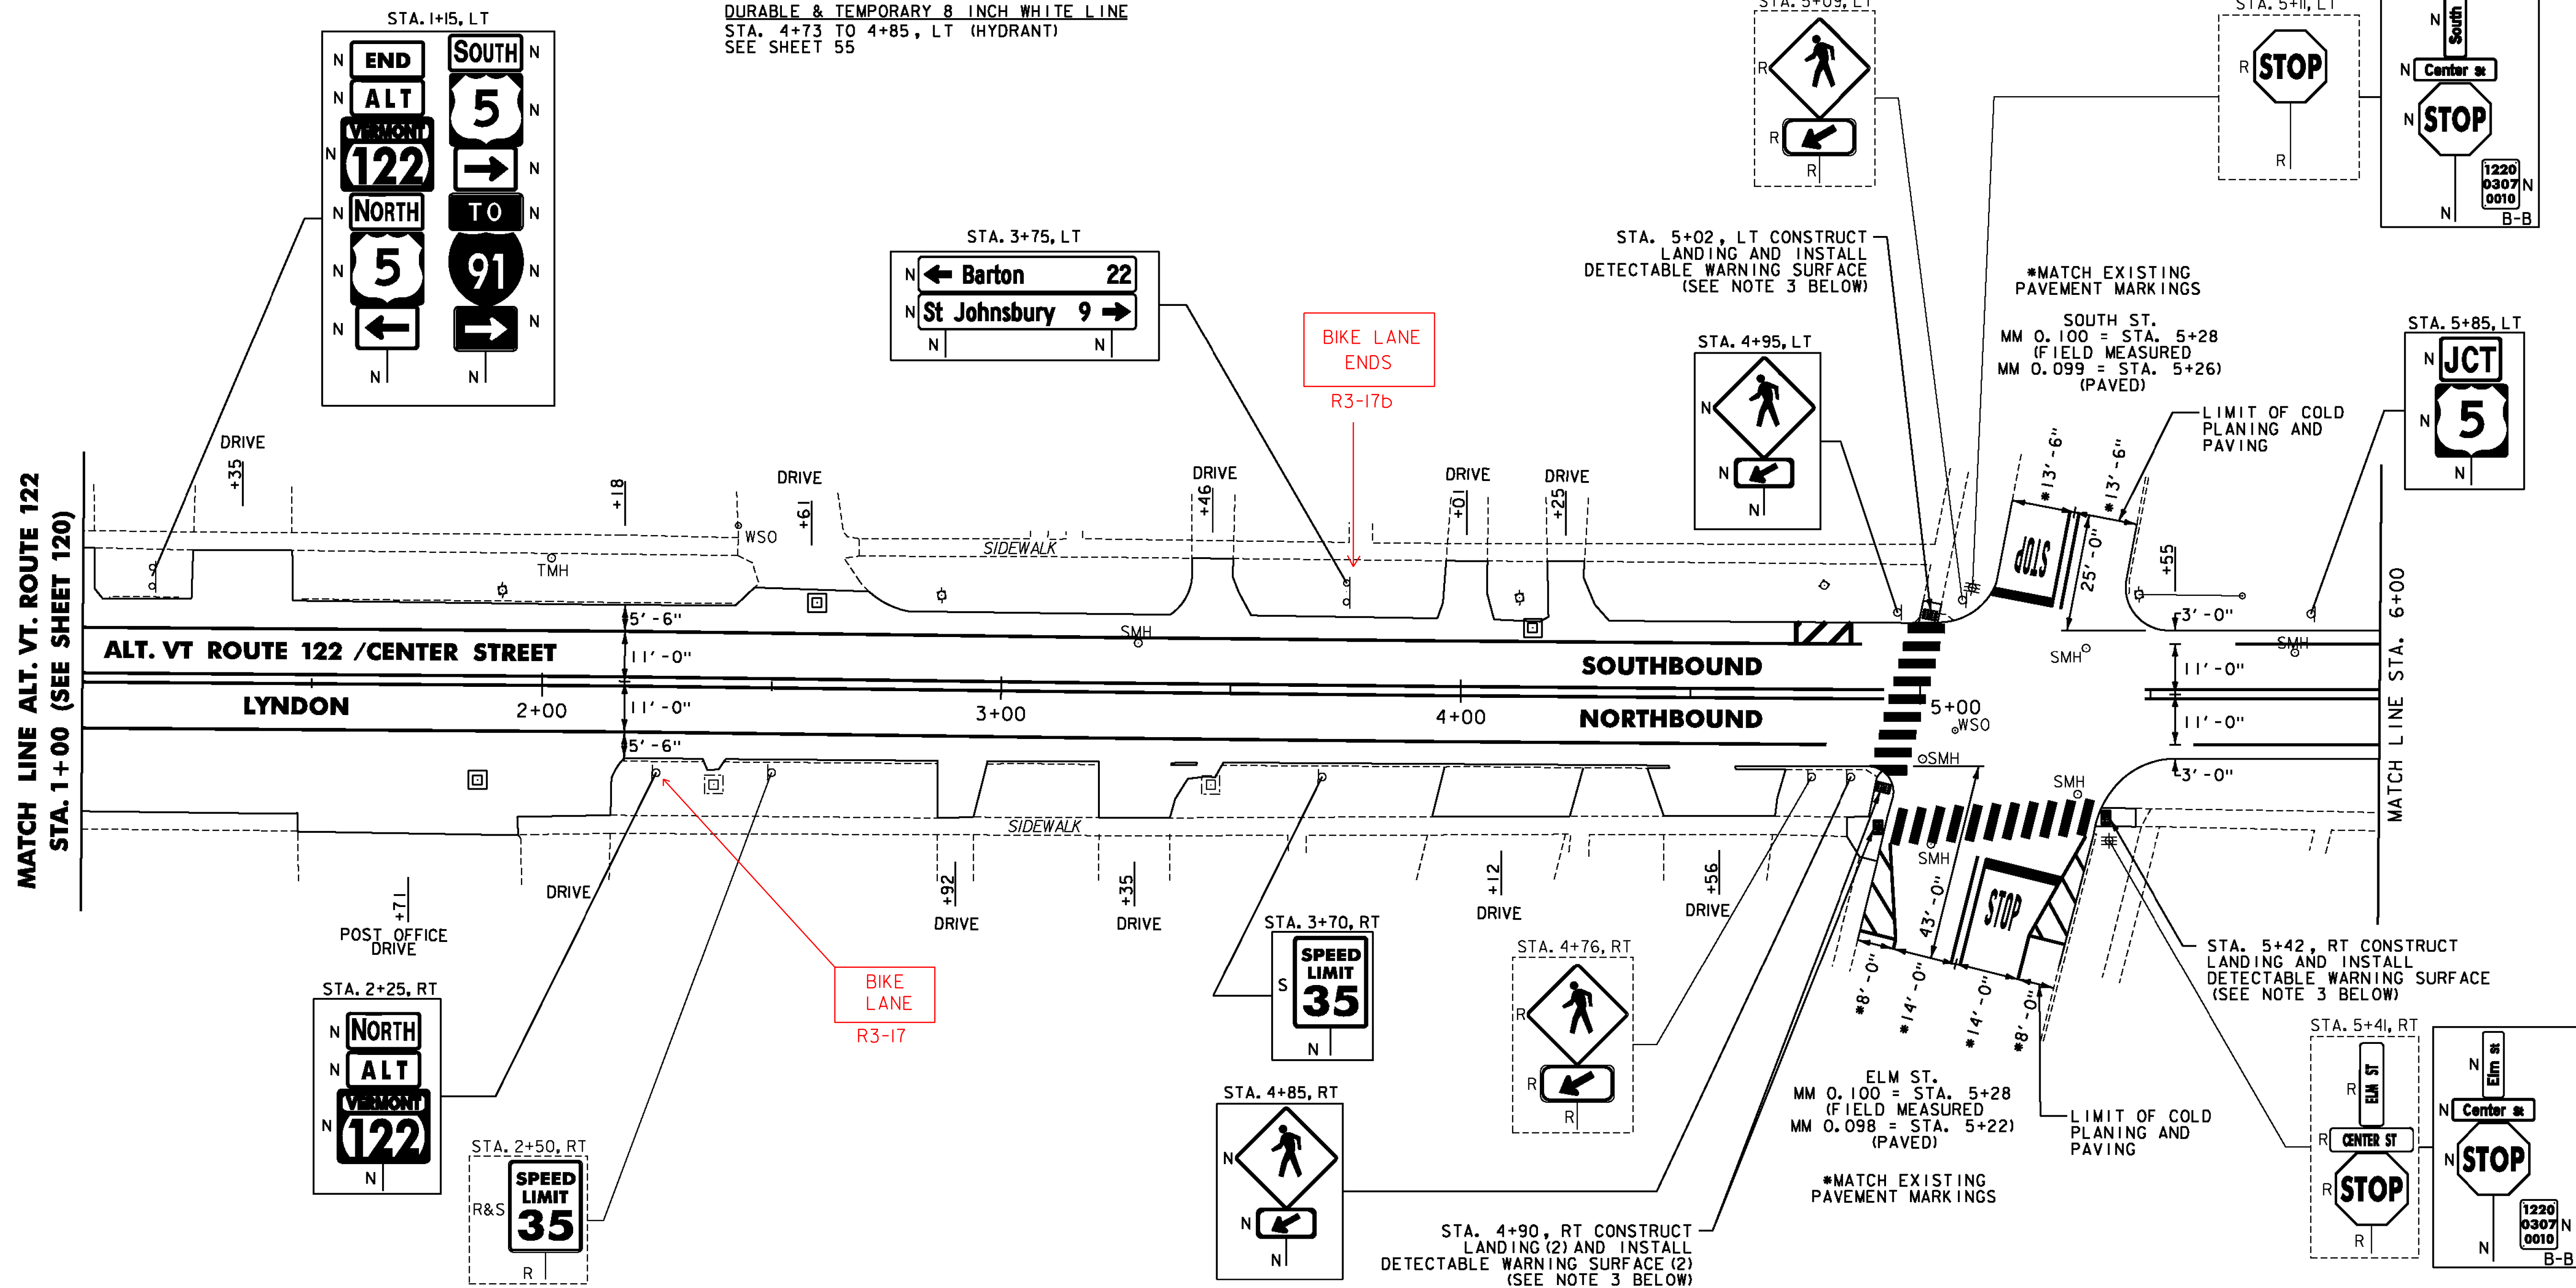

NOTES:

- FOR LEGENDS, SEE SHEET 3.
- ALL EXISTING SIGNS NOT SHOWN ON THE PLANS SHALL BE RETAINED.
- THE SIDEWALK "LANDINGS" NOTED CONSIST OF THE REMOVAL AND REPLACEMENT OF A SINGLE SLAB OF CONCRETE SIDEWALK IN ORDER TO INSTALL A NEW DETECTABLE WARNING SURFACE. SEE SHEETS 12-25.

NOT TO SCALE



PROJECT LAYOUT SHEET #64

PROJECT NAME: ST JOHNSBURY - LYNDON

PROJECT NUMBER: STP 2936(I)

FILE NAME: pllc308.dgn
PROJECT LEADER: G. EDWARDS
DESIGNED BY: D. DRAPER

PLOT DATE: 5/5/2014
DRAWN BY: D. DRAPER
CHECKED BY: J. LITTLE
SHEET 131 OF 250