

CHANGING ELEVATION OF Dis, CBs OR MHS
SEE SHEET 27

REHAB,
Dis, CBs OR MHS, CLASS I, II OR III
SEE SHEETS 27-28

CHANGING ELEVATION OF SEWER MANHOLES
SEE SHEET 28

PORTLAND CEMENT
CONCRETE SIDEWALK, 5 INCH
STA. 7+50, RT
STA. 8+10, RT

DETECTABLE WARNING SURFACE
STA. 7+50, RT
STA. 8+10, RT

ADJUST ELEVATION OF VALVE BOX
SEE SHEETS 28-29

DURABLE & TEMPORARY 4 INCH WHITE LINE
(ALL LINES WILL INCLUDE EDGE LINE BREAKS
AND RADII FOR SIDE ROADS)
STA. 6+00 TO 11+00, SOLID LT & RT
STA. 7+89, SOLID RT (EDGE LINES, MAIN ST.)

DURABLE & TEMPORARY 4 INCH YELLOW LINE
(ALL LINES WILL INCLUDE C BREAKS FOR SIDE ROADS)
STA. 6+00 TO 11+00, SOLID LT & RT
STA. 7+89, DOUBLE SOLID RT (MAIN ST.)


DURABLE & TEMPORARY 24 INCH STOP BAR
STA. 7+89, RT (MAIN ST.)

DURABLE & TEMPORARY LETTER OR SYMBOL
STA. 7+89, RT "STOP" (MAIN ST.)

DURABLE CROSSWALK MARKING, TYPE A TAPE
STA. 7+89, RT (MAIN ST.)
SEE SHEET 55 (TYP.)

TEMPORARY CROSSWALK MARKING, PAINT
STA. 7+89, RT (MAIN ST.)
SEE SHEET 55 (TYP.)

REMOVING SIGNS
AS SHOWN - 3

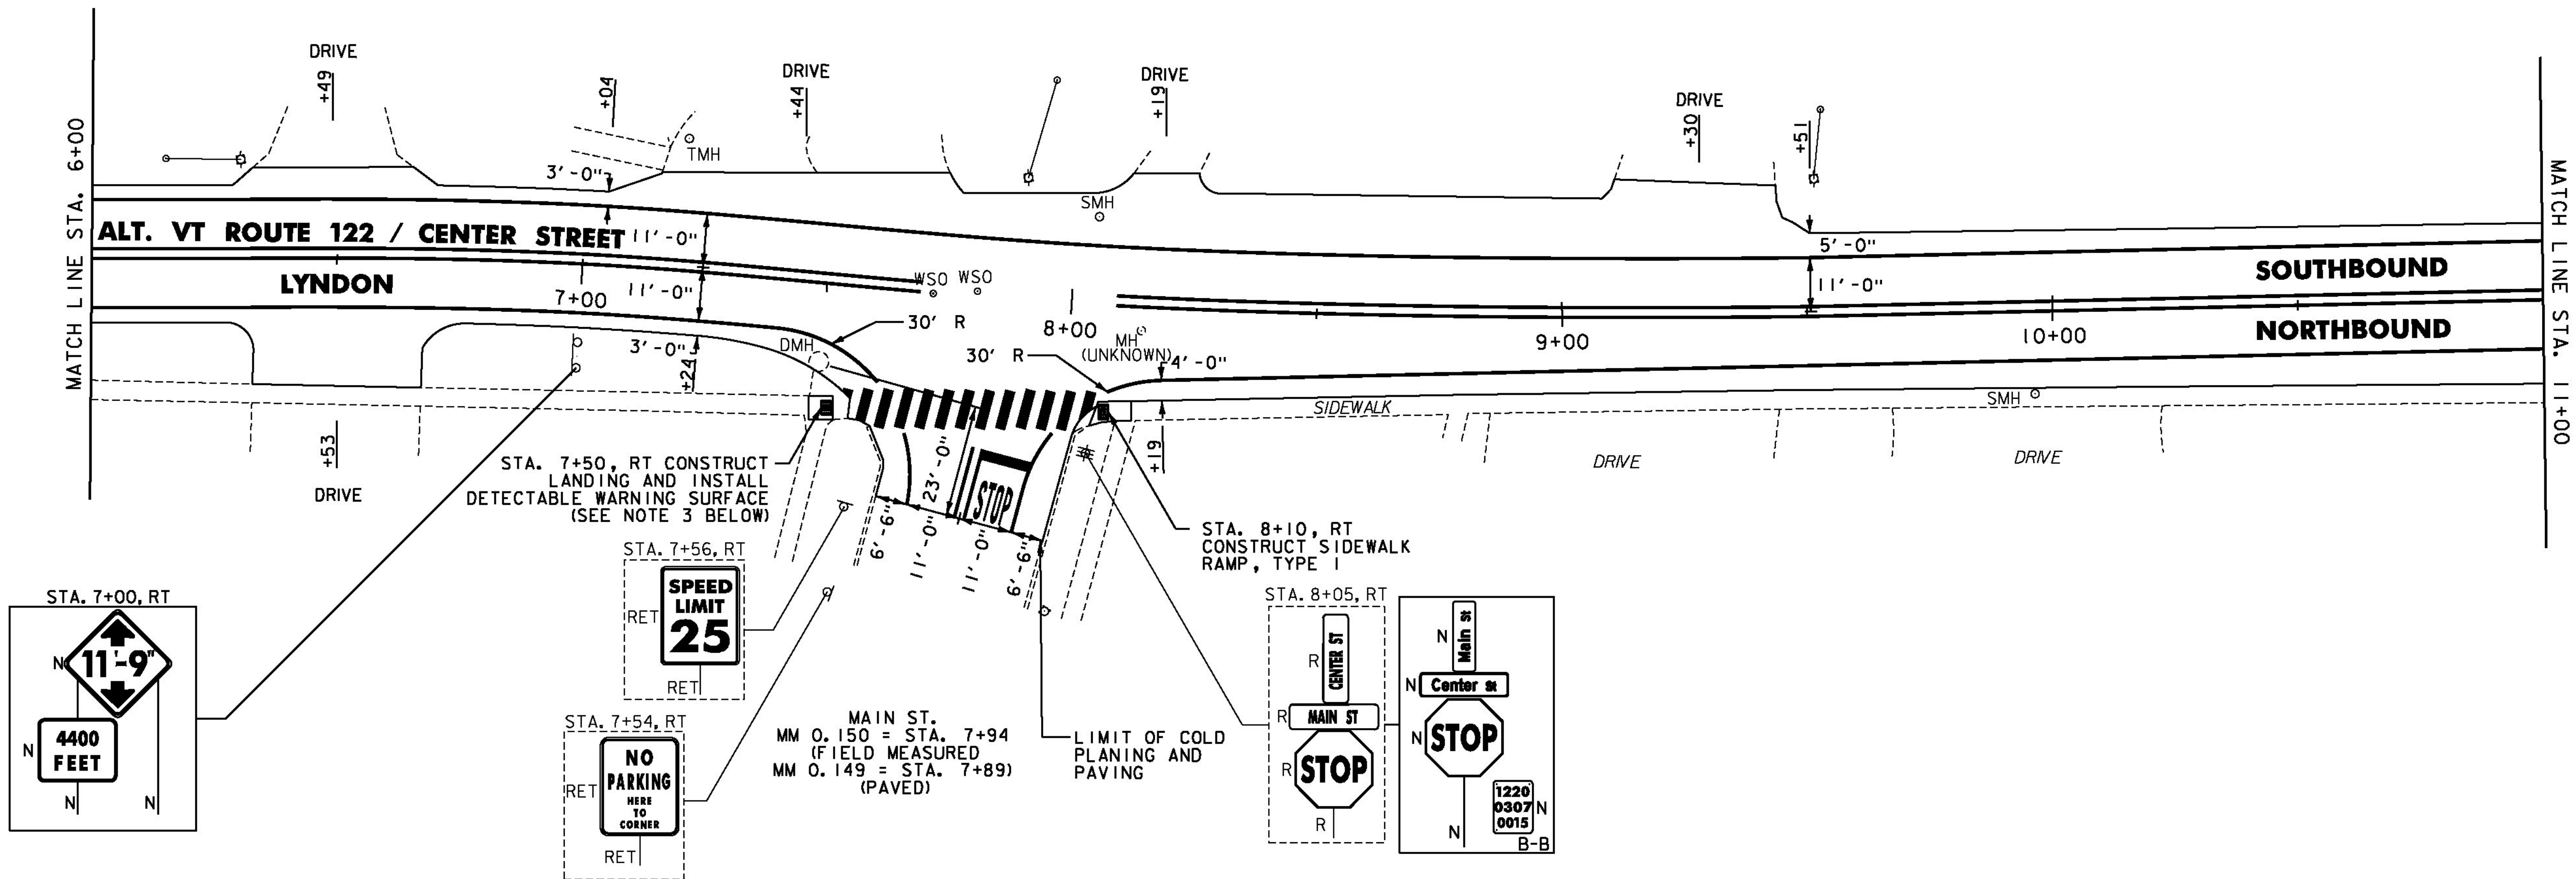

- NOTES:
- FOR LEGENDS, SEE SHEET 3.
 - ALL EXISTING SIGNS NOT SHOWN ON THE PLANS SHALL BE RETAINED.
 - THE SIDEWALK "LANDINGS" NOTED CONSIST OF THE REMOVAL AND REPLACEMENT OF A SINGLE SLAB OF CONCRETE SIDEWALK IN ORDER TO INSTALL A NEW DETECTABLE WARNING SURFACE. SEE SHEETS 12-25.

NOT TO SCALE



**PROJECT
LAYOUT
SHEET #65**

PROJECT NAME: ST JOHNSBURY - LYNDON
PROJECT NUMBER: STP 2936(I)

FILE NAME: plic308.dgn
PROJECT LEADER: G. EDWARDS
DESIGNED BY: D. DRAPER

PLOT DATE: 5/5/2014
DRAWN BY: D. DRAPER
CHECKED BY: J. LITTLE
SHEET 132 OF 250