

THINNING AND TRIMMING FOR SIGNS
STA. 17+80, RT
SEE SHEET 241 (TYP.)


DURABLE & TEMPORARY 4 INCH WHITE LINE
(ALL LINES WILL INCLUDE EDGE LINE BREAKS
AND RADII FOR SIDE ROADS)
STA. 16+25 TO 21+00, SOLID LT & RT

REMOVING SIGNS
AS SHOWN - 1

CHANGING ELEVATION OF Dis, CBs OR MHS
SEE SHEET 27

DURABLE & TEMPORARY 4 INCH YELLOW LINE
(ALL LINES WILL INCLUDE C BREAKS FOR SIDE ROADS)
STA. 16+25 TO 21+00, SOLID LT & RT

REHAB.
Dis, CBs OR MHS, CLASS I, II OR III
SEE SHEETS 27-28

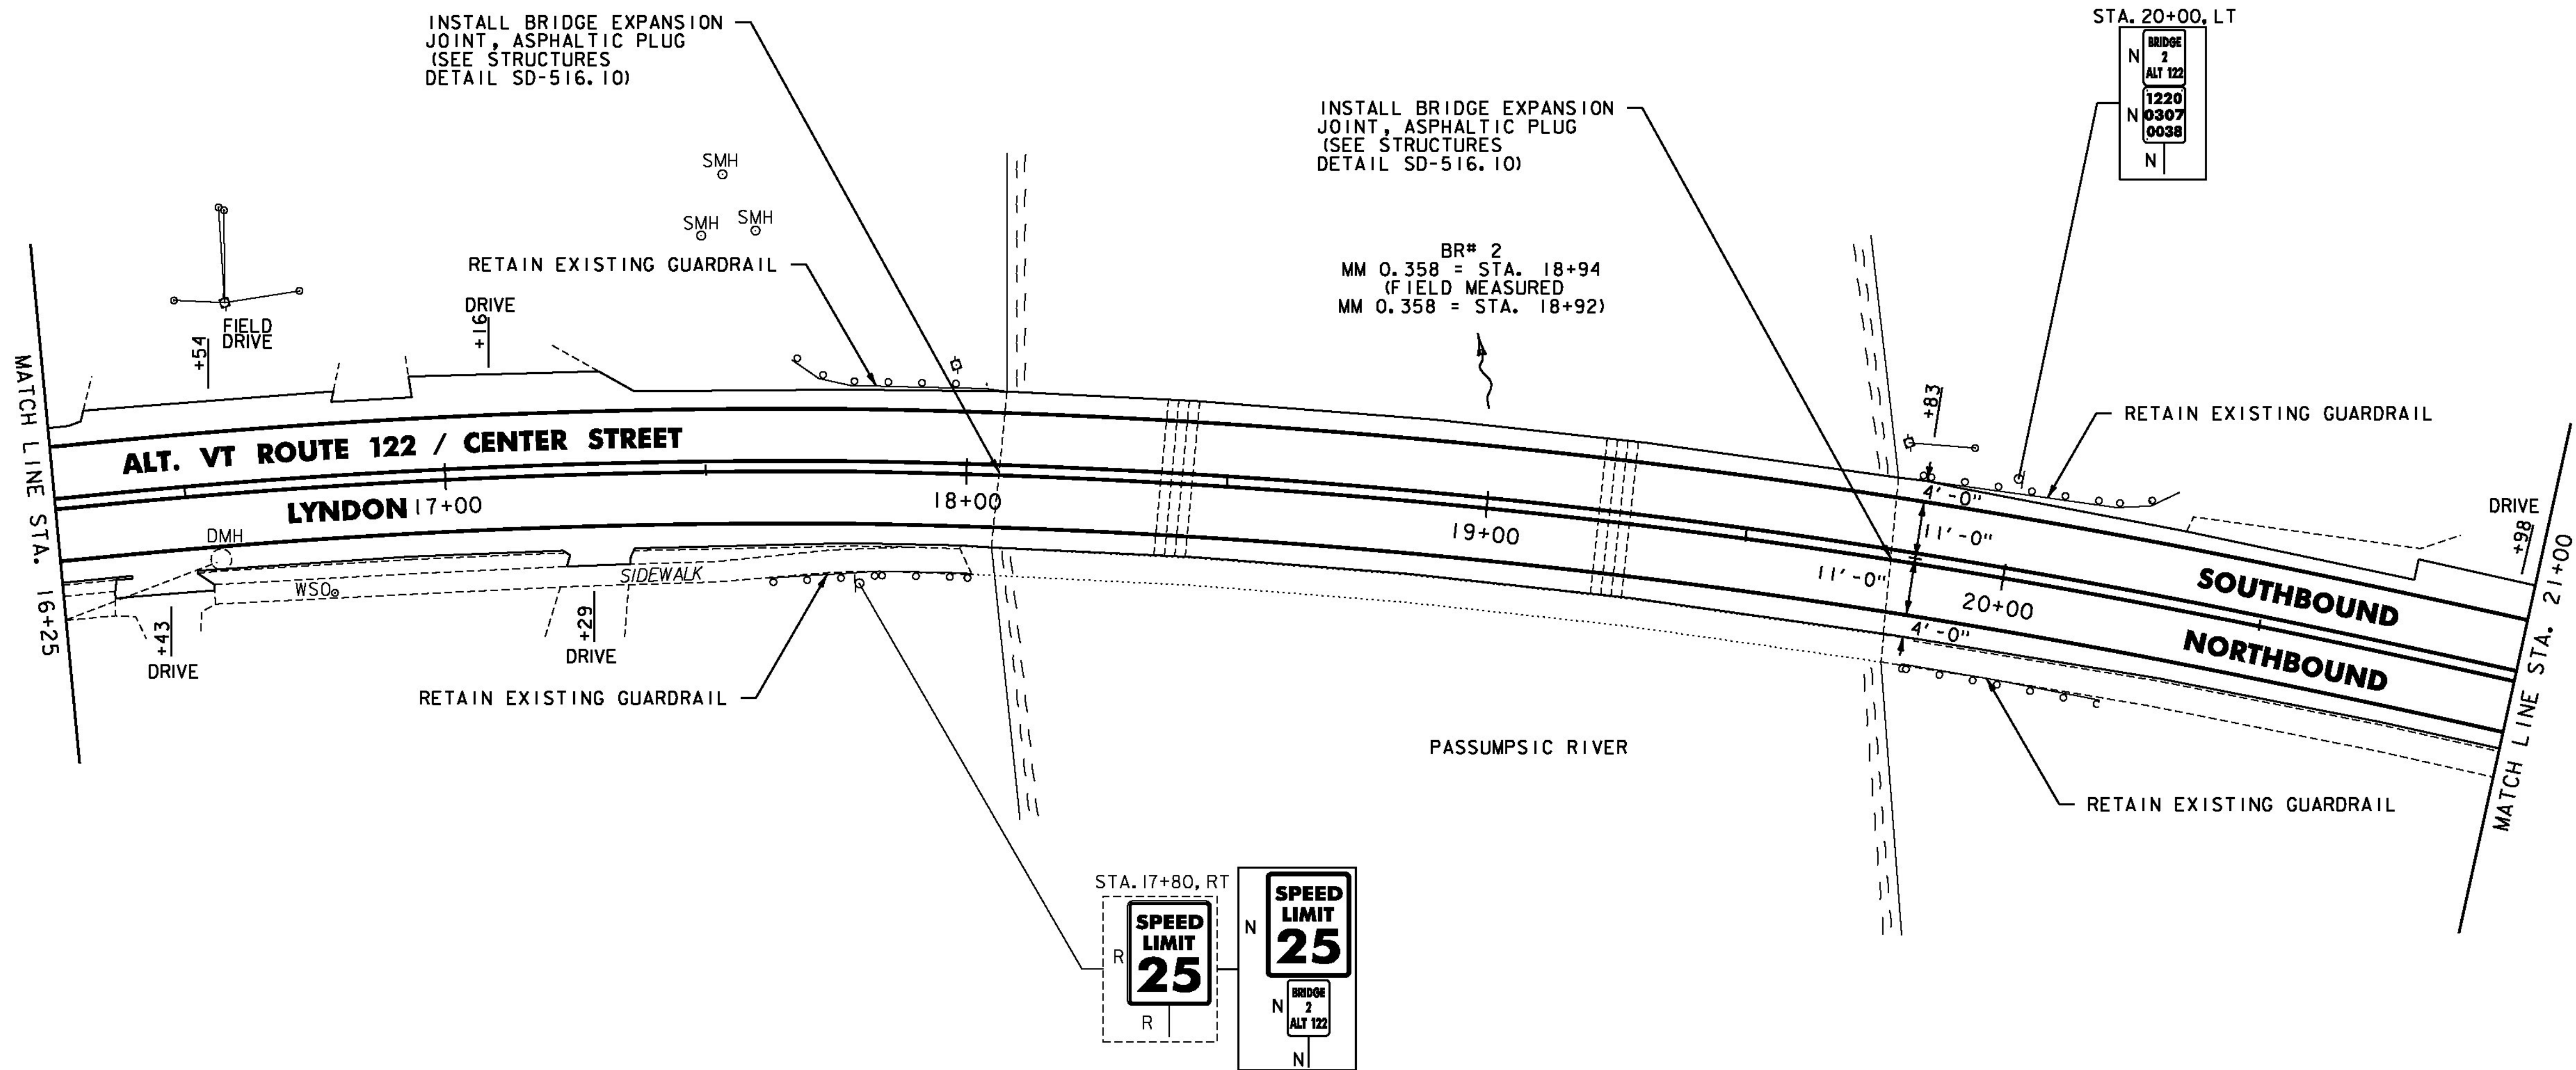

- NOTES:
1. FOR LEGENDS, SEE SHEET 3.
 2. ALL EXISTING SIGNS NOT SHOWN ON THE PLANS SHALL BE RETAINED.



NOT TO SCALE

**PROJECT
LAYOUT
SHEET #67**

PROJECT NAME: ST JOHNSBURY - LYNDON
PROJECT NUMBER: STP 2936(I)

FILE NAME: pllc308.dgn
PROJECT LEADER: G. EDWARDS
DESIGNED BY: D. DRAPER

PLOT DATE: 5/5/2014
DRAWN BY: D. DRAPER
CHECKED BY: J. LITTLE
SHEET 134 OF 250