


REHAB,
DIS, CDS OR MHS, CLASS I, II OR III
SEE SHEETS 27-28

DURABLE & TEMPORARY 4 INCH WHITE LINE
(ALL LINES WILL INCLUDE EDGE LINE BREAKS
AND RADII FOR SIDE ROADS)
STA. 21+00 TO 26+50, SOLID LT & RT

DURABLE & TEMPORARY 4 INCH YELLOW LINE
(ALL LINES WILL INCLUDE E BREAKS FOR SIDE ROADS)
STA. 21+00 TO 26+50, SOLID LT & RT

DURABLE & TEMPORARY LETTER OR SYMBOL
(ALL LINES WILL INCLUDE E BREAKS FOR SIDE ROADS)
STA. 22+37, RT "STOP"
STA. 22+77, "AHEAD"

REMOVING SIGNS
AS SHOWN - I

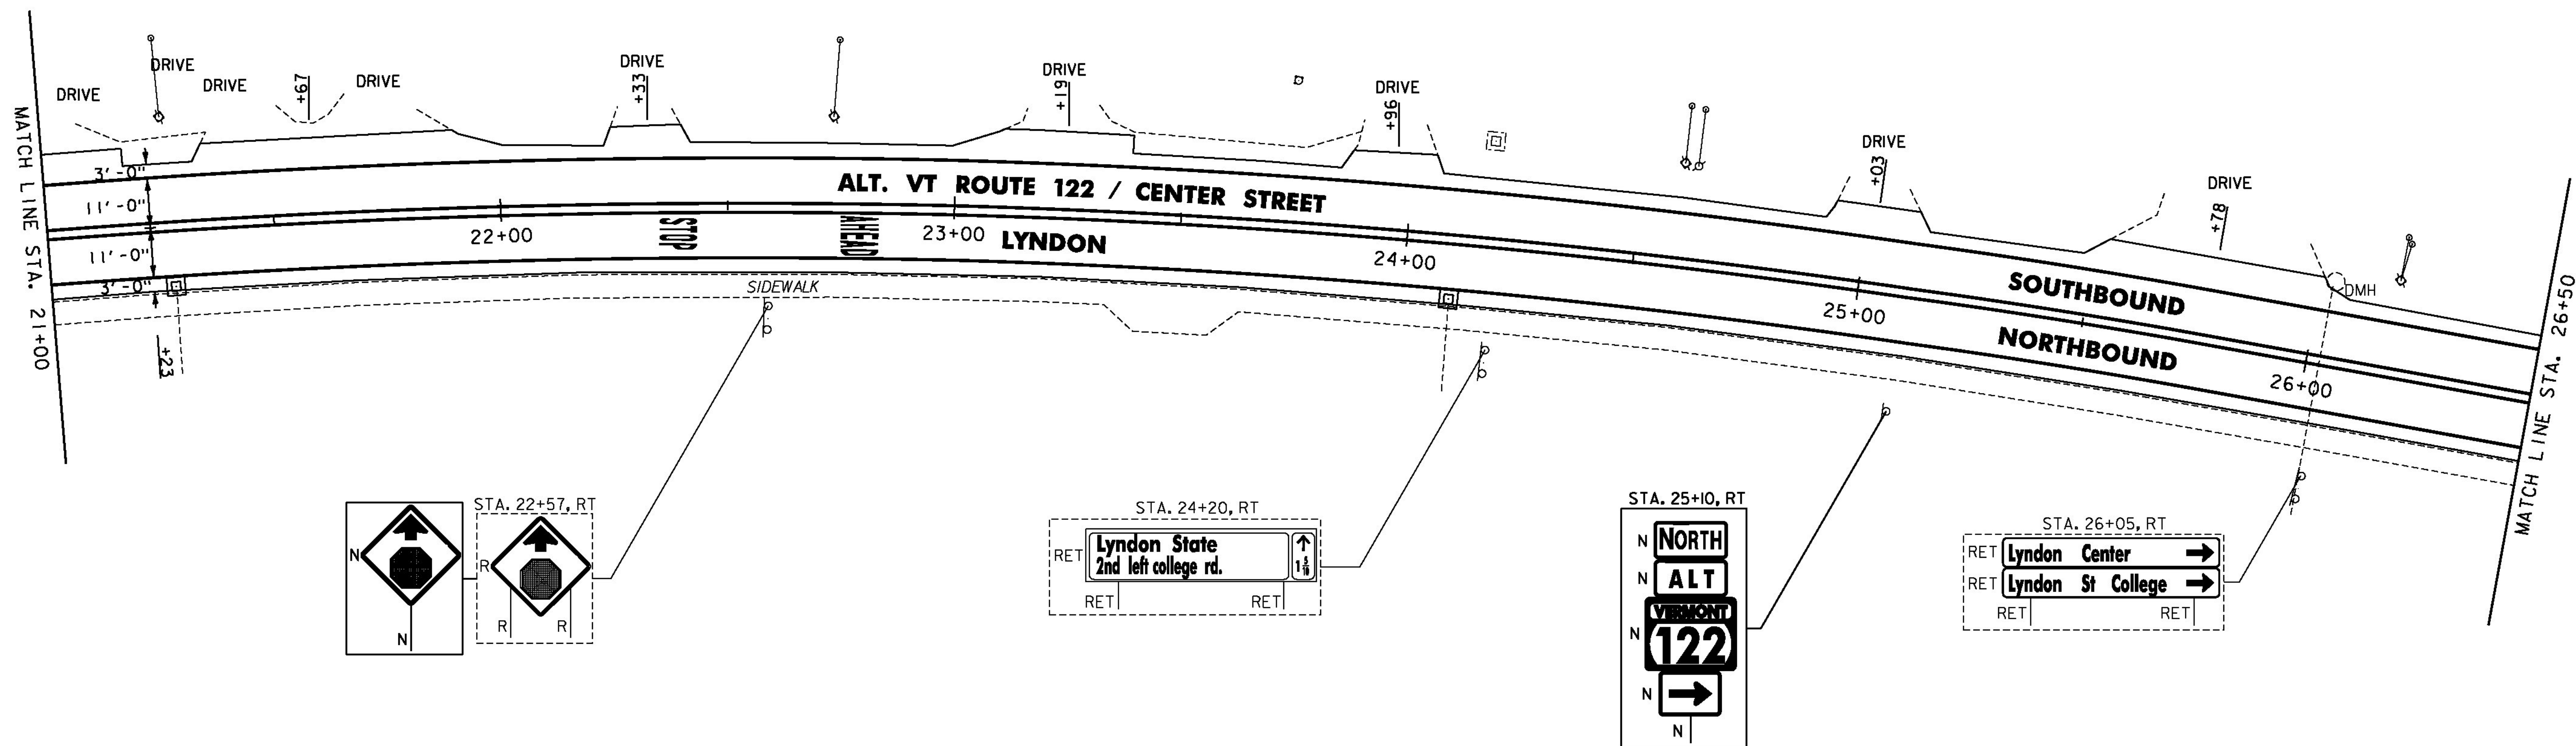

NOTES:

1. FOR LEGENDS, SEE SHEET 3.
2. ALL EXISTING SIGNS NOT SHOWN ON THE PLANS SHALL BE RETAINED.

NOT TO SCALE



PROJECT
LAYOUT
SHEET #68

PROJECT NAME: ST JOHNSBURY - LYNDON
PROJECT NUMBER: STP 2936(I)

FILE NAME: plic308.dgn
PROJECT LEADER: G. EDWARDS
DESIGNED BY: D. DRAPER

PLOT DATE: 5/5/2014
DRAWN BY: D. DRAPER
CHECKED BY: J. LITTLE
SHEET 135 OF 250