

REHAB,
Dis. CBs OR MHs, CLASS I, II OR III
SEE SHEETS 27-28

ADJUST ELEVATION OF VALVE BOX
SEE SHEETS 28-29

DURABLE & TEMPORARY 4 INCH WHITE LINE
(ALL LINES WILL INCLUDE EDGE LINE BREAKS
AND RADII FOR SIDE ROADS)
STA. 36+00 TO 41+00, SOLID LT & RT

DURABLE CROSSWALK MARKING, TYPE A TAPE
STA. 36+42 TO 36+52, LT
SEE SHEET 55 (TYP.)

REMOVING SIGNS
AS SHOWN - 5


BITUMINOUS CONCRETE GUTTERS AND TRAFFIC ISLANDS
STA. 40+83, RT SEE SHEET 56

PORTLAND CEMENT CONCRETE SIDEWALK, 5 INCH
STA. 36+42, RT

DETECTABLE WARNING SURFACE
STA. 36+42, RT

DURABLE & TEMPORARY 4 INCH YELLOW LINE
(ALL LINES WILL INCLUDE C BREAKS FOR SIDE ROADS & CROSSWALKS)
STA. 36+00 TO 41+00, SOLID LT & RT

TEMPORARY CROSSWALK MARKING, PAINT
STA. 36+42 TO 36+52, LT
SEE SHEET 55 (TYP.)

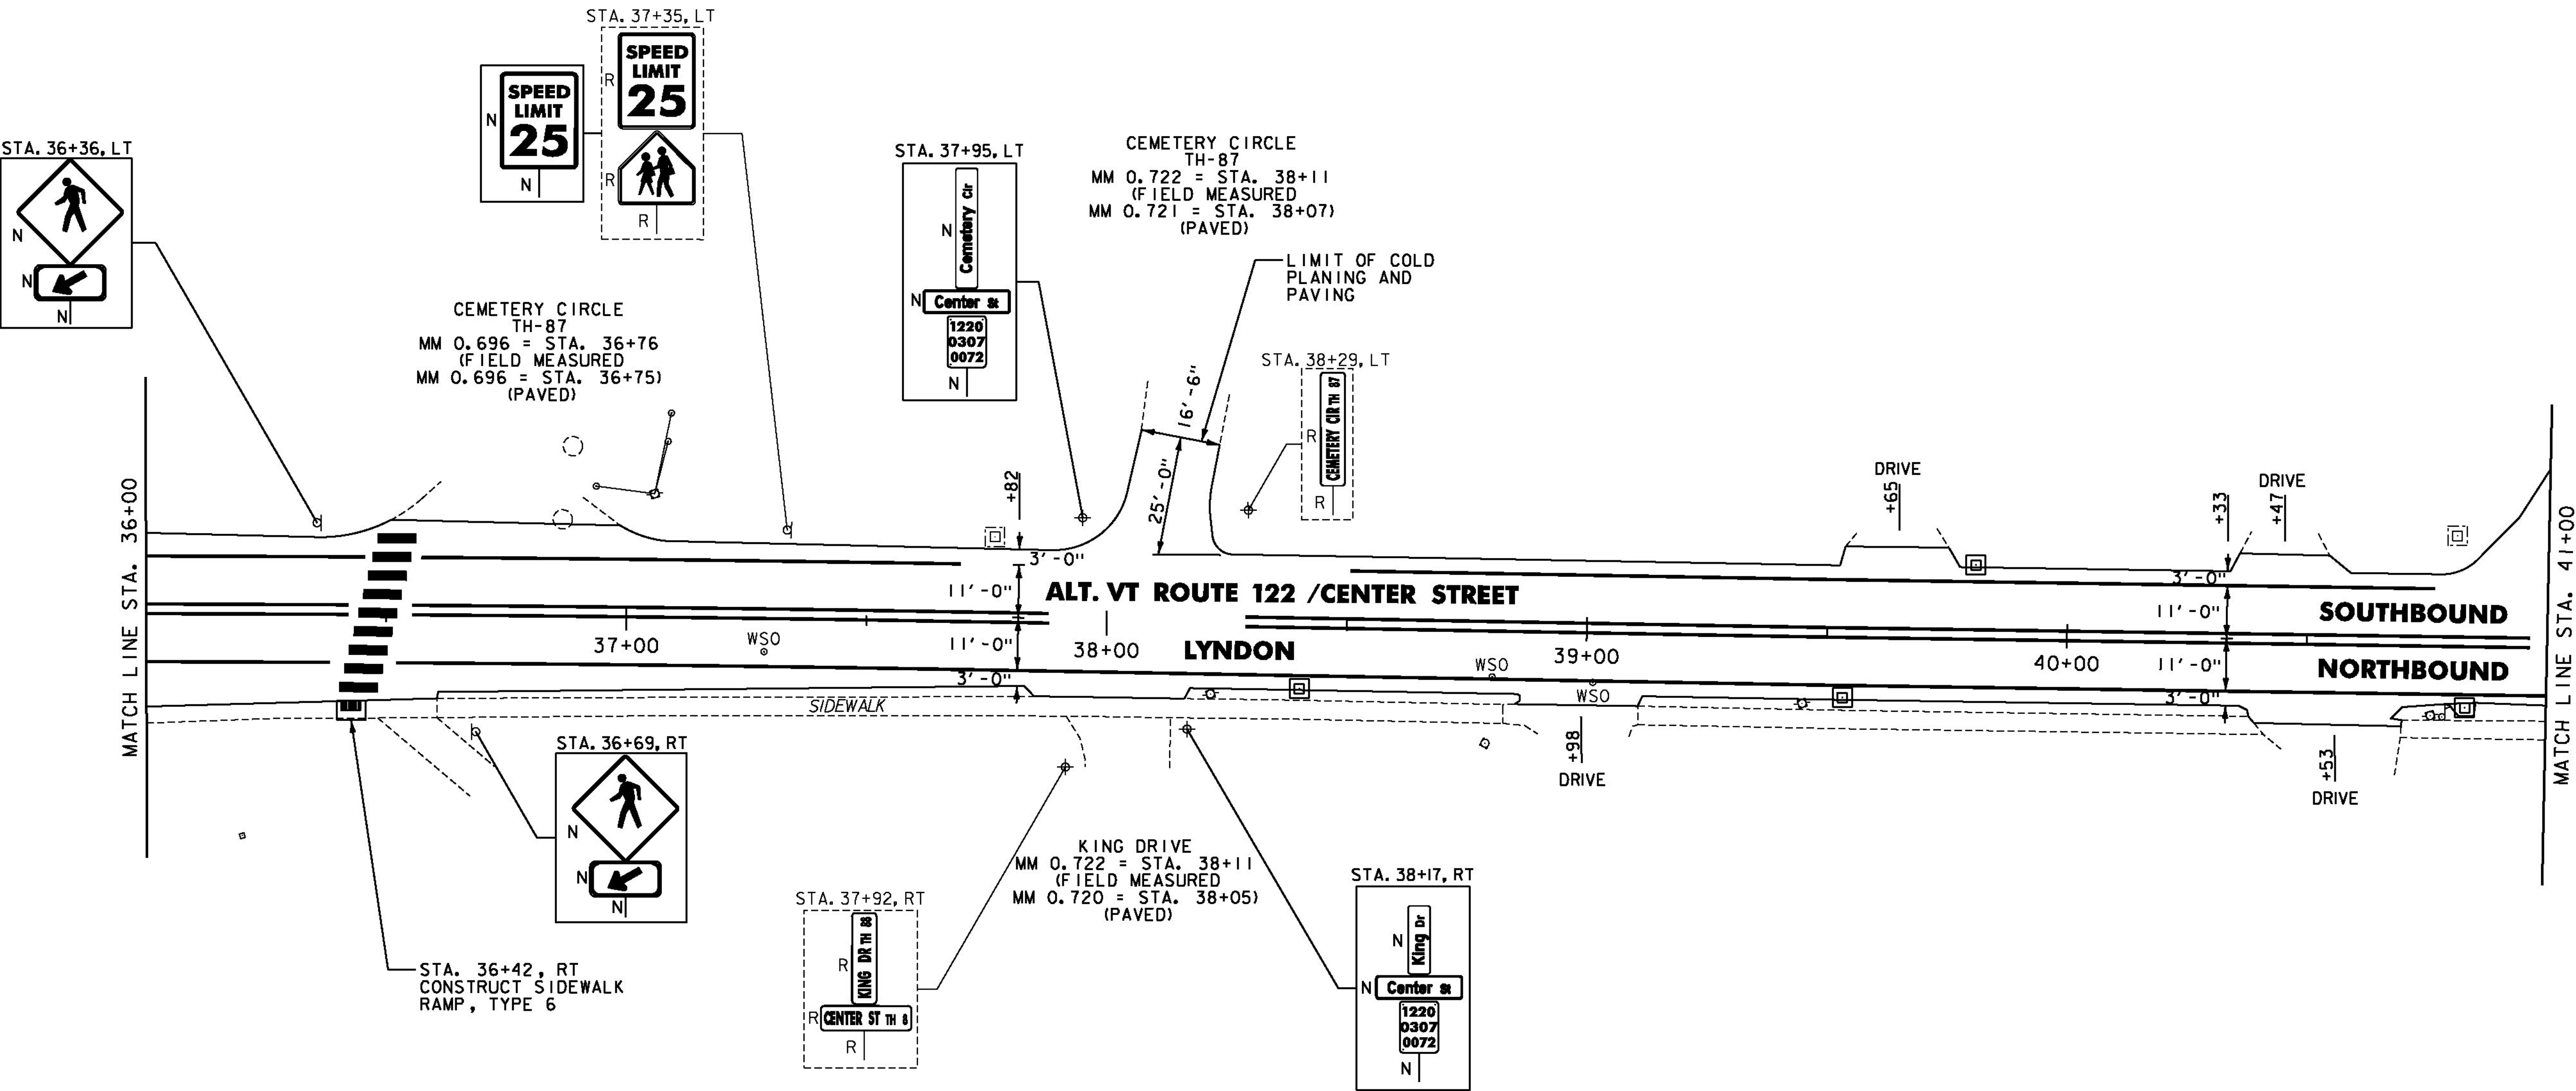

- NOTES:
- 1. FOR LEGENDS, SEE SHEET 3.
 - 2. ALL EXISTING SIGNS NOT SHOWN ON THE PLANS SHALL BE RETAINED.

NOT TO SCALE

PROJECT LAYOUT
SHEET #71

PROJECT NAME: ST JOHNSBURY - LYNDON

PROJECT NUMBER: STP 2936(I)

FILE NAME: pllc308.dgn

PROJECT LEADER: G. EDWARDS

DESIGNED BY: D. DRAPER

PLOT DATE: 5/5/2014

DRAWN BY: D. DRAPER

CHECKED BY: J. LITTLE

SHEET 138 OF 250

Stantec