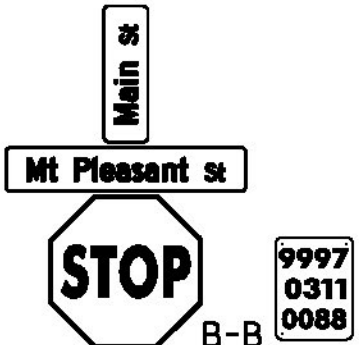
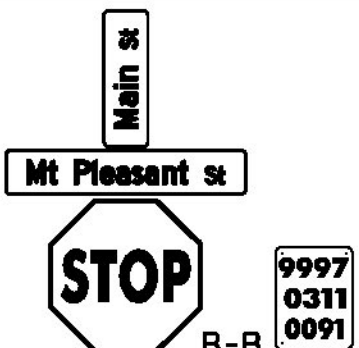
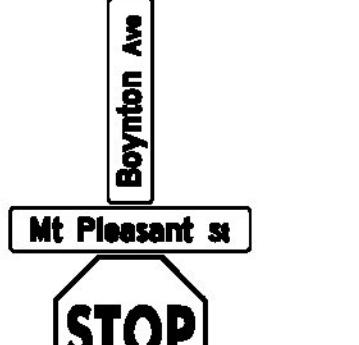


| STATE OF VERMONT<br>AGENCY OF TRANSPORTATION                                                                                                                                     |                                                                                     | TRAFFIC SIGN SUMMARY SHEET 56 |      |     |---|
| MILEMARKER,<br>STATION,<br>OR<br>SIGN NUMBER                                                                                                                                     | SIGN<br>LEGEND                                                                      | SIGN<br>DIMENSIONS            |      |     | NEW & SALVAGED SIGNS |     |              |             | EXIST<br>POST |             | NEW SIGN POSTS     |                    |     |     |                      |                 |     |        |        |                            |     |     |                         |     |        |              | REMARKS | SIGN DETAIL   |     |     |     |                                 |                                |                              |                                   |        |       |       |     |
|                                                                                                                                                                                  |                                                                                     |                               |      |     | "A"                  | "B" | SALV<br>SIGN | SALV<br>TIS | RE<br>TAIN    | SAL<br>VAGE | NO.<br>OF<br>POSTS | FLANGED<br>CHANNEL |     |     | SQUARE STEEL<br>(In) |                 |     | ANCHOR | SLEEVE | TUBULAR ALUMINUM<br>Ø (In) |     |     | TUBULAR STEEL<br>Ø (In) |     |        |              |         | W-SHAPE STEEL |     |     |     | RELOC-<br>RATED<br>SIGN<br>COMB | DETAIL<br>IN<br>SHSM *<br>BOOK | DETAIL<br>ON SHEET<br>NUMBER | STD.<br>SHEET<br>NUMBER           |        |       |       |     |
|                                                                                                                                                                                  |                                                                                     | lb/ft                         | 1.75 | 2.0 |                      |     |              |             |               |             |                    | 2.5                | 3.0 | 4.0 | 4.0<br>MOD           | FOUND-<br>ATION | 3.0 |        |        | 3.5                        | 4.0 | 5.0 | FTG. SIZE               |     | WEIGHT | POST<br>SIZE |         |               |     |     |     |                                 |                                |                              |                                   |        |       |       |     |
|                                                                                                                                                                                  |                                                                                     1.12                    | 2.0 |        |              |         | 1.3           | 1.7 | 1.7 | 7.6 |                                 |                                |                              |                                   | 9.0    | 10.8  | 14.6  | 24" |
| ST. JOHNSBURY ALT. U.S. ROUTE 5 (CONT.)                                                                                                                                          | |
| 46+32, RT                                                                                                                                                                        |    | I                             | 24   | 30  | 5.00                 |     |              |             |               |             | I                  |                    |     |     |                      | X               |     | X      |        |                            |     |     |                         |     |        |              |         |               |     |     |     |                                 |                                | VR-017                       |                                   | 238    |       |       |     |
| 46+57, RT                                                                                                                                                                        |    | I                             | 24   | 8   | 1.34                 |     |              |             |               |             | I                  |                    |     |     |                      | X               |     | X      |        |                            |     |     |                         |     |        |              |         |               |     |     |     |                                 |                                | D3-I                         |                                   | 230    |       |       |     |
|                                                                                                                                                                                  |                                                                                     | I                             | 42   | 8   | 2.35                 |     |              D3-I                         |                                   | 231    |       |       |     |
|                                                                                                                                                                                  |                                                                                     | I                             | 30   | 30  | 6.25                 |     |              RI-I                              | X      |       |       |     |
|                                                                                                                                                                                  |                                                                                     | I                             | 6    | 10  | 0.42                 |     |              VD-700                            |        | E-138 |       |     |
| 48+18, RT                                                                                                                                                                        |    | I                             | 24   | 8   | 1.34                 |     |              |             |               |             | I                  |                    |     |     |                      | X               |     | X      |        |                            |     |     |                         |     |        |              |         |               |     |     |     |                                 |                                |                              | D3-I                              |        | 230   |       |     |
|                                                                                                                                                                                  |                                                                                     | I                             | 42   | 8   | 2.35                 |     |              D3-I                              |        | 231   |       |     |
|                                                                                                                                                                                  |                                                                                     | I                             | 30   | 30  | 6.25                 |     |              RI-I                              | X      |       |       |     |
|                                                                                                                                                                                  |                                                                                     | I                             | 6    | 10  | 0.42                 |     |              VD-700                            |        | E-138 |       |     |
| 48+34, LT                                                                                                                                                                        |   | I                             | 30   | 30  | 6.25                 |     |              |             |               |             | I                  |                    |     |     |                      | X               |     | X      |        |                            |     |     |                         |     |        |              |         |               |     |     |     |                                 |                                |                              | W11-2 (FLUORESCENT YELLOW-GREEN)  | X      |       |       |     |
|                                                                                                                                                                                  |                                                                                     | I                             | 24   | 12  | 2.00                 |     |              W16-7P (FLUORESCENT YELLOW-GREEN) | X      |       |       |     |
| 48+62, RT                                                                                                                                                                        |  | I                             | 36   | 8   | 2.01                 |     |              |             |               |             | I                  |                    |     |     |                      | X               |     | X      |        |                            |     |     |                         |     |        |              |         |               |     |     |     |                                 |                                |                              | D3-I                              |        | 231   |       |     |
|                                                                                                                                                                                  |                                                                                     | I                             | 42   | 8   | 2.35                 |     |              D3-I   |       | 231   |     |
|                                                                                                                                                                                  |                                                                                     | I                             | 30   | 30  | 6.25                 |     |              RI-I   | X     |       |     |
|                                                                                                                                                                                  |                                                                                     | I                             | 6    | 10  | 0.42                 |     |              VD-700 |       | E-138 |     |
| 48+63, RT                                                                                                                                                                        |  | I                             | 30   | 30  | 6.25                 |     |              |             |               |             | I                  |                    |     |     |                      | X               |     | X      |        |                            |     |     |                         |     |        |              |         |               |     |     |     |                                 |                                |                              | W11-2 (FLUORESCENT YELLOW-GREEN)  | X      |       |       |     |
|                                                                                                                                                                                  |                                                                                     | I                             | 24   | 12  | 2.00                 |     |              W16-7P (FLUORESCENT YELLOW-GREEN) | X      |       |       |     |
| |
| |
| |
| * "SHSM"-STANDARD HIGHWAY SIGNS AND MARKINGS                                                                                                                                     |                                                                                     |                               |      |     |                      |     |              |             |               |             |                    | FT                 | FT  | FT  | FT                   | FT              | FT  | EA     | LB     | LB                         | LB  |     | LB                      | LB  | LB     | LB           |         |               |     |     |     |                                 |                                |                              |                                   |        |       |       |     |
| FINAL POST LENGTHS ARE TO BE DETERMINED IN THE FIELD. POST SIZES ARE COMPUTED BASED ON INFORMATION FURNISHED ON THE STANDARD SHEETS AND THE VTRANS "SIGN POST DESIGN GUIDELINE." |                                                                                     |                               |      |     |                      |     |              |             |               |             |                    | FT                 |     |     | FT 82                |                 |     |        | LB     |                            |     |     | EA.                     | LB  |        |              |         | EA.           | EA. | LB  |     |                                 |                                |                              |                                   |        |       |       |     |
|                                                                                                                                                                                  |                                                                                     |                               |      |     |                      |     |              |             |               |             |                    | FT                 |     |     | FT 82                |                 |     |        | LB     |                            |     |     | EA.                     | LB  |        |              |         | EA.           | EA. | LB  |     |                                 |                                |                              |                                   |        |       |       |     |
|                                                                                                                                                                                  |                                                                                     |                               |      |     |                      |     |              |             |               |             |                    | FT                 |     |     | FT 82                |                 |     |        | LB     |                            |     |     | EA.                     | LB  |        |              |         | EA.           | EA. | LB  |     |                                 |                                |                              |                                   |        |       |       |     |
| |