




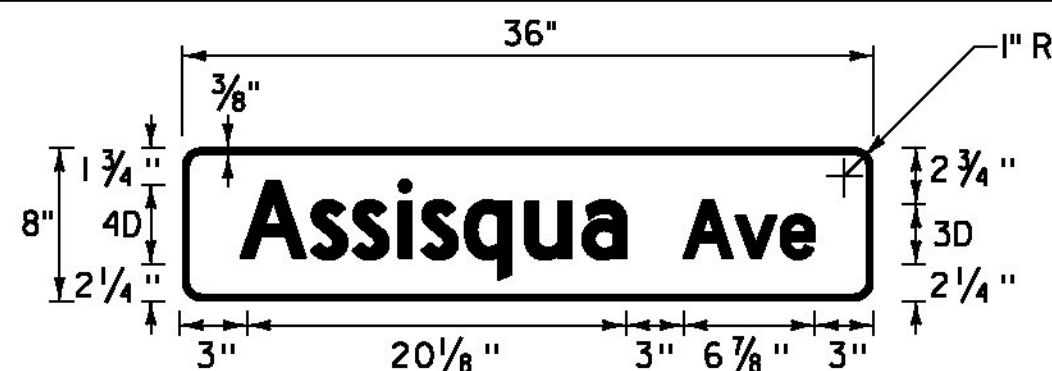


D3-1
LOCATION: ST. JOHNSBURY: U.S. ROUTE 2
STA. 239+21, LT
COLOR: WHITE BORDER AND TEXT (RETROREFLECTIVE)
GREEN BACKGROUND (RETROREFLECTIVE)
MATERIAL: 0.125" FLAT SHEET ALUMINUM

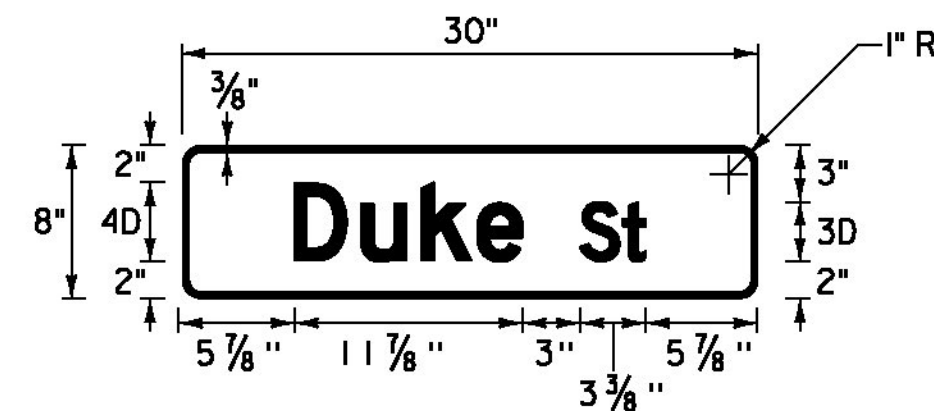


D3-1
LOCATION: ST. JOHNSBURY: U.S. ROUTE 2
STA. 241+55, LT
COLOR: WHITE BORDER AND TEXT (RETROREFLECTIVE)
GREEN BACKGROUND (RETROREFLECTIVE)
MATERIAL: 0.125" FLAT SHEET ALUMINUM

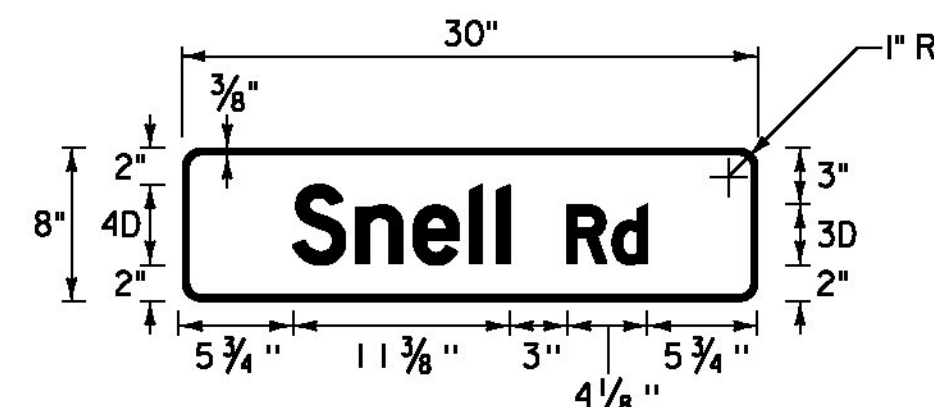


D3-1
LOCATION: ST. JOHNSBURY: U.S. ROUTE 2
STA. 246+74, LT
COLOR: WHITE BORDER AND TEXT (RETROREFLECTIVE)
GREEN BACKGROUND (RETROREFLECTIVE)
MATERIAL: 0.125" FLAT SHEET ALUMINUM

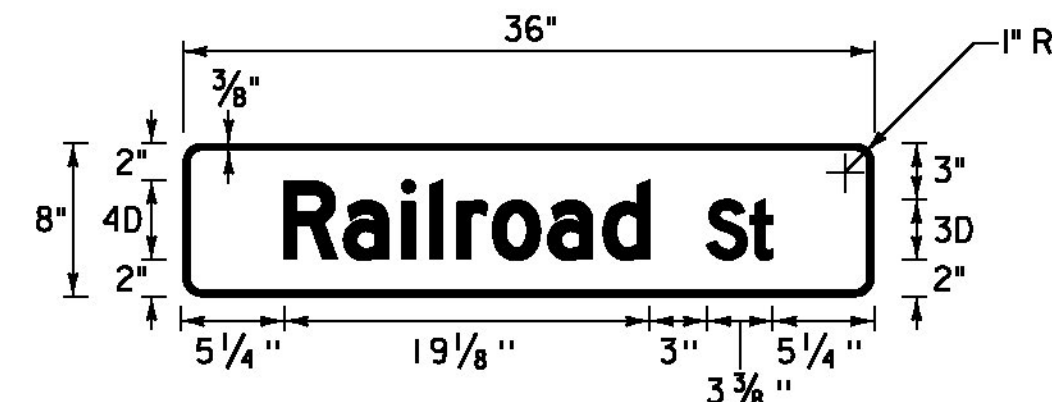


D3-1
LOCATION: ST. JOHNSBURY: U.S. ROUTE 2
STA. 31+79, LT
ST. JOHNSBURY: U.S. ROUTE 5
STA. 75+60, LT
STA. 85+46, LT
STA. 88+55, RT
STA. 90+54, RT
STA. 91+90, LT
STA. 99+46, LT
STA. 104+86, LT
STA. 112+20, RT
STA. 116+70, LT
STA. 120+14, RT
ST. JOHNSBURY: ALT U.S. ROUTE 5
STA. 0+22, LT
COLOR: WHITE BORDER AND TEXT (RETROREFLECTIVE)
GREEN BACKGROUND (RETROREFLECTIVE)
MATERIAL: 0.125" FLAT SHEET ALUMINUM

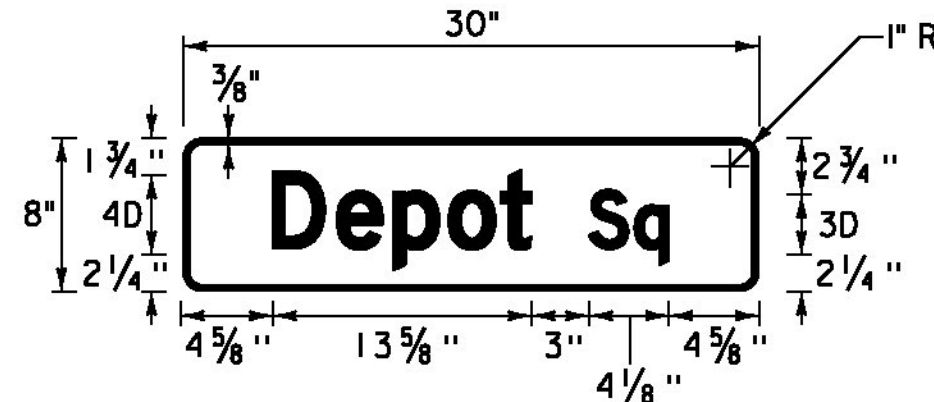


D3-1
LOCATION: ST. JOHNSBURY: U.S. ROUTE 5
STA. 88+55, RT
STA. 90+54, RT
COLOR: WHITE BORDER AND TEXT (RETROREFLECTIVE)
GREEN BACKGROUND (RETROREFLECTIVE)
MATERIAL: 0.125" FLAT SHEET ALUMINUM

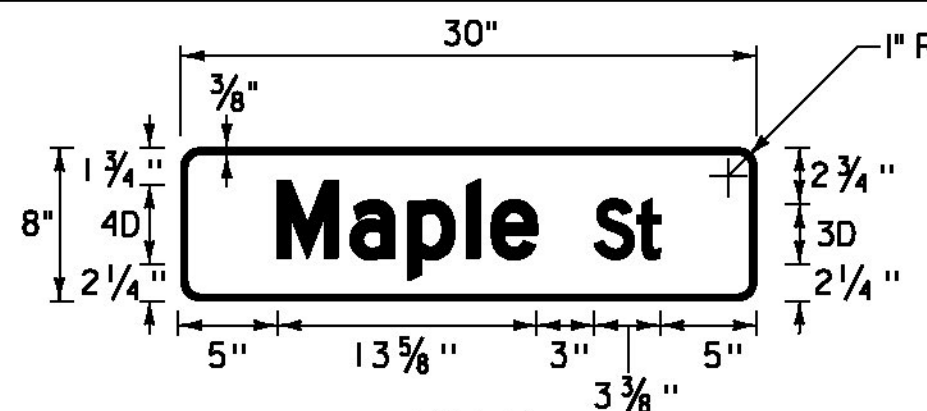


D3-1
LOCATION: ST. JOHNSBURY: U.S. ROUTE 5
STA. 99+46, LT
ST. JOHNSBURY: ALT U.S. ROUTE 5
STA. 36+93, RT
COLOR: WHITE BORDER AND TEXT (RETROREFLECTIVE)
GREEN BACKGROUND (RETROREFLECTIVE)
MATERIAL: 0.125" FLAT SHEET ALUMINUM

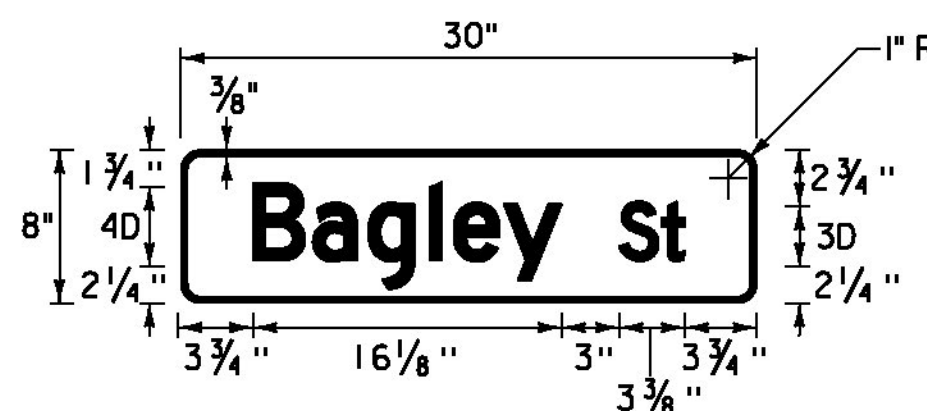


D3-1
LOCATION: ST. JOHNSBURY: U.S. ROUTE 5
STA. 104+86, LT
COLOR: WHITE BORDER AND TEXT (RETROREFLECTIVE)
GREEN BACKGROUND (RETROREFLECTIVE)
MATERIAL: 0.125" FLAT SHEET ALUMINUM

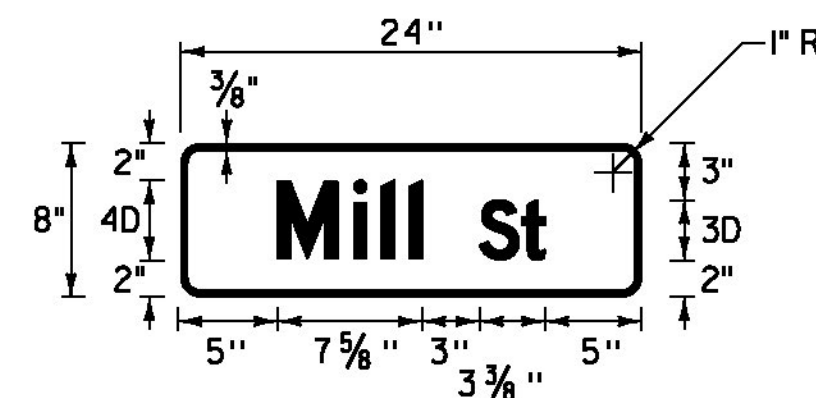


D3-1
LOCATION: ST. JOHNSBURY: U.S. ROUTE 5
STA. 112+20, RT
COLOR: WHITE BORDER AND TEXT (RETROREFLECTIVE)
GREEN BACKGROUND (RETROREFLECTIVE)
MATERIAL: 0.125" FLAT SHEET ALUMINUM

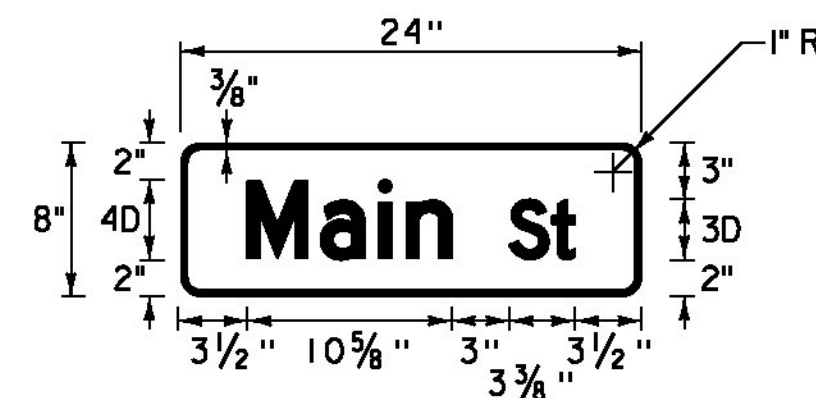


D3-1
LOCATION: ST. JOHNSBURY: U.S. ROUTE 5
STA. 118+70, LT
ST. JOHNSBURY: ALT U.S. ROUTE 5
STA. 0+22, LT
STA. 20+11, LT
STA. 22+47, LT
STA. 27+81, LT
STA. 31+46, RT
STA. 31+74, LT
STA. 33+46, RT
STA. 36+93, RT
STA. 37+42, LT
STA. 41+23, LT
STA. 41+54, RT
STA. 44+59, RT
STA. 46+97, RT
STA. 48+18, RT
LYNDON: ALT VT ROUTE 122
STA. 8+05, RT
COLOR: WHITE BORDER AND TEXT (RETROREFLECTIVE)
GREEN BACKGROUND (RETROREFLECTIVE)
MATERIAL: 0.125" FLAT SHEET ALUMINUM

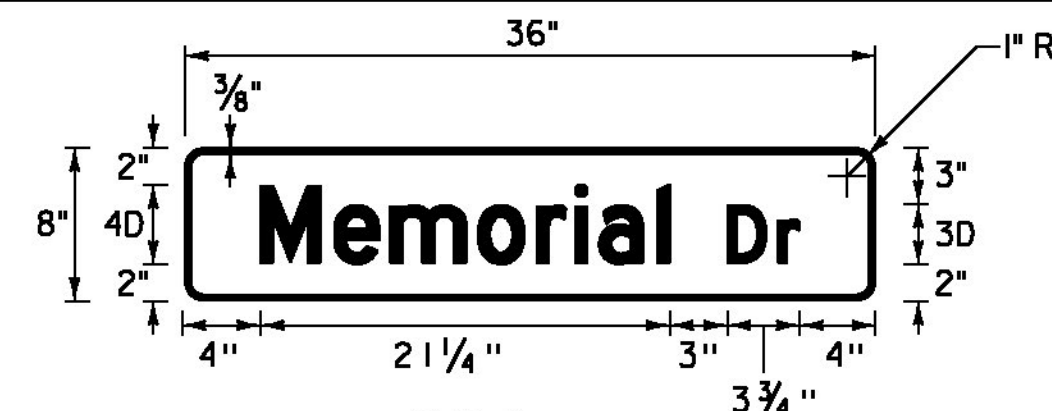


D3-1
LOCATION: ST. JOHNSBURY: U.S. ROUTE 5
STA. 141+17, LT
STA. 142+33, LT
STA. 146+53, RT
STA. 149+99, RT
COLOR: WHITE BORDER AND TEXT (RETROREFLECTIVE)
GREEN BACKGROUND (RETROREFLECTIVE)
MATERIAL: 0.125" FLAT SHEET ALUMINUM

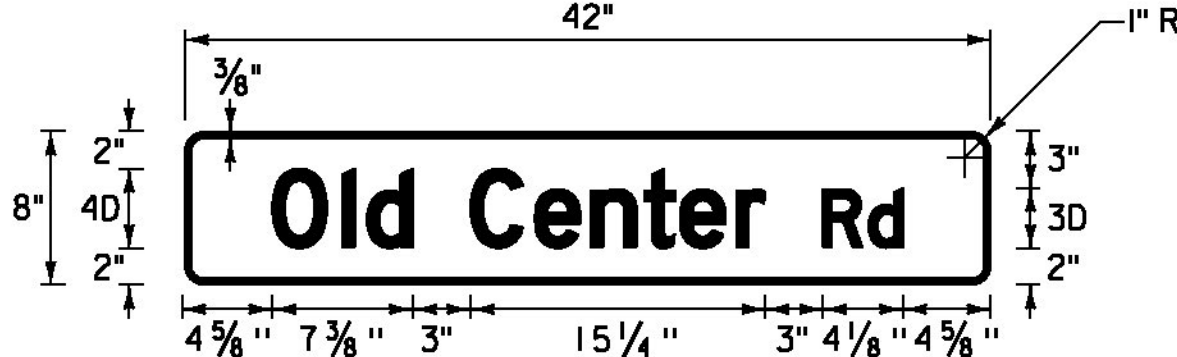


D3-1
LOCATION: ST. JOHNSBURY: U.S. ROUTE 5
STA. 141+17, LT
STA. 142+33, LT
COLOR: WHITE BORDER AND TEXT (RETROREFLECTIVE)
GREEN BACKGROUND (RETROREFLECTIVE)
MATERIAL: 0.125" FLAT SHEET ALUMINUM

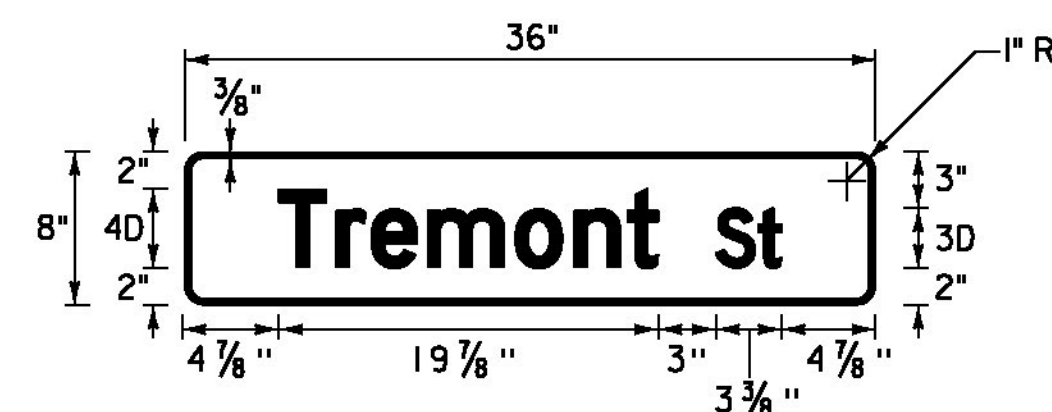


D3-1
LOCATION: ST. JOHNSBURY: U.S. ROUTE 5
STA. 146+53, RT
COLOR: WHITE BORDER AND TEXT (RETROREFLECTIVE)
GREEN BACKGROUND (RETROREFLECTIVE)
MATERIAL: 0.125" FLAT SHEET ALUMINUM

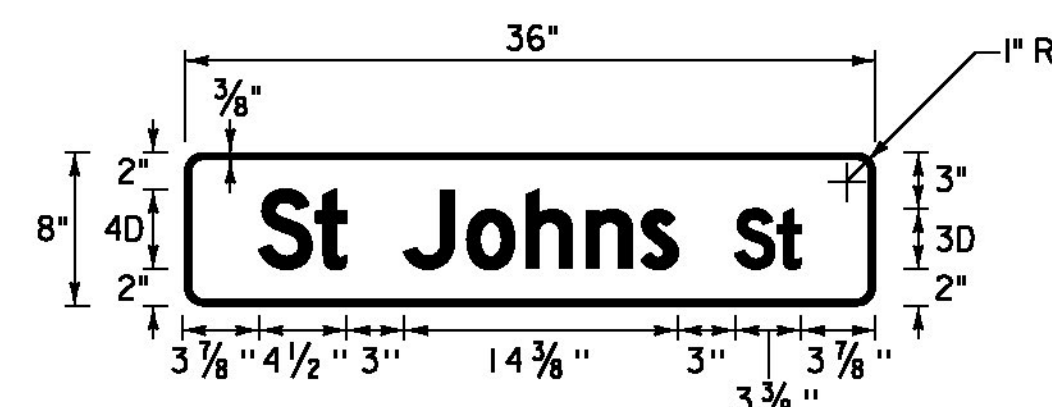


D3-1
LOCATION: ST. JOHNSBURY: U.S. ROUTE 5
STA. 149+99, RT
COLOR: WHITE BORDER AND TEXT (RETROREFLECTIVE)
GREEN BACKGROUND (RETROREFLECTIVE)
MATERIAL: 0.125" FLAT SHEET ALUMINUM

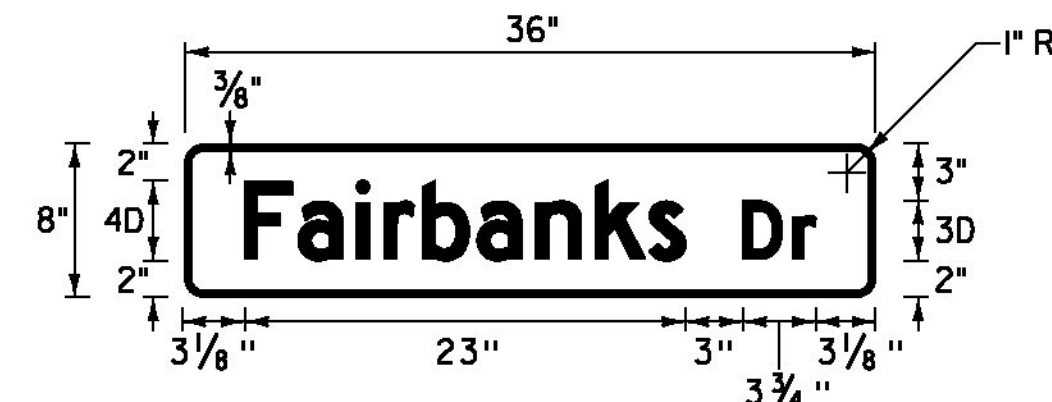


D3-1
LOCATION: ST. JOHNSBURY: ALT U.S. ROUTE 5
STA. 20+11, LT
COLOR: WHITE BORDER AND TEXT (RETROREFLECTIVE)
GREEN BACKGROUND (RETROREFLECTIVE)
MATERIAL: 0.125" FLAT SHEET ALUMINUM

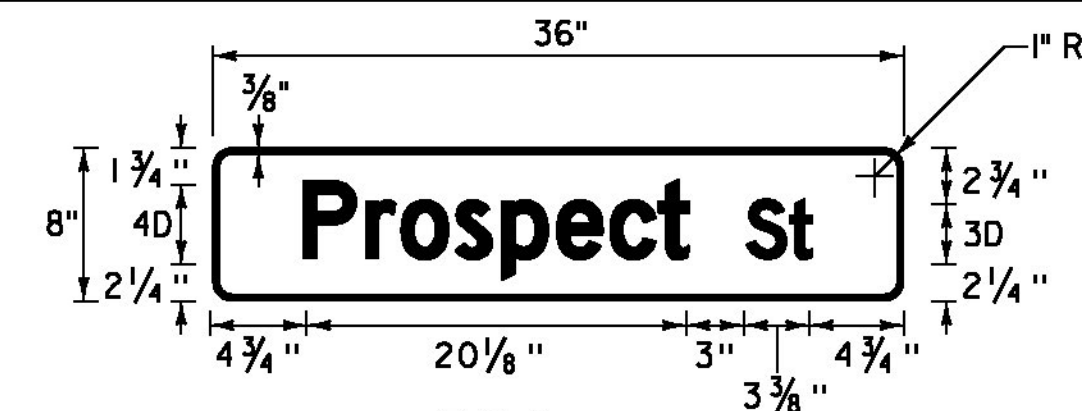


D3-1
LOCATION: ST. JOHNSBURY: ALT U.S. ROUTE 5
STA. 31+46, RT
COLOR: WHITE BORDER AND TEXT (RETROREFLECTIVE)
GREEN BACKGROUND (RETROREFLECTIVE)
MATERIAL: 0.125" FLAT SHEET ALUMINUM

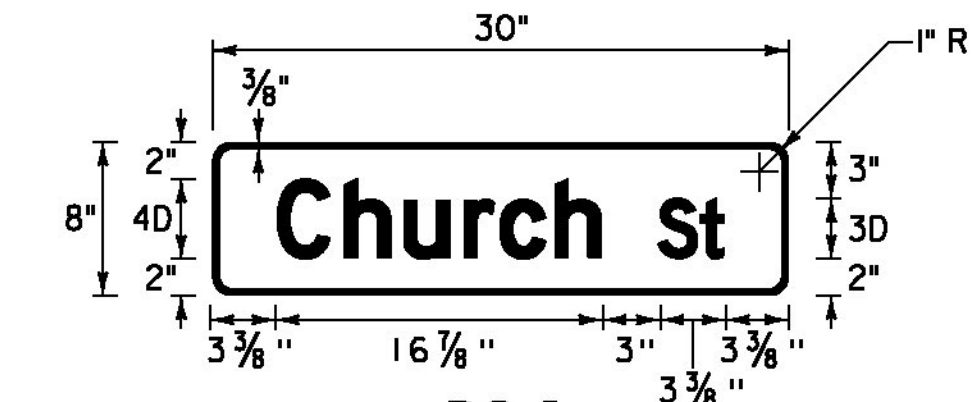


D3-1
LOCATION: ST. JOHNSBURY: ALT U.S. ROUTE 5
STA. 31+74, LT
COLOR: WHITE BORDER AND TEXT (RETROREFLECTIVE)
GREEN BACKGROUND (RETROREFLECTIVE)
MATERIAL: 0.125" FLAT SHEET ALUMINUM

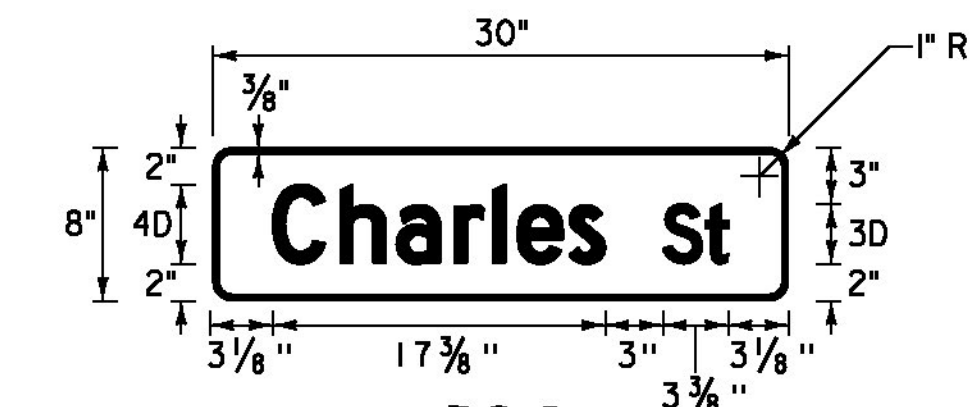


D3-1
LOCATION: ST. JOHNSBURY: ALT U.S. ROUTE 5
STA. 33+46, RT
COLOR: WHITE BORDER AND TEXT (RETROREFLECTIVE)
GREEN BACKGROUND (RETROREFLECTIVE)
MATERIAL: 0.125" FLAT SHEET ALUMINUM

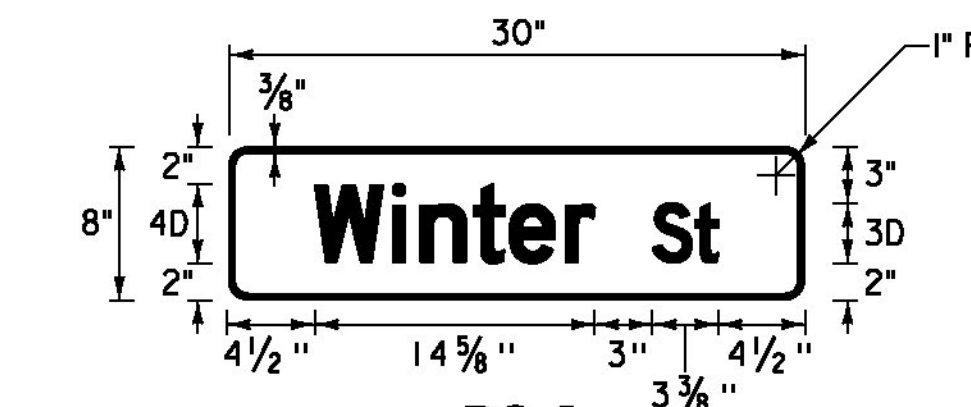


D3-1
LOCATION: ST. JOHNSBURY: ALT U.S. ROUTE 5
STA. 37+42, LT
COLOR: WHITE BORDER AND TEXT (RETROREFLECTIVE)
GREEN BACKGROUND (RETROREFLECTIVE)
MATERIAL: 0.125" FLAT SHEET ALUMINUM

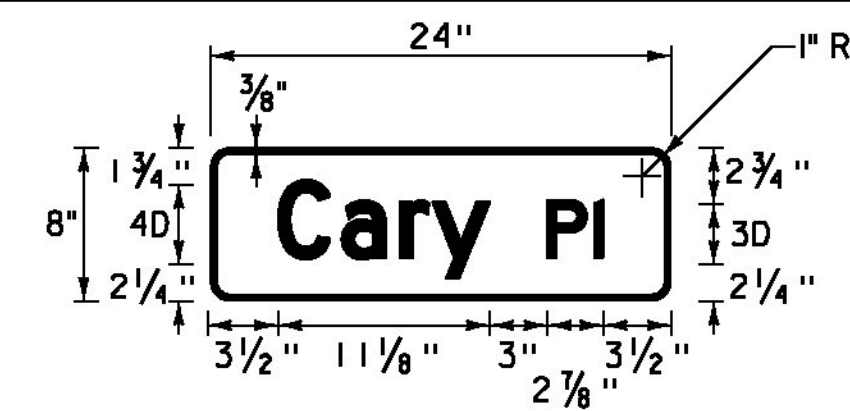


D3-1
LOCATION: ST. JOHNSBURY: ALT U.S. ROUTE 5
STA. 41+23, LT
COLOR: WHITE BORDER AND TEXT (RETROREFLECTIVE)
GREEN BACKGROUND (RETROREFLECTIVE)
MATERIAL: 0.125" FLAT SHEET ALUMINUM

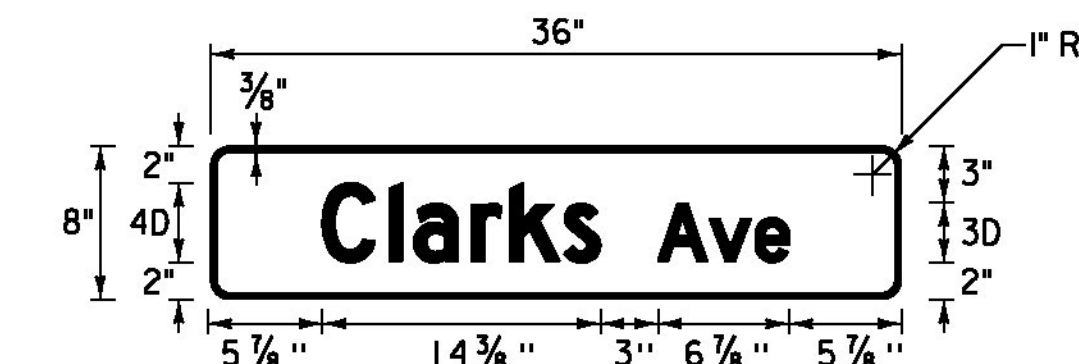

D3-1
LOCATION: ST. JOHNSBURY: ALT U.S. ROUTE 5
STA. 41+54, RT
COLOR: WHITE BORDER AND TEXT (RETROREFLECTIVE)
GREEN BACKGROUND (RETROREFLECTIVE)
MATERIAL: 0.125" FLAT SHEET ALUMINUM

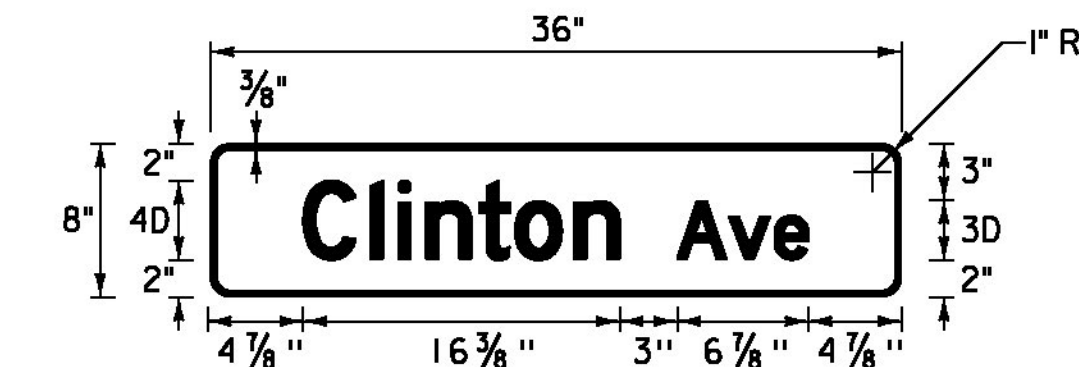

D3-1
LOCATION: ST. JOHNSBURY: ALT U.S. ROUTE 5
STA. 44+59, LT
STA. 50+00, LT
COLOR: WHITE BORDER AND TEXT (RETROREFLECTIVE)
GREEN BACKGROUND (RETROREFLECTIVE)
MATERIAL: 0.125" FLAT SHEET ALUMINUM

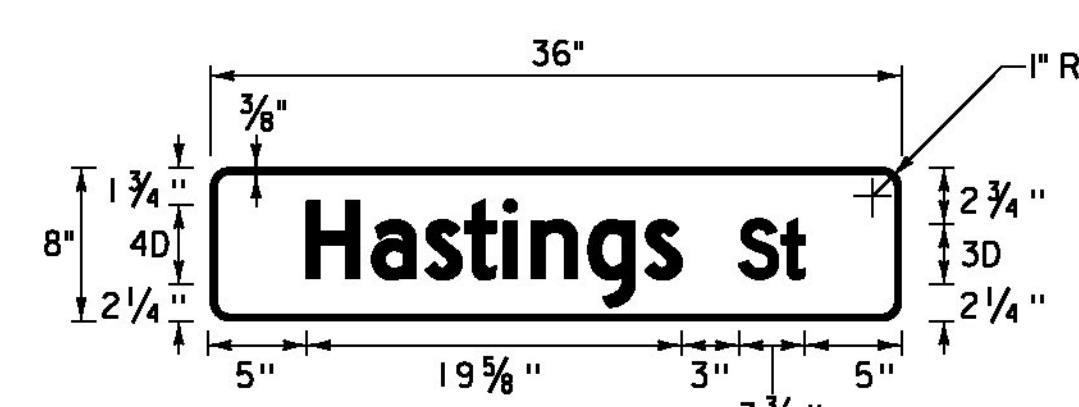

D3-1
LOCATION: ST. JOHNSBURY: ALT U.S. ROUTE 5
STA. 52+36, LT
COLOR: WHITE BORDER AND TEXT (RETROREFLECTIVE)
GREEN BACKGROUND (RETROREFLECTIVE)
MATERIAL: 0.125" FLAT SHEET ALUMINUM

NOT TO SCALE

NOTE: SEE TRAFFIC SIGN NOTES ON SHEET 241



**TRAFFIC
SIGN
DETAIL
SHEET #2**

PROJECT NAME: ST JOHNSBURY - LYNDON
PROJECT NUMBER: STP 2936(1)

FILE NAME: pllc308.dgn
PROJECT LEADER: G. EDWARDS
DESIGNED BY: D. DRAPER
PLOT DATE: 5/5/2014
DRAWN BY: D. DRAPER
SHEET 230 OF 250