



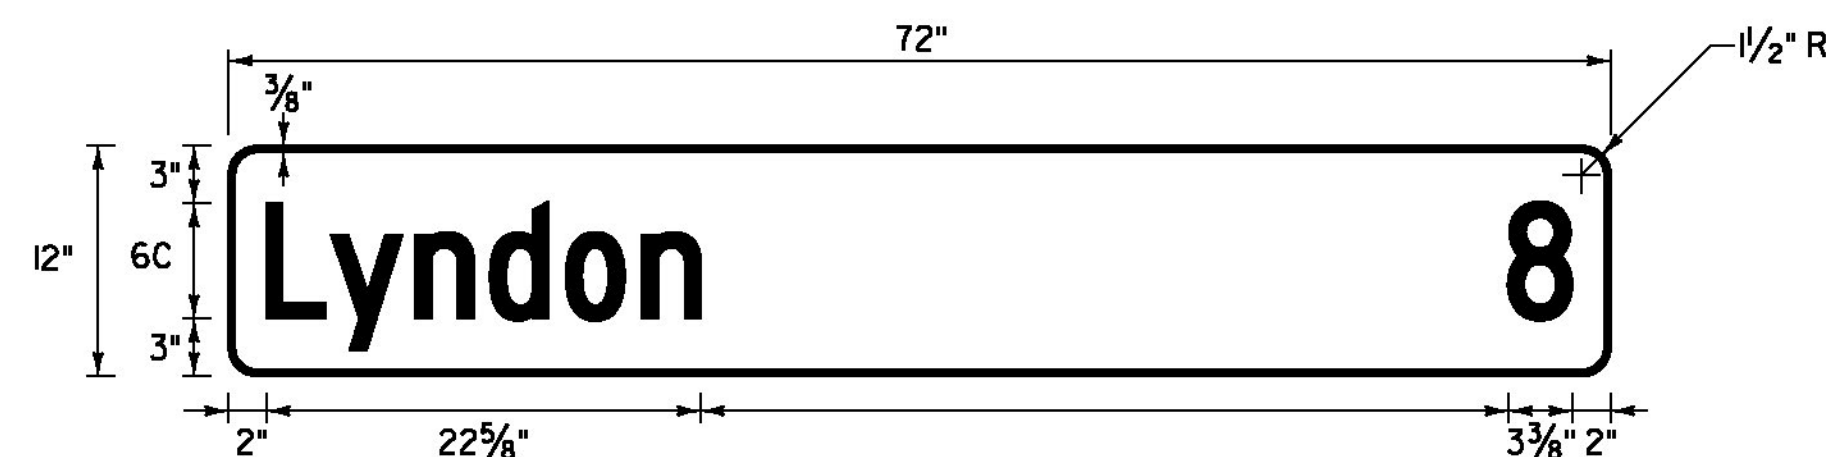

VD2-1


LOCATION: ST. JOHNSBURY: ALT U.S. ROUTE 5
STA. 4+00, RT
COLOR: WHITE BORDER, ARROW AND TEXT (RETROREFLECTIVE)
GREEN BACKGROUND (RETROREFLECTIVE)
MATERIAL: 0.125" FLAT SHEET ALUMINUM

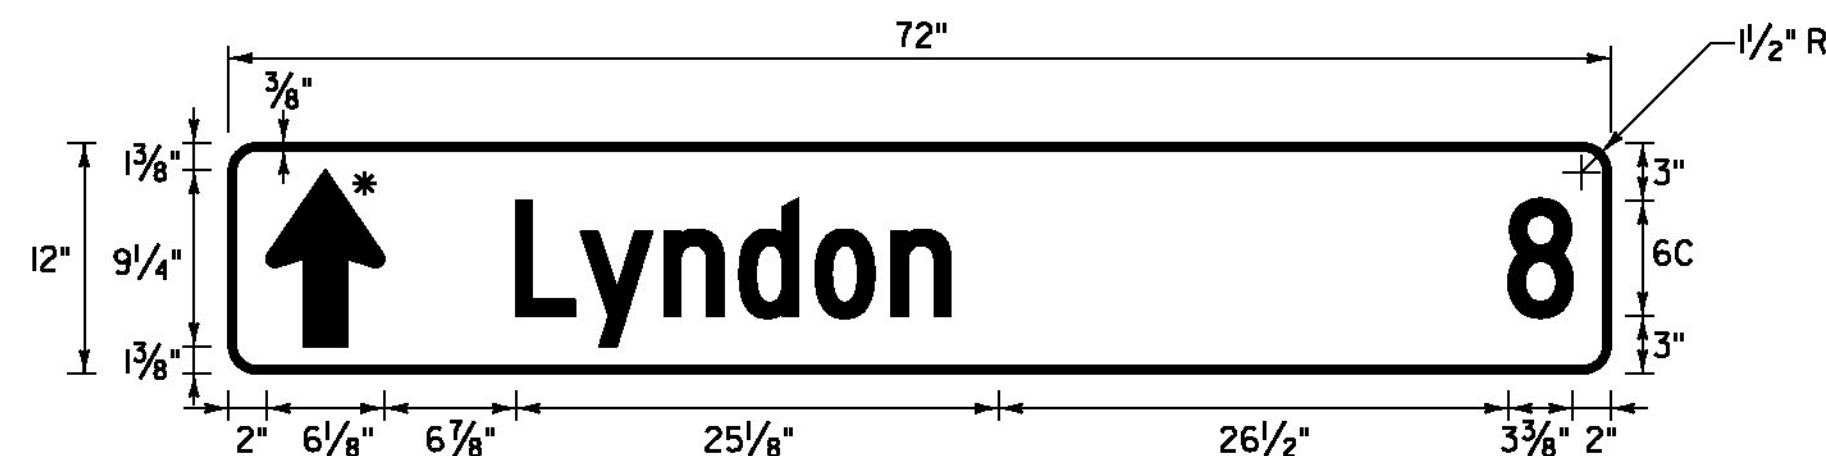

VD1-1a

LOCATION: ST. JOHNSBURY: ALT U.S. ROUTE 5
STA. 20+62, RT
COLOR: WHITE BORDER, ARROW AND TEXT (RETROREFLECTIVE)
GREEN BACKGROUND (RETROREFLECTIVE)
MATERIAL: 0.125" FLAT SHEET ALUMINUM


* FOR ARROW DETAIL SEE SHEET 238

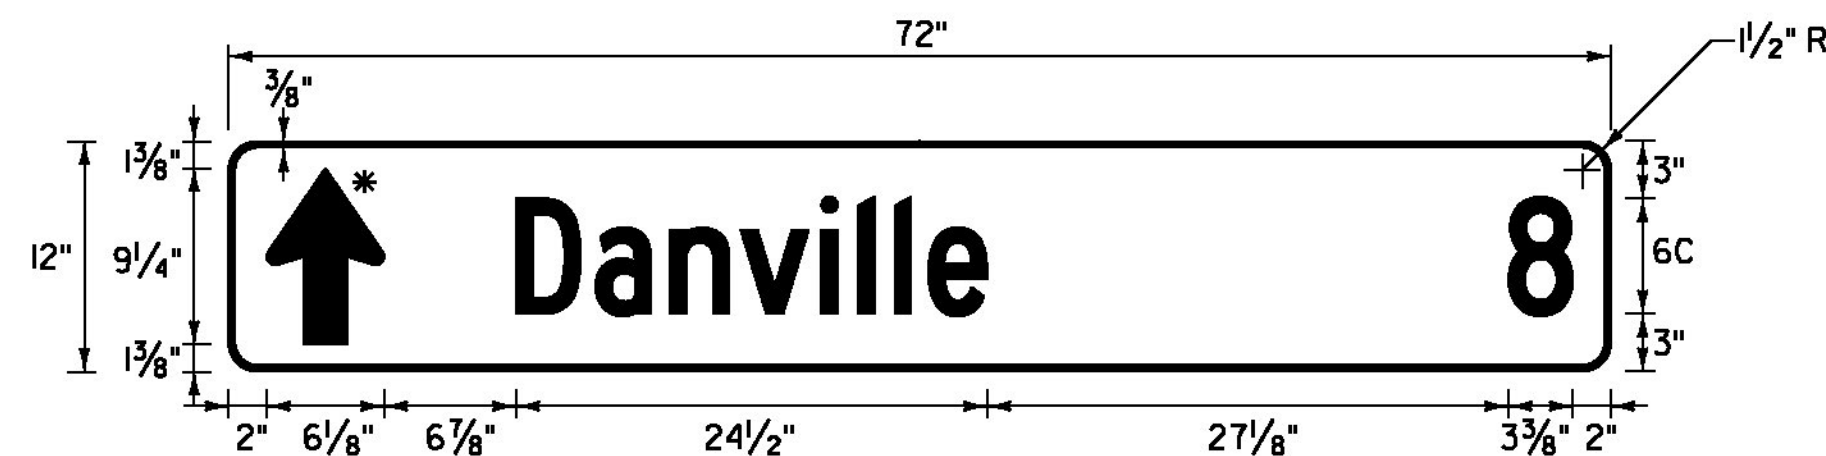

VD1-1a

LOCATION: ST. JOHNSBURY: ALT U.S. ROUTE 5
STA. 29+05, LT
COLOR: WHITE BORDER, ARROW AND TEXT (RETROREFLECTIVE)
GREEN BACKGROUND (RETROREFLECTIVE)
MATERIAL: 0.125" FLAT SHEET ALUMINUM


* FOR ARROW DETAIL SEE SHEET 238

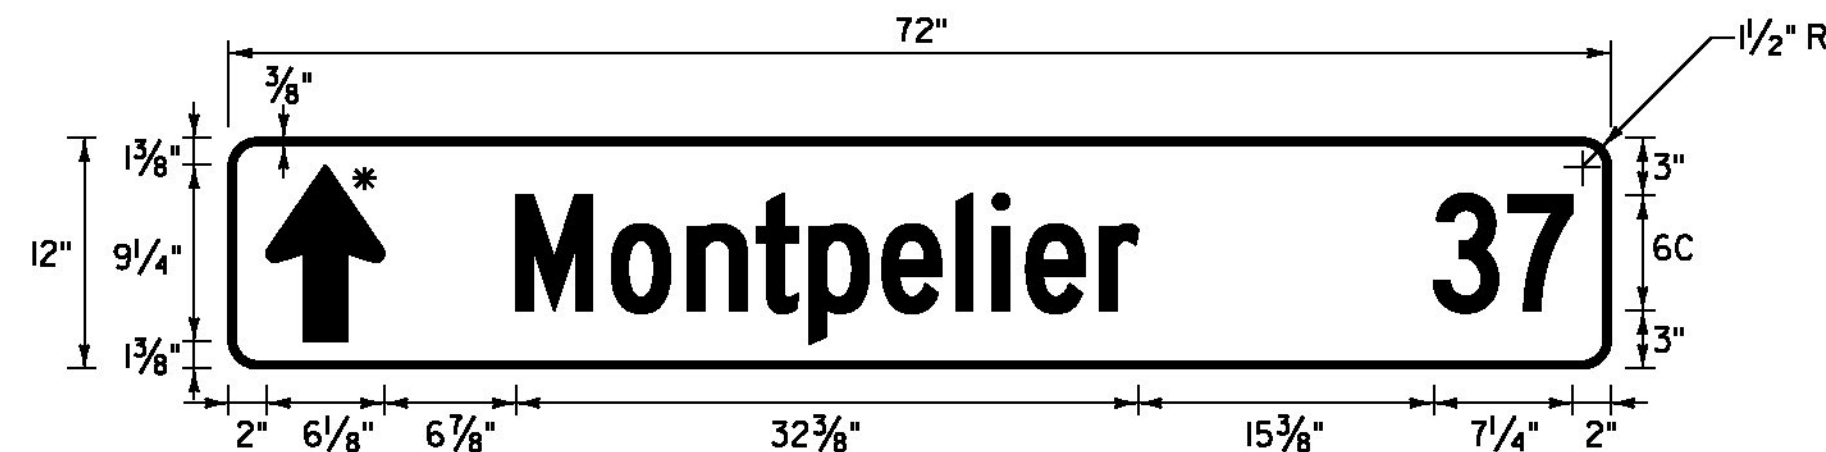

VD1-1a

LOCATION: ST. JOHNSBURY: ALT U.S. ROUTE 5
STA. 29+05, LT
COLOR: WHITE BORDER, ARROW AND TEXT (RETROREFLECTIVE)
GREEN BACKGROUND (RETROREFLECTIVE)
MATERIAL: 0.125" FLAT SHEET ALUMINUM


* FOR ARROW DETAIL SEE SHEET 238

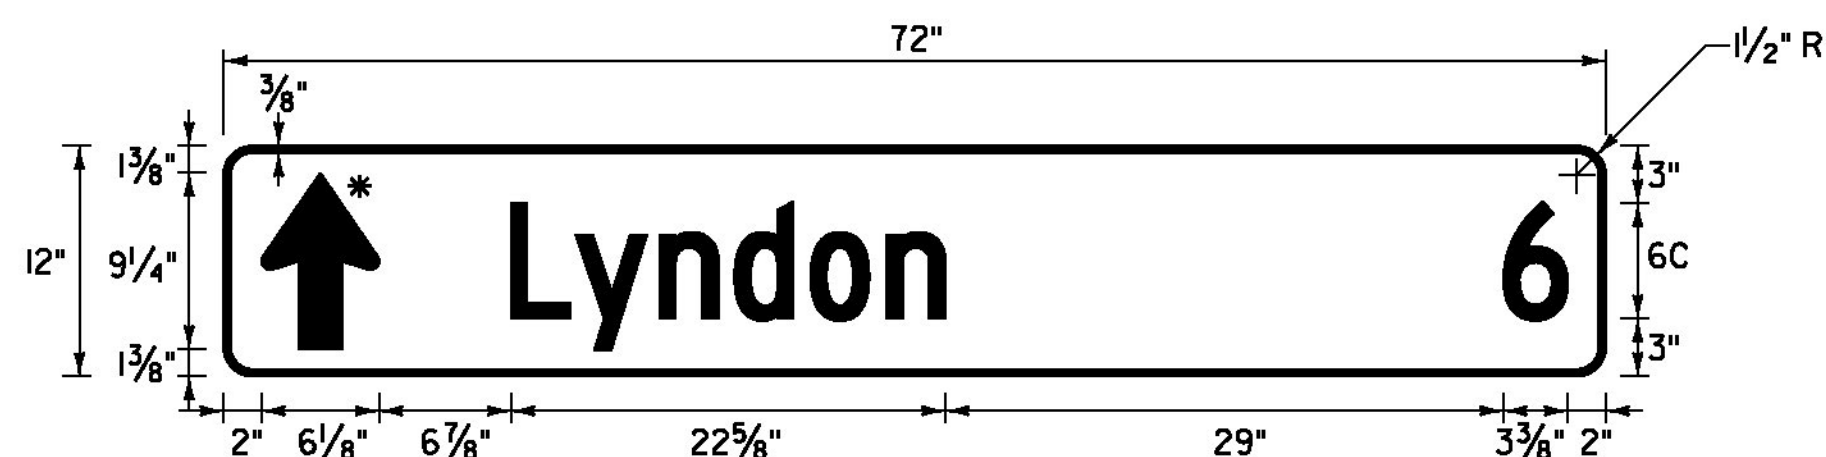

VD1-1a

LOCATION: ST. JOHNSBURY: ALT U.S. ROUTE 5
STA. 64+67, RT
COLOR: WHITE BORDER, ARROW AND TEXT (RETROREFLECTIVE)
GREEN BACKGROUND (RETROREFLECTIVE)
MATERIAL: 0.125" FLAT SHEET ALUMINUM


* FOR ARROW DETAIL SEE SHEET 238

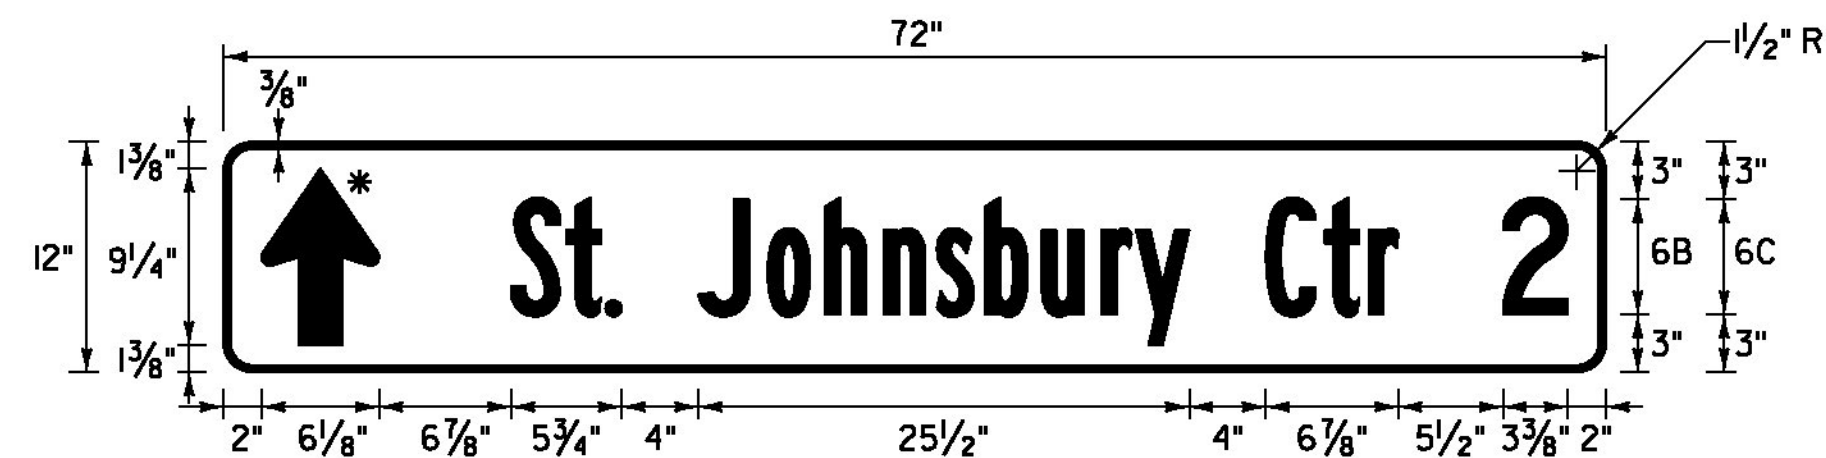

VD1-1a

LOCATION: ST. JOHNSBURY: ALT U.S. ROUTE 5
STA. 64+67, RT
COLOR: WHITE BORDER, ARROW AND TEXT (RETROREFLECTIVE)
GREEN BACKGROUND (RETROREFLECTIVE)
MATERIAL: 0.125" FLAT SHEET ALUMINUM


* FOR ARROW DETAIL SEE SHEET 238

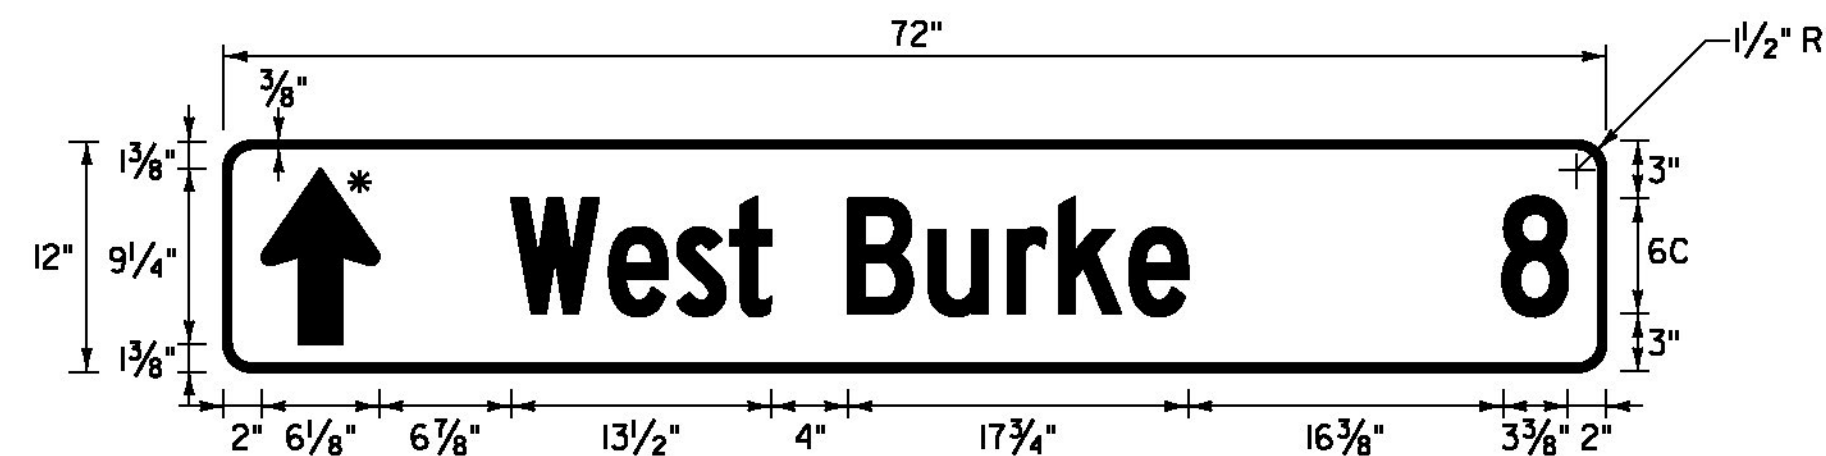

VD1-1a

LOCATION: LYNDON: U.S. ROUTE 5
STA. 147+07, RT
COLOR: WHITE BORDER, ARROW AND TEXT (RETROREFLECTIVE)
GREEN BACKGROUND (RETROREFLECTIVE)
MATERIAL: 0.125" FLAT SHEET ALUMINUM

* FOR ARROW DETAIL SEE SHEET 238

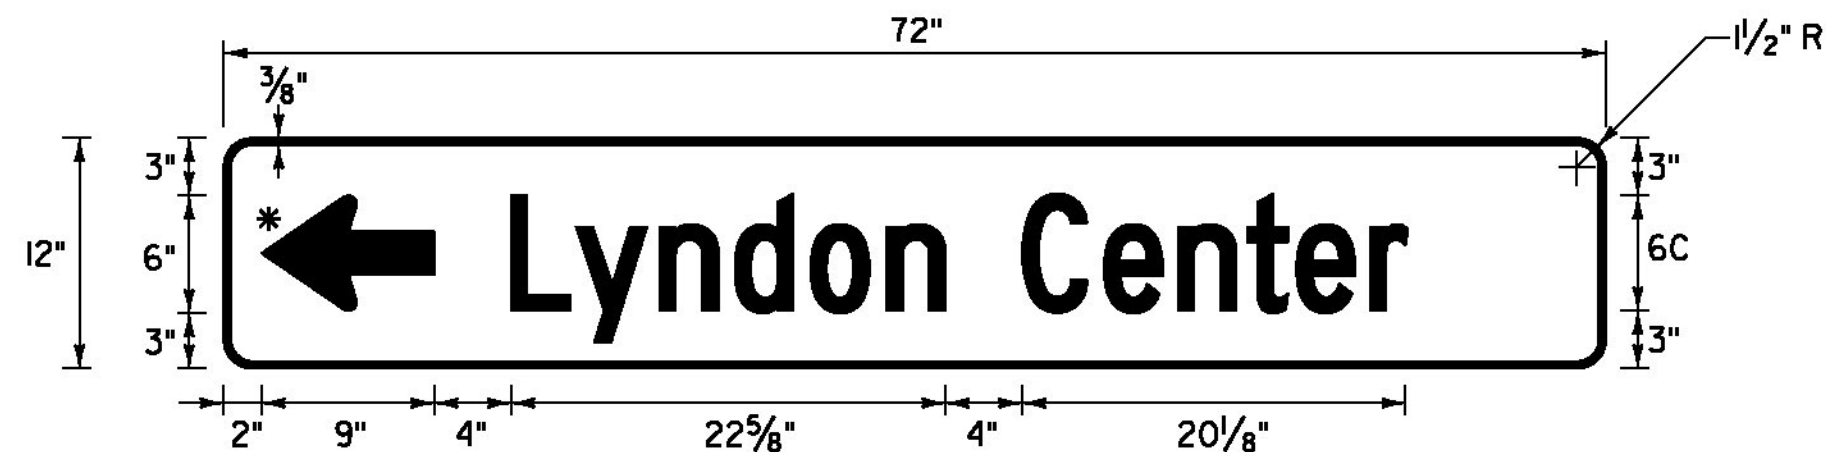

VD1-1

LOCATION: LYNDON: U.S. ROUTE 5
STA. 147+07, RT
COLOR: WHITE BORDER, ARROW AND TEXT (RETROREFLECTIVE)
GREEN BACKGROUND (RETROREFLECTIVE)
MATERIAL: 0.125" FLAT SHEET ALUMINUM


* FOR ARROW DETAIL SEE SHEET 238



VD1-1

LOCATION: LYNDON: U.S. ROUTE 5
STA. 147+07, RT
COLOR: WHITE BORDER, ARROW AND TEXT (RETROREFLECTIVE)
GREEN BACKGROUND (RETROREFLECTIVE)
MATERIAL: 0.125" FLAT SHEET ALUMINUM


* FOR ARROW DETAIL SEE SHEET 238

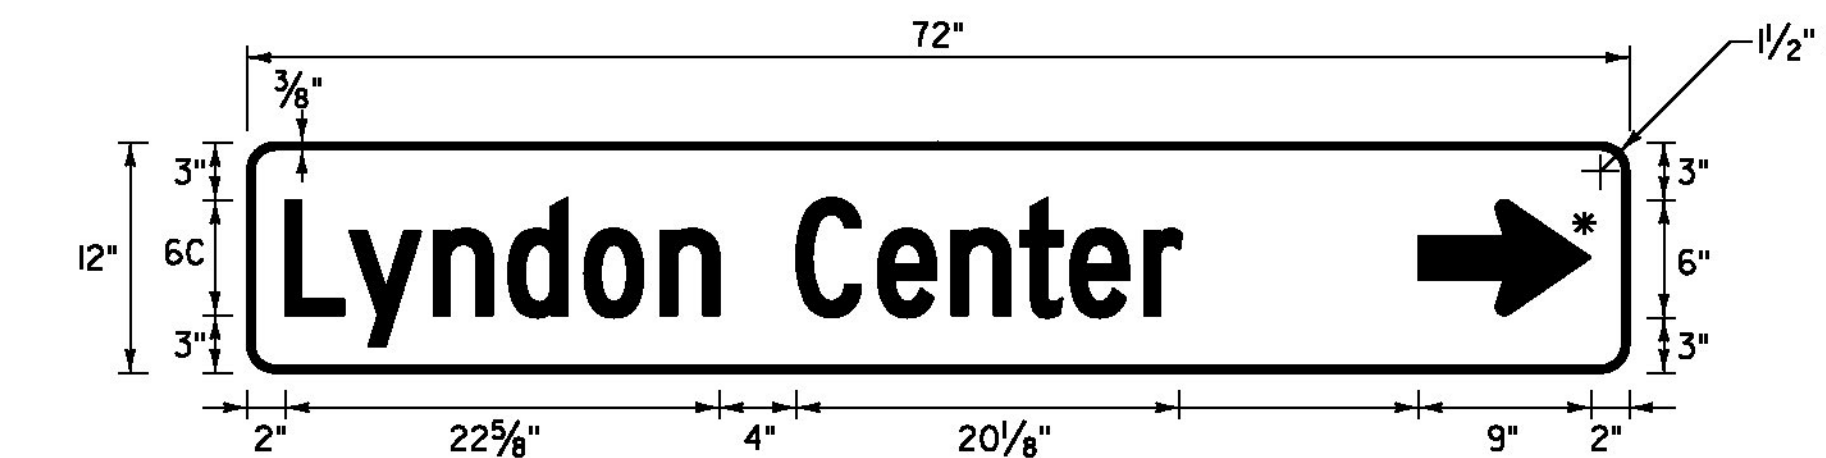

VD1-1

LOCATION: LYNDON: U.S. ROUTE 5
STA. 149+04, LT
COLOR: WHITE BORDER, ARROW AND TEXT (RETROREFLECTIVE)
GREEN BACKGROUND (RETROREFLECTIVE)
MATERIAL: 0.125" FLAT SHEET ALUMINUM

* FOR ARROW DETAIL SEE SHEET 238

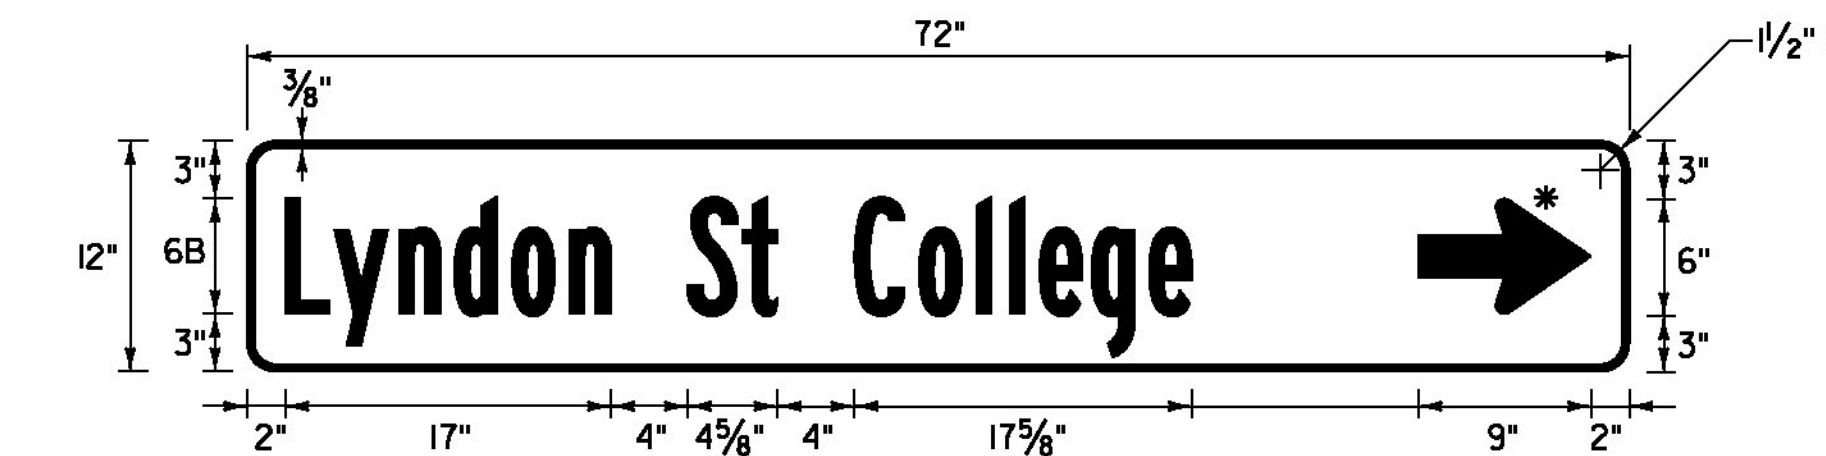

VD1-1

LOCATION: LYNDON: U.S. ROUTE 5
STA. 149+04, LT
COLOR: WHITE BORDER, ARROW AND TEXT (RETROREFLECTIVE)
GREEN BACKGROUND (RETROREFLECTIVE)
MATERIAL: 0.125" FLAT SHEET ALUMINUM

* FOR ARROW DETAIL SEE SHEET 238



NOT TO SCALE

NOTE: SEE TRAFFIC SIGN NOTES ON SHEET 241

**TRAFFIC
SIGN
DETAIL
SHEET #8**

PROJECT NAME: ST JOHNSBURY - LYNDON
PROJECT NUMBER: STP 2936(I)

FILE NAME: pllc308.dgn
PROJECT LEADER: G. EDWARDS
DESIGNED BY: D. DRAPER

PLOT DATE: 5/5/2014
DRAWN BY: D. DRAPER
CHECKED BY: J. LITTLE
SHEET 236 OF 250