


BANKING DIAGRAM - VT 131


HORIZ: 1"=20'
NO VERTICAL SCALE

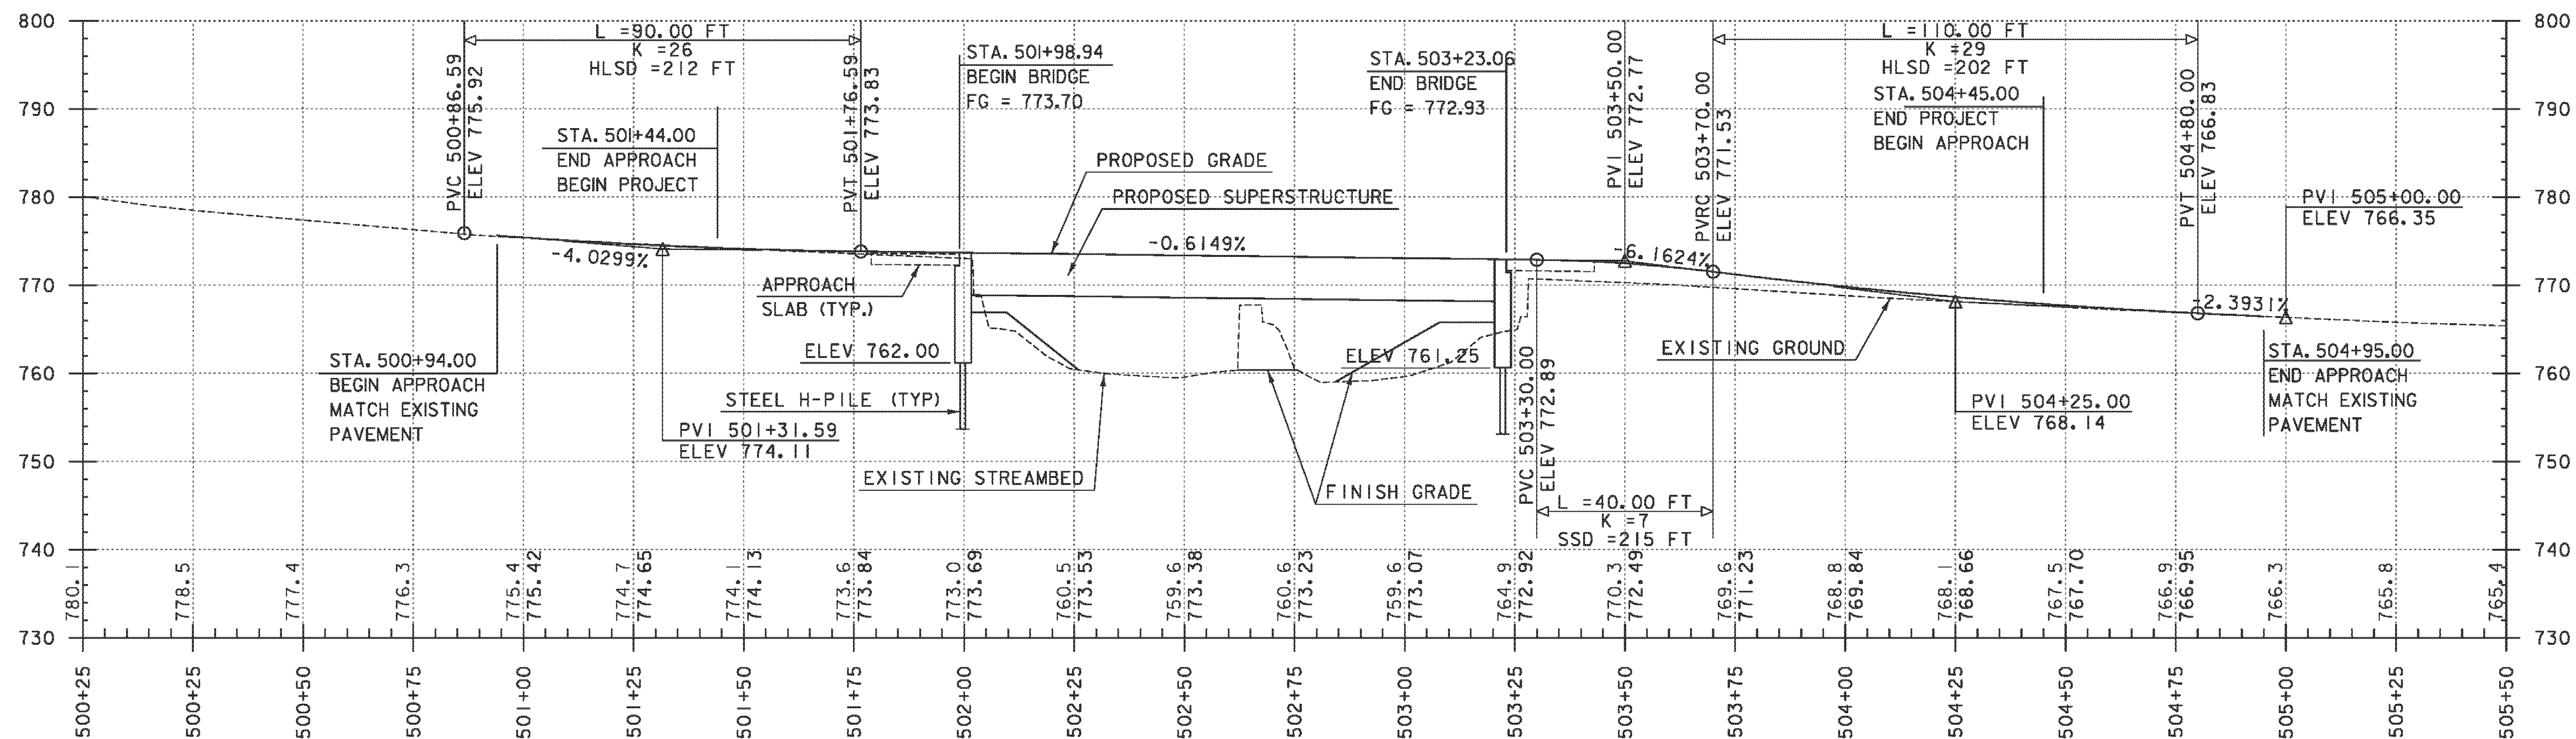

PROFILE - VT 131

THE GRADES SHOWN TO THE NEAREST TENTH ARE THE SURVEYED GROUND ELEVATIONS ALONG THE PROPOSED ALIGNMENT

THE GRADES SHOWN TO THE NEAREST HUNDRETH ARE THE PROPOSED GRADES FOR THE NEW ALIGNMENT

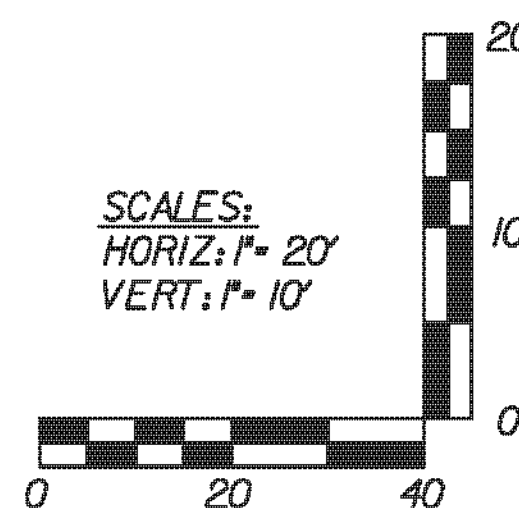

TYL INTERNATIONAL

PROJECT NAME: CAVENDISH
PROJECT NUMBER: ER BRF 0146(13)

FILE NAME: zllc318bdr_pro.dgn
PROJECT LEADER: J. OLUND
DESIGNED BY: J. HOWE
VT 131 PROFILE SHEET

PLOT DATE: 7/19/2013
DRAWN BY: J. HOWE
CHECKED BY: D. BRYANT
SHEET 12 OF 49