



	LEFT EDGE	RIGHT EDGE
MIDDLE A. S. #2 - PANEL E	1'-4 3/8"	1'-4 3/8"
MIDDLE A. S. #2 - PANEL F	1'-4 3/8"	1'-4 3/8"
MIDDLE A. S. #2 - PANEL G	1'-4 3/8"	1'-4 1/8"
MIDDLE A. S. #2 - PANEL H	1'-4 1/8"	1'-3 3/8"
END A. S. #2 - PANEL E	1'-5 3/8"	1'-5"
END A. S. #2 - PANEL F	1'-5"	1'-4 1/2"
END A. S. #2 - PANEL G	1'-4 3/8"	1'-3 3/4"
END A. S. #2 - PANEL H	1'-3 3/4"	1'-3"

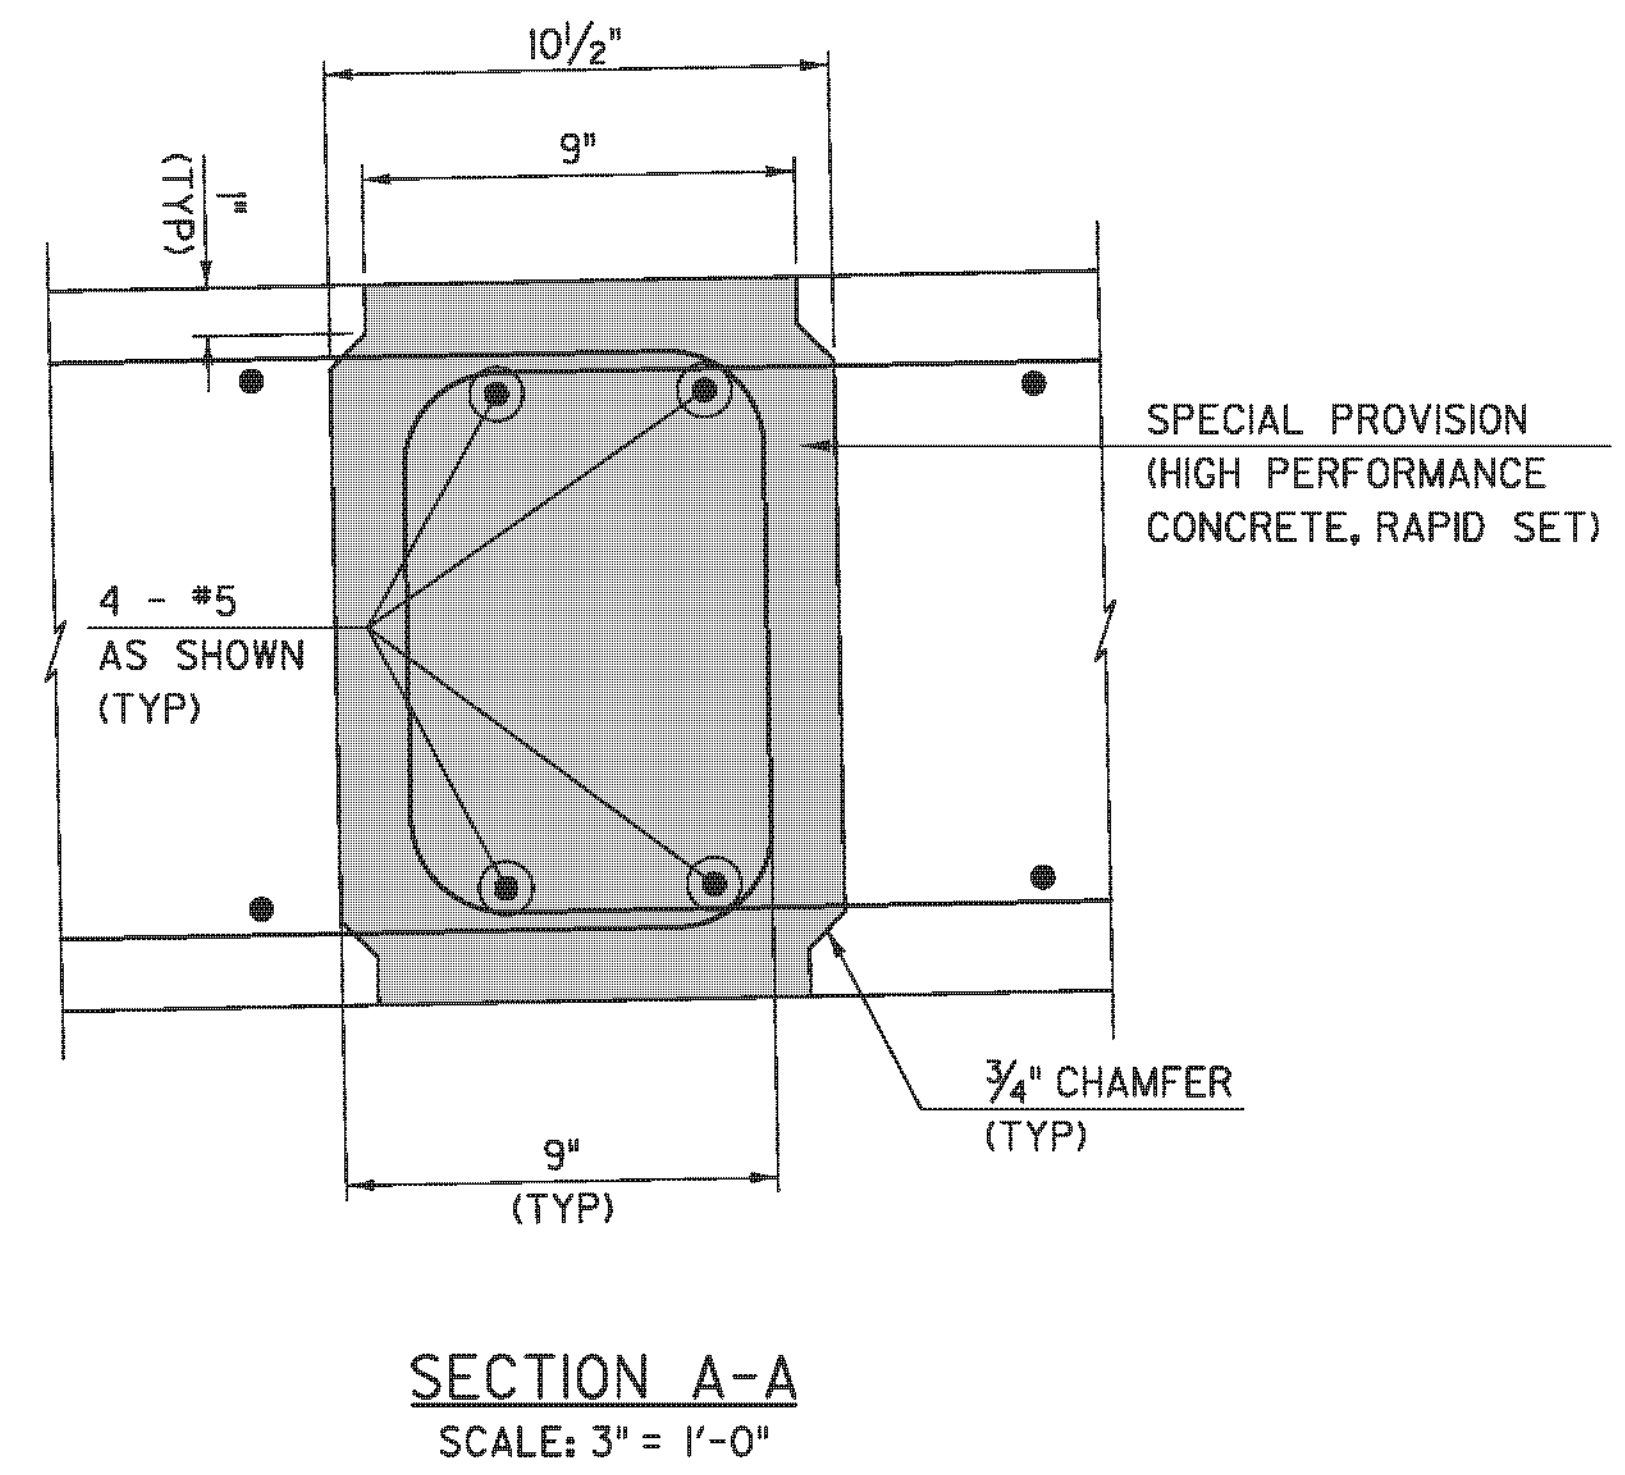

WP1	772.05
WP2	771.93
WP3	772.31
WP4	772.19
WP5	771.98
WP6	771.86
WP7	771.17
WP8	770.81
WP9	771.42
WP10	771.06
WP11	771.10
WP12	770.74

- NOTES:**
- LIFTING DEVICES AND ANY ASSOCIATED REINFORCEMENT SHALL BE DETERMINED BY THE FABRICATOR AND SHOWN IN THE FABRICATION DRAWINGS. LIFTING DEVICES SHALL BE LIMITED TO FOUR (4) PER PANEL AND BE RECESSED AND GROUTED AFTER INSTALLATION OF THE SLABS.
  - THE LOCATION OF THE FOUR INCH DIAMETER HOLES CAST THROUGH THE BRIDGE-END OF THE APPROACH SLABS SHALL BE COORDINATED WITH REINFORCING STEEL EXTENDING FROM THE ABUTMENTS. SEE SHEET 36 FOR ABUTMENT REINFORCING STEEL LAYOUT.
  - CONTRACTOR SHALL BE RESPONSIBLE FOR ESTABLISHING UNIFORM CONTACT BETWEEN THE APPROACH SLAB AND THE SUBBASE MATERIAL TO THE SATISFACTION OF THE ENGINEER. THE FABRICATION DRAWINGS SHALL INDICATE THE MEANS AND METHODS NECESSARY TO INSTALL THE APPROACH SLABS TO THE ELEVATIONS SPECIFIED.
  - PAYMENT FOR APPROACH SLABS, THE #5 REINFORCING BARS WITHIN THE CLOSURE POURS, AND ALL LABOR AND TOOLS NECESSARY TO INSTALL THE SLABS SHALL BE MADE UNDER ITEM 540.10, "PRECAST CONCRETE STRUCTURE (APPROACH SLAB NO. 1)" AND/OR ITEM 540.10, "PRECAST CONCRETE STRUCTURE (APPROACH SLAB NO. 2)".
  - PAYMENT FOR CONCRETE CLOSURE POURS SHALL BE MADE UNDER ITEM 900.608, "SPECIAL PROVISION (HIGH PERFORMANCE CONCRETE, RAPID SET)".
  - APPROACH SLAB REINFORCING STEEL SHOWN IS TYPICAL FOR EACH PANEL.

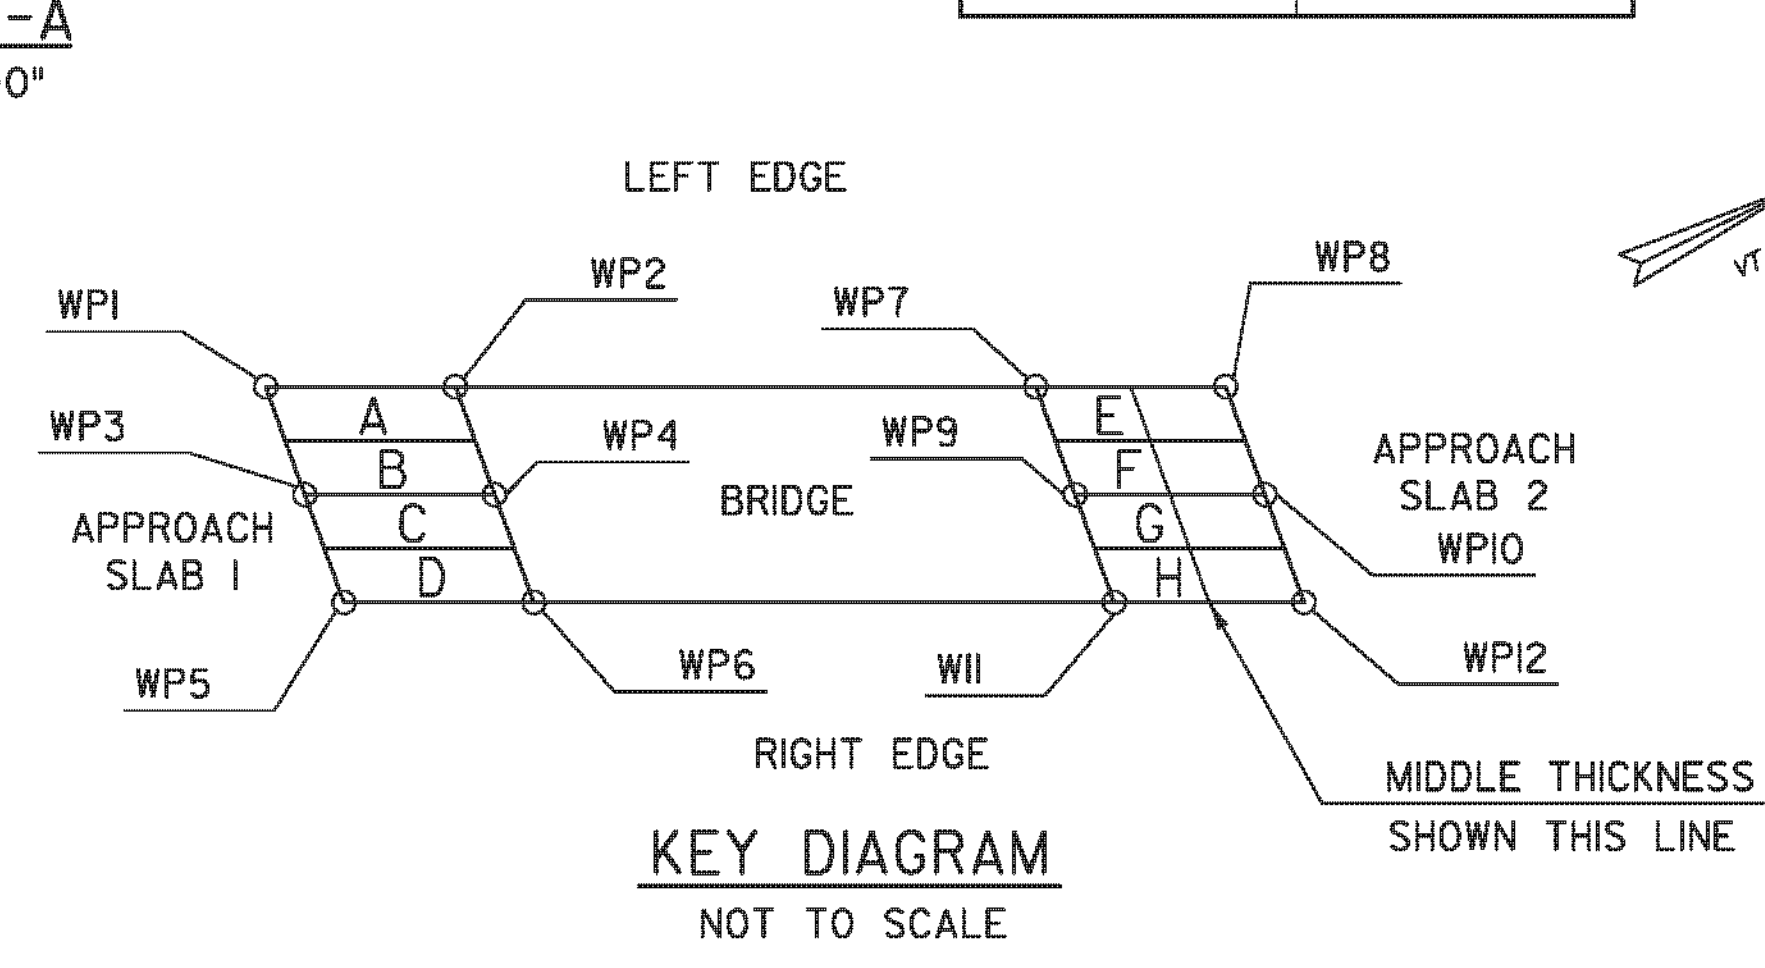

<b>TYLIN INTERNATIONAL</b>	PROJECT NAME: CAVENDISH	PLOT DATE: 7/19/2013
	PROJECT NUMBER: ER BRF 0146(13)	DRAWN BY: S. MORGAN
	FILE NAME: zllc318bdrapprslab.dgn	CHECKED BY: J. OLUND
	PROJECT LEADER: J. OLUND	SHEET 37 OF 49
	DESIGNED BY: T. POULIN	
	APPROACH SLAB DETAILS	