



501+00

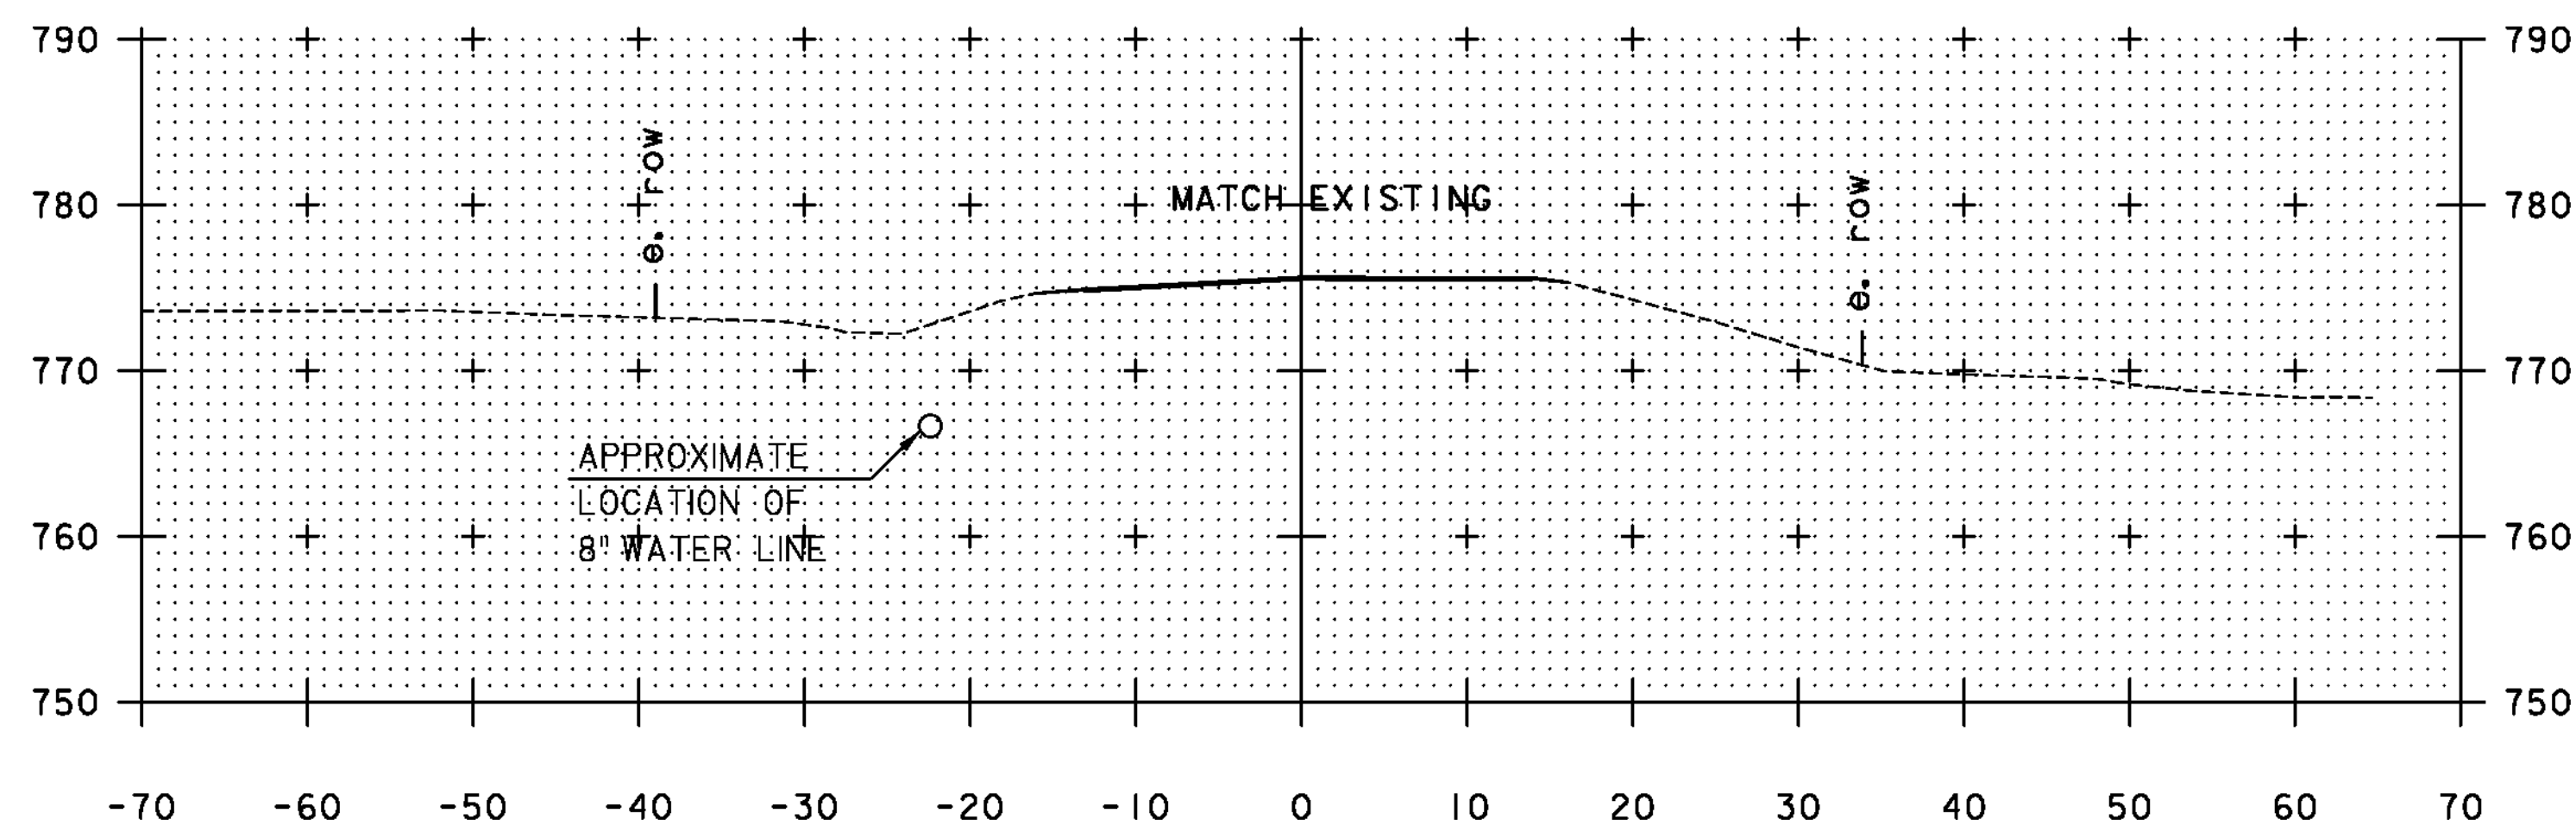


500+94

BEGIN APPROACH

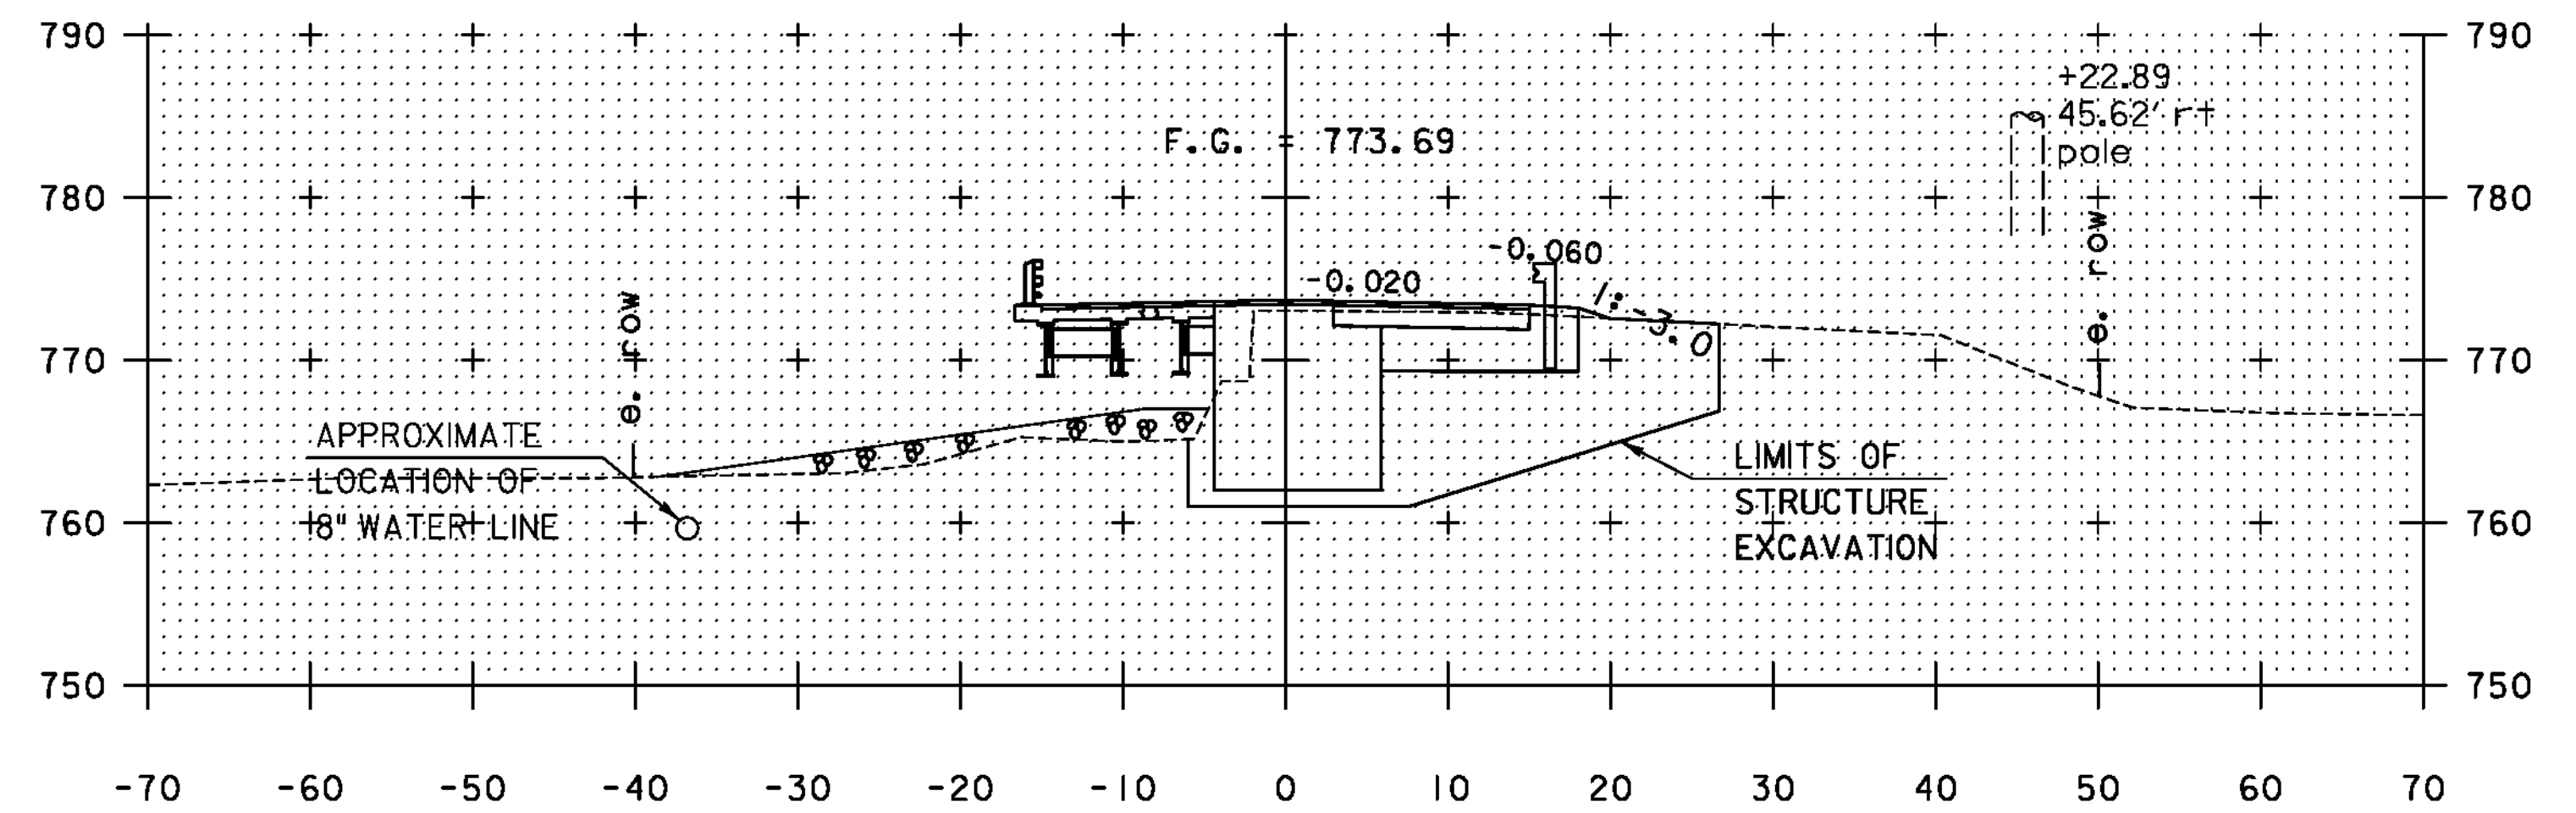

502+00

STA 501+98.94
BEGIN BRIDGE

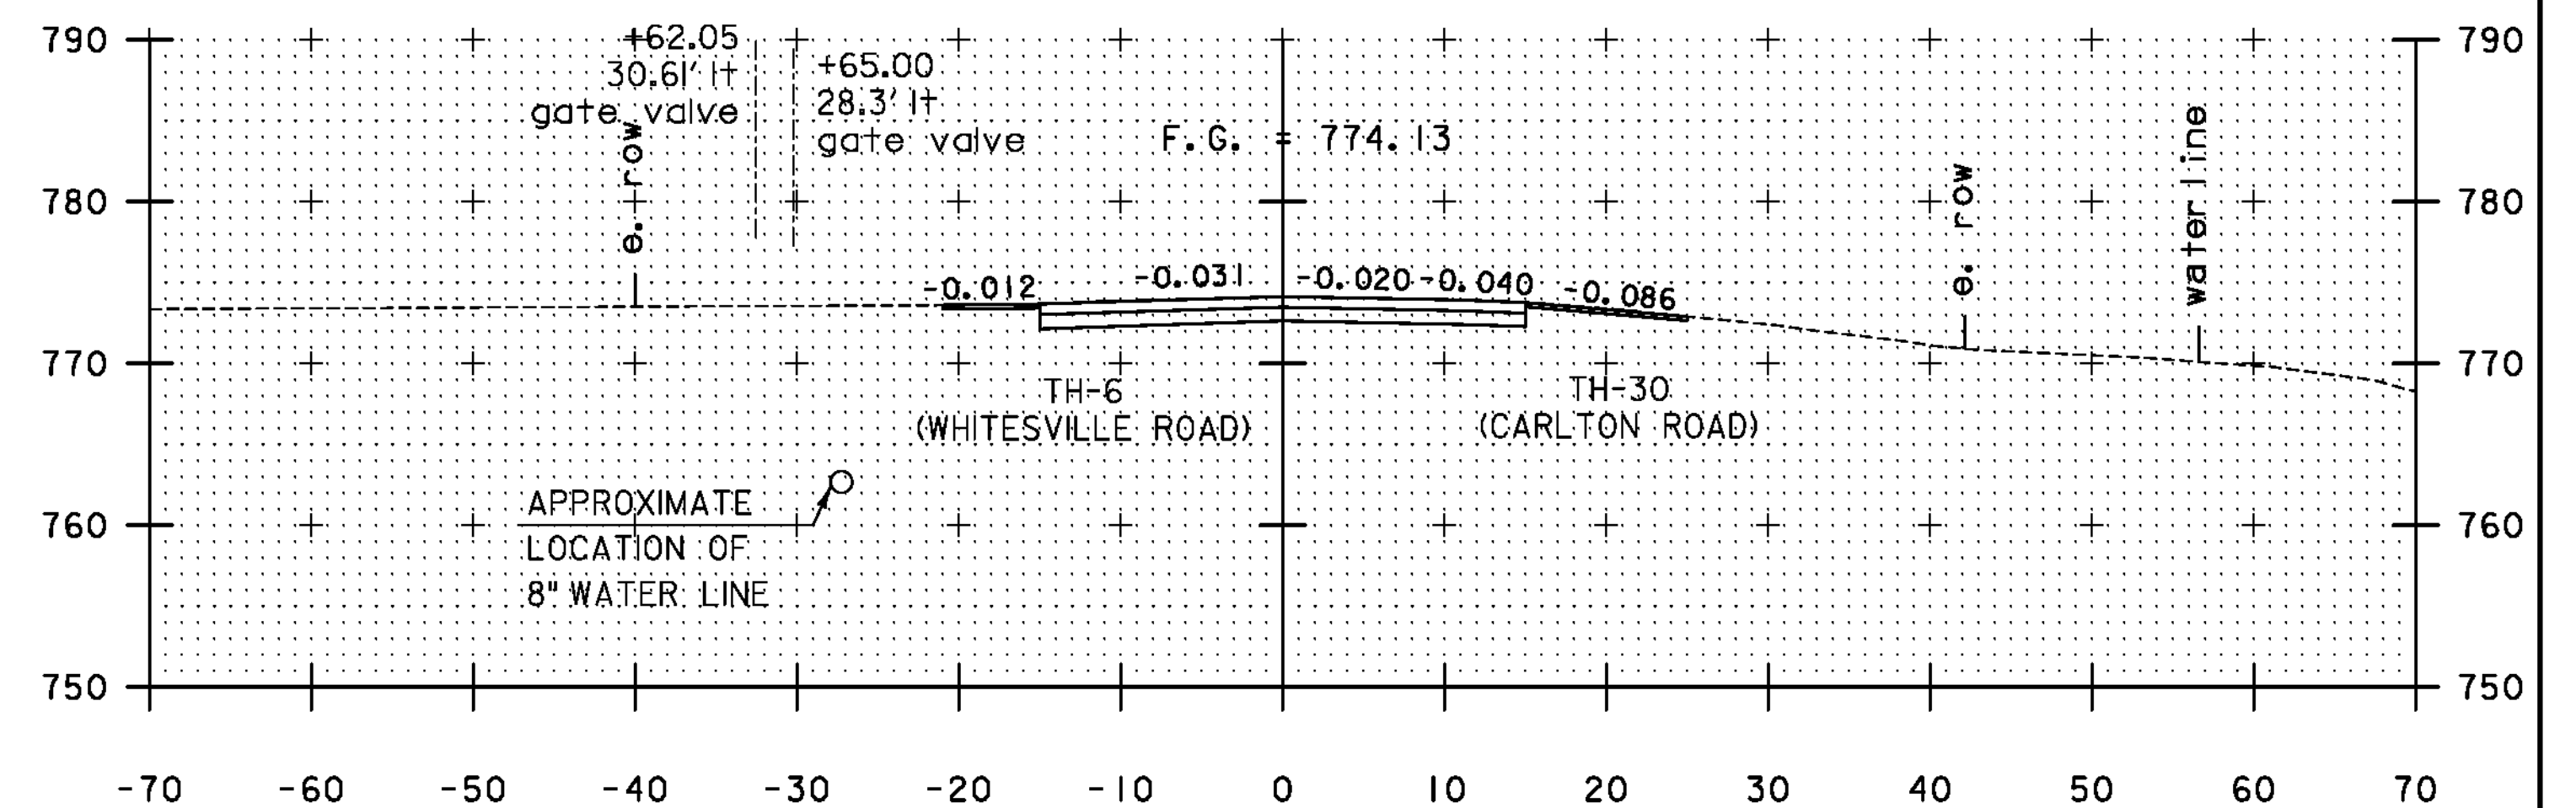

501+50

STA 501+44
END APPROACH
BEGIN PROJECT

STA. 500+94 TO STA. 502+00

PROJECT NAME: CAVENDISH
PROJECT NUMBER: ER BRF 0146(13)

SCALE 1" = 10' - 0"
10 0 10

TYLINTERNATIONAL

FILE NAME: zllc3l8bdr_xs.dgn
PROJECT LEADER: J. OLUND
DESIGNED BY: J. HOWE
VT 131 CROSS SECTIONS I

PLOT DATE: 7/19/2013
DRAWN BY: J. DAVIS
CHECKED BY: D. BRYANT
SHEET 39 OF 49