







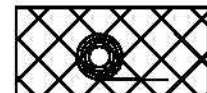

SEDIMENTATION DEWATERING LOCATION
MAY BE PROPOSED TO BE WITHIN THE
APPROACH AREA BEHIND THE ABUTMENT
(CONTRACTOR TO PROVIDE DETAILS AND
METHODOLOGY, SEE EROSION AND SEDIMENT
CONTROL NOTE 1.4.11)

LEGEND:

-  EROSION CONTROL MATTING
(SEE NOTES)
-  FILTER CURTAIN
-  PROJECT DEMARCATION
FENCE
-  SILT FENCE
-  STABILIZED CONSTRUCTION ENTRANCE
-  STONE FILL, TYPE IV
-  SURFACE ROUGHENING
-  TEMPORARY
CONSTRUCTION LIMITS

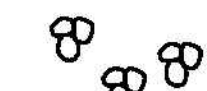EPSC EROSION CONTROL

NOTE:
FILTER CURTAIN SHALL ONLY BE
USED ON ONE SIDE OF THE RIVER
AT A TIME.

SCALE 1" = 20' - 0"
20 0 20

TYLINTERNATIONAL

PROJECT NAME: CAVENDISH	PLOT DATE: 7/19/2013
PROJECT NUMBER: ER BRF 0146(13)	DRAWN BY: D. BURHANS
FILE NAME: zllc3l8bdr_ero_c.dgn	CHECKED BY: D. BRYANT
PROJECT LEADER: J. OLUND	SHEET 46 OF 49
DESIGNED BY: D. BURHANS	
EPSC CONSTRUCTION CONDITION LAYOUT	