


PBU #1 EXTERIOR UNIT

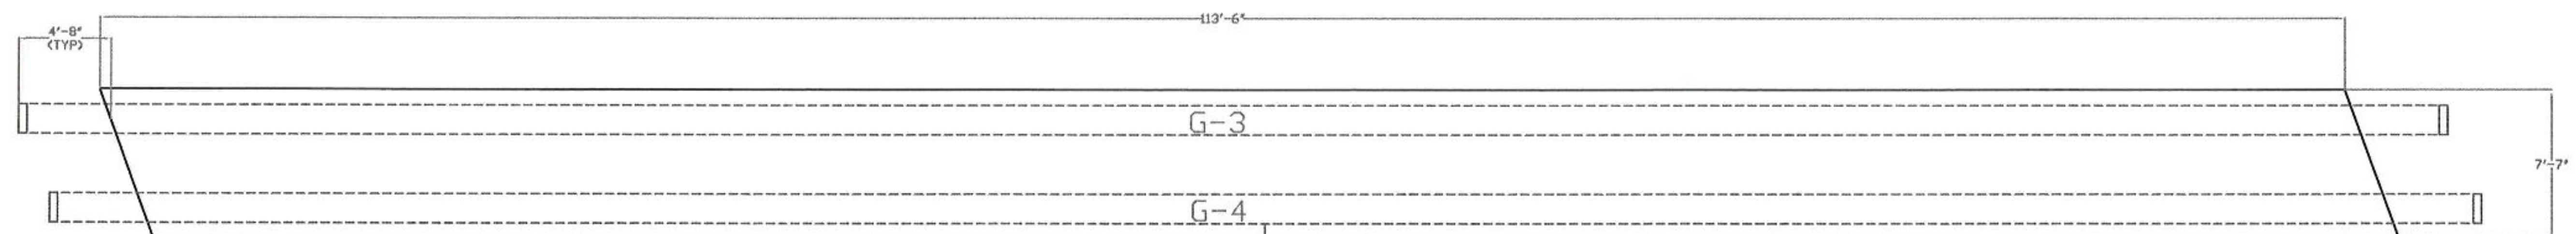

PBU #2 INTERIOR UNIT

**T.Y. LIN INTERNATIONAL**

THE STAMPED DOCUMENTS ARE HEREBY:

- APPROVED
- APPROVED AS NOTED
- REVISE AND RESUBMIT

SEE TRANSMITTAL FOR ADDITIONAL INFORMATION AS APPLICABLE.

THIS REVIEW IS FOR GENERAL CONFORMANCE WITH DESIGN CONCEPT ONLY. ANY DEVIATION FROM THE PLANS OR SPECIFICATIONS NOT CLEARLY NOTED BY THE CONTRACTOR HAS NOT BEEN REVIEWED. REVIEW BY THE ENGINEER SHALL NOT RELIEVE THE CONTRACTOR OF THE CONTRACTUAL RESPONSIBILITY FOR ANY ERRORS OR DEVIATION FROM THE CONTRACT REQUIREMENTS.

JOSH OLUND  
REVIEWER

03/21/2014  
DATE

Vermont Agency of Transportation

**RECEIVED**

ON: **March 17, 2014**

and Checked for  
**CONFORMANCE**

BY: Rob Young DATE: 03/24/2014

(REVISION #1 2/17/2014) (REVISION #2 3/17/2014)

COLD RIVER BRIDGES, LLC	
10 LANBRO LANE	
TEL 603-756-9300	WALPOLE, NH FAX 603-756-9303
CAVENDISH ER BRF 0146(13)	
PBU #1, AND #2	SHEET NUMBER
DATE: 2-17-14	scale:
	2