

BEARING ADJUSTMENT FOR CASTING BED

CASTING SEQUENCE:
 1.SET CONCRETE BLOCKS ON COMPACTED SUB-GRADE
 2.INSTALL HARDWOOD BLOCKING, DOUBLE BEAMS,AND 12X25 CHANNEL TRACK.
 3.SET INDIVIDUAL PLATE GIRDERS,SHIM TO GRADE.
 5.BOLT AND TORQUE INDIVIDUAL PBU SECTIONS.
 6.PROFILE INDIVIDUAL GIRDERS AND CALCULATE BLOCKING DISTANCE***
 6.TIE R-BAR, BUILD BULK-HEADS PBU-UNITS 1-4
 7.SET SCREED, TEST RUN
 8.CAST PBU DECK SECTIONS 1-4,SIMUTANEDUSLY

Vermont Agency of Transportation

RECEIVED

ON: **March 17, 2014**

and Checked for

CONFORMANCE

BY: Rob Young DATE: 03/24/2014

T.Y. LIN INTERNATIONAL

THE STAMPED DOCUMENTS ARE HEREBY:


- APPROVED
- APPROVED AS NOTED
- REVISE AND RESUBMIT

SEE TRANSMITTAL FOR ADDITIONAL INFORMATION AS APPLICABLE.

THIS REVIEW IS FOR GENERAL CONFORMANCE WITH DESIGN CONCEPT ONLY. ANY DEVIATION FROM THE PLANS OR SPECIFICATIONS NOT CLEARLY NOTED BY THE CONTRACTOR HAS NOT BEEN REVIEWED. REVIEW BY THE ENGINEER SHALL NOT RELIEVE THE CONTRACTOR OF THE CONTRACTUAL RESPONSIBILITY FOR ANY ERRORS OR DEVIATION FROM THE CONTRACT REQUIREMENTS.

JOSH OLUND
REVIEWER

03/21/2014
DATE

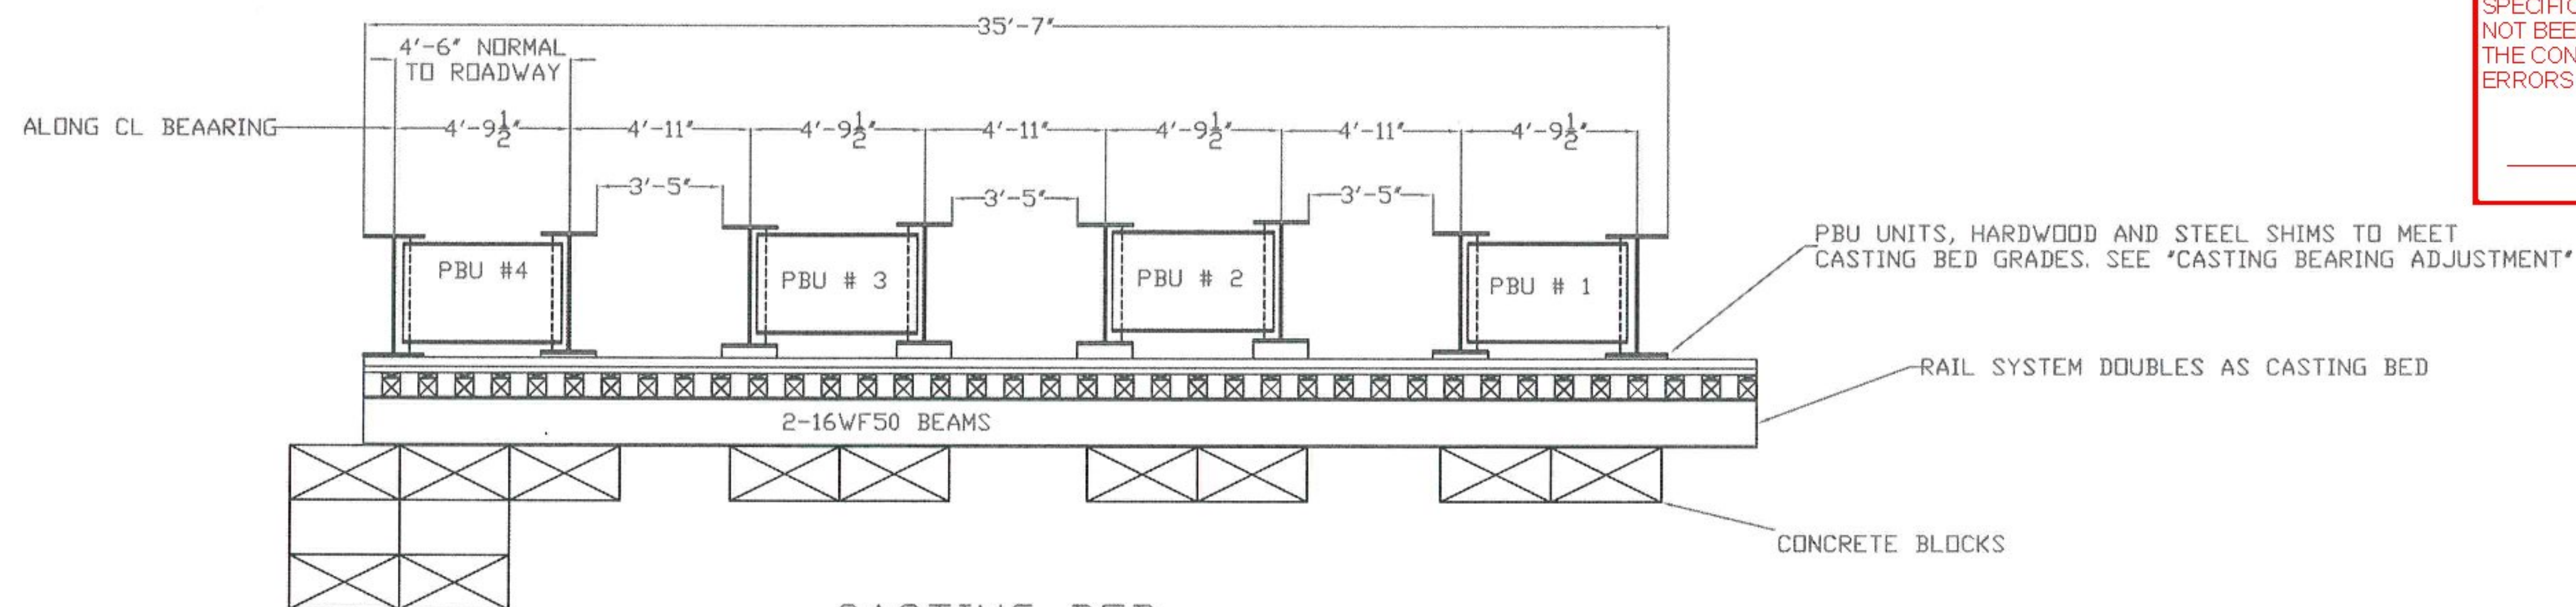

CASTING BED

(REVISION #1 2/17/2014)

COLD RIVER BRIDGES, LLC
 10 LANBRO LANE
 WALPOLE, NH
 TEL 603-756-9300 FAX 603-756-9303

CAVENDISH ER BR 0146(13)

PBU-CASTING PLAN	SHEET NUMBER
DATE: 2-17-14 scale:	10