


TYPICAL END ASSEMBLY DETAIL

Vermont Agency of Transportation  
**RECEIVED**  
 ON: February 28, 2014  
 and Checked for  
**CONFORMANCE**  
 BY: Rob Young DATE: 03/07/2014

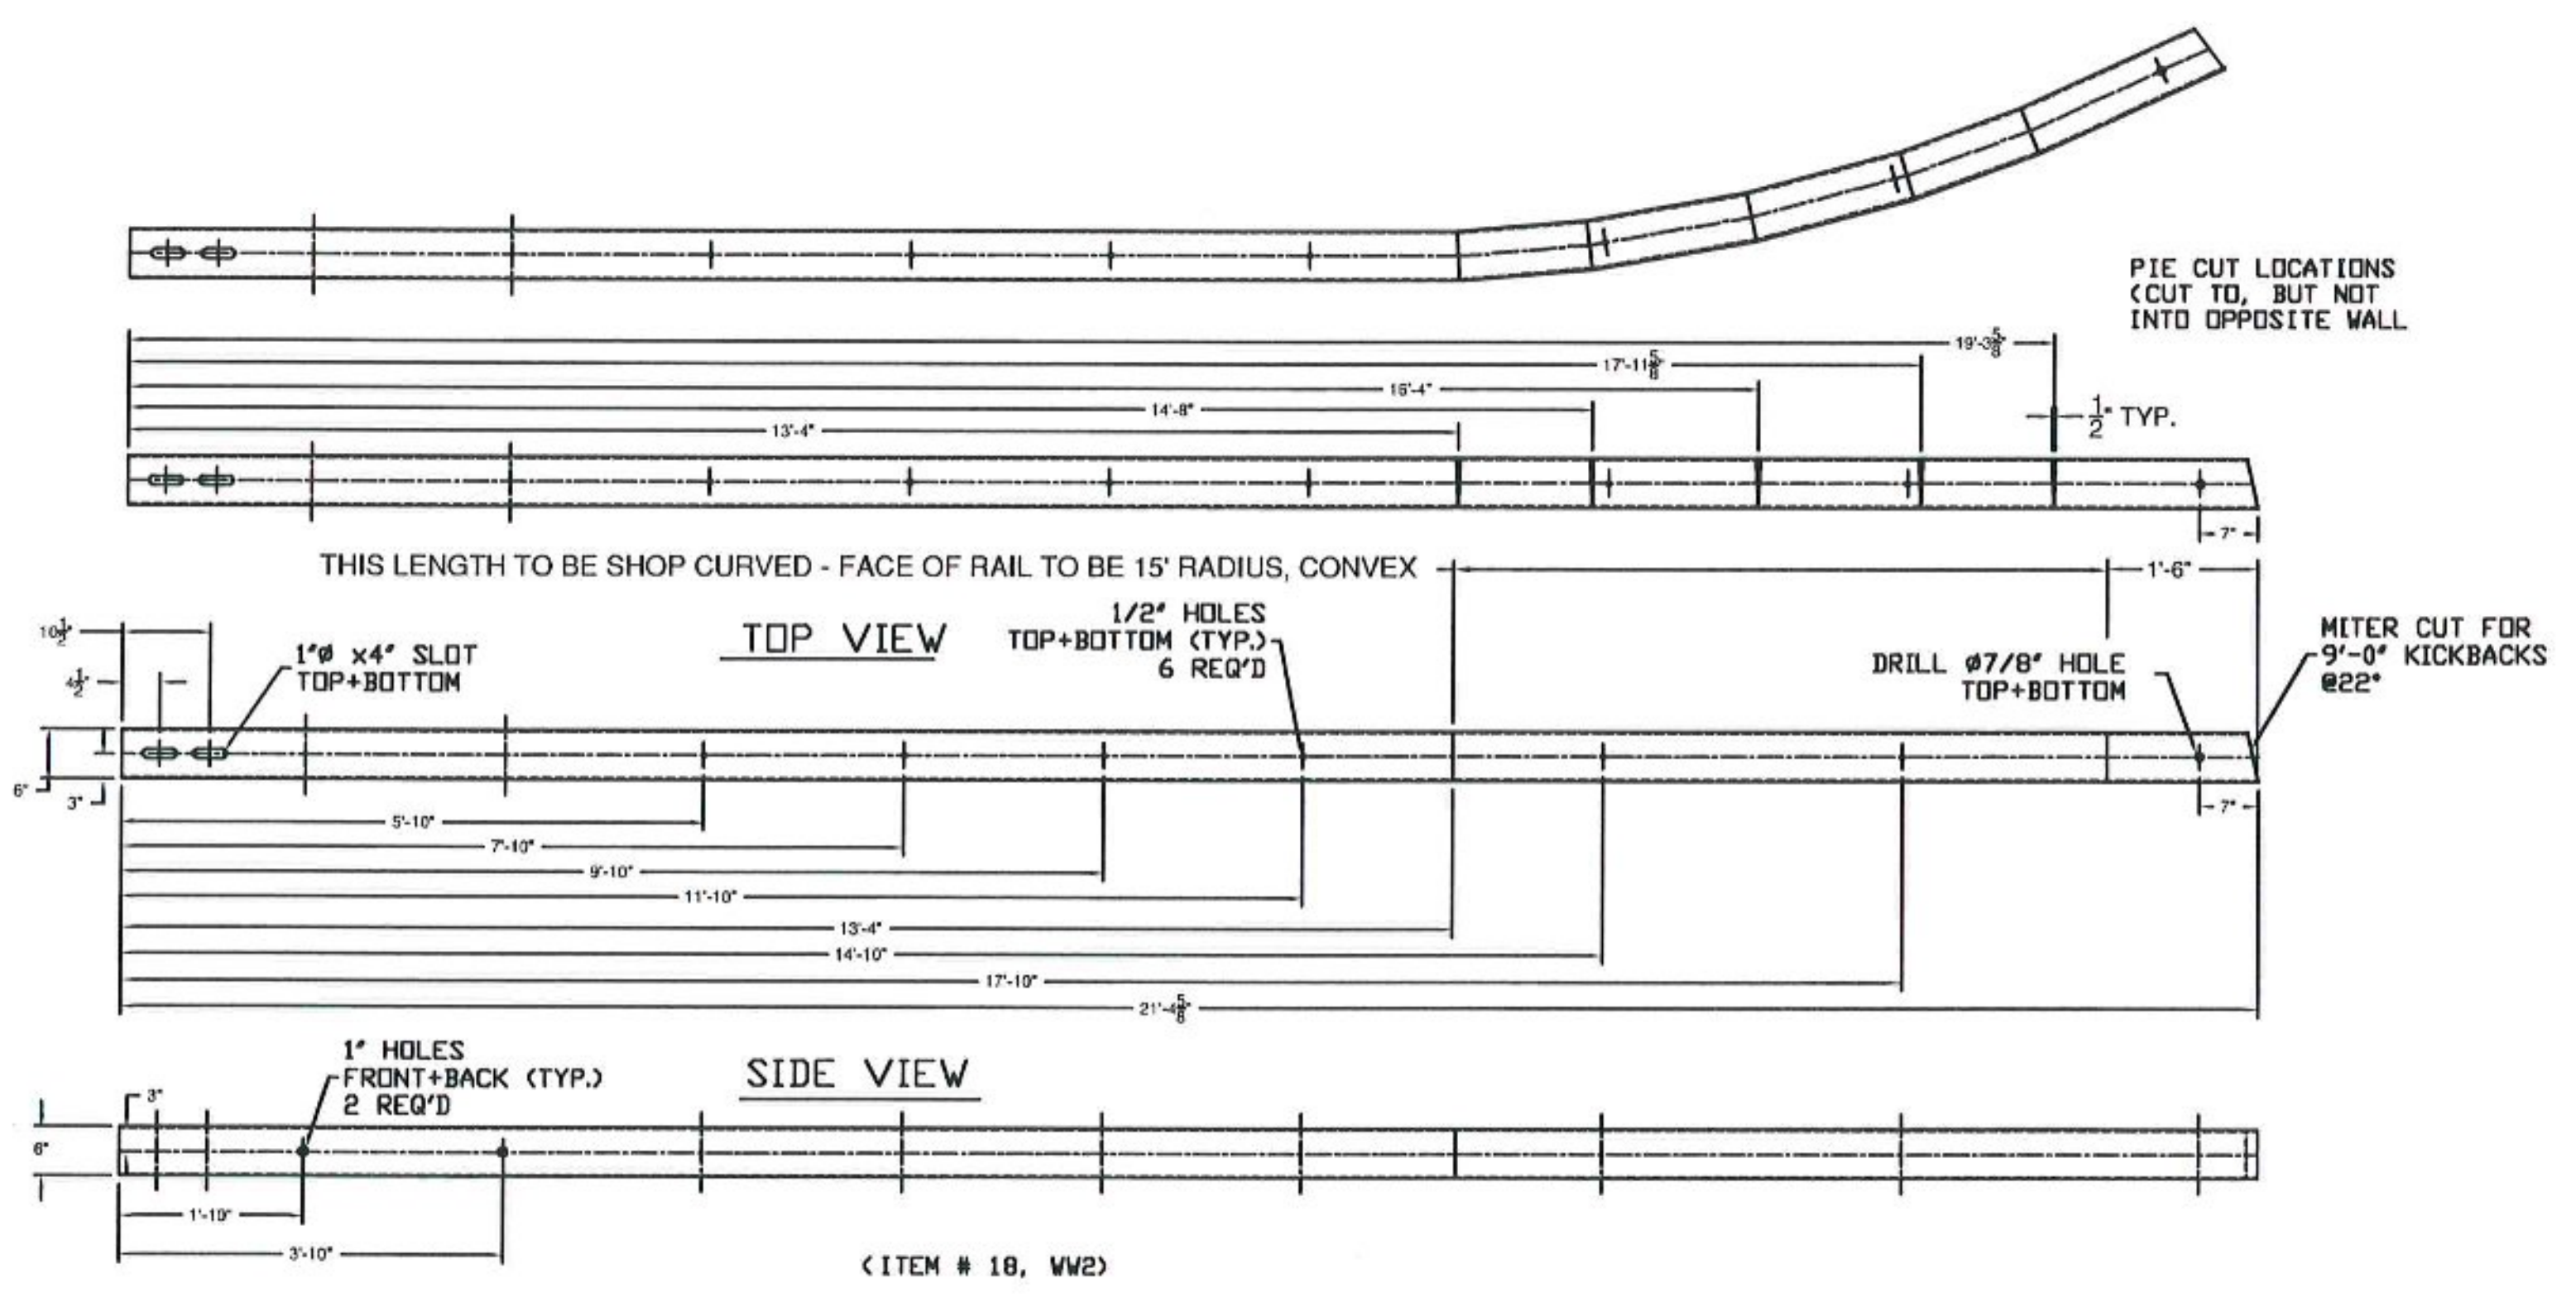

**T.Y. LIN INTERNATIONAL**

THE STAMPED DOCUMENTS ARE HEREBY:

- APPROVED
- APPROVED AS NOTED
- REVISE AND RESUBMIT

SEE TRANSMITTAL FOR ADDITIONAL INFORMATION AS APPLICABLE.

THIS REVIEW IS FOR GENERAL CONFORMANCE WITH DESIGN CONCEPT ONLY. ANY DEVIATION FROM THE PLANS OR SPECIFICATIONS NOT CLEARLY NOTED BY THE CONTRACTOR HAS NOT BEEN REVIEWED. REVIEW BY THE ENGINEER SHALL NOT RELIEVE THE CONTRACTOR OF THE CONTRACTUAL RESPONSIBILITY FOR ANY ERRORS OR DEVIATION FROM THE CONTRACT REQUIREMENTS.

JOSH OLUND 02/28/2014  
 REVIEWER DATE

ITEM #: 621.725 F.R. LAFAYETTE, CAVENDISH SHEET 8 OF 10

**GUARD RAIL TO BRIDGE RAIL TRANSITION DETAILS SHEET**  
 CAVENDISH, ER BR# 0416 (13), ROUTE VT 131, OVER TWENTY MILE STREAM  
 VERMONT

R NO.	DATE	DESCRIPTION	BY	R NO.	DATE	DESCRIPTION	BY
E 1	2/17/14	REVISED PER 12/20/13 MARK-UP	EP E				
V 2	2/27/14	REVISED PER 2/18/14 MARK-UP	EP V				

APPROVED BY: \_\_\_\_\_

**ELDERLEE, INC.**  
 OAKS CORNERS, NEW YORK 14518  
 E-Mail: dlong@elderlee.com  
 Tel: 315-789-6670 Fax: 315-789-6615

DRAWN	E.P.	11/13/13
CHECKED	D.L.	11/20/13
APPROVED		
SCALE	SCHEMATIC	
DRAWING NO. F.L. LAFAYETTE, CAVENDISH		