



NOTE:  
 USE MECHANICAL CONNECTOR #6 EPOXY COATED IN  
 WINGWALLS AND ABUTMENTS EACH FACE AND SEAT LEVEL  
 EPOXY COATED MECH CONNECTORS APPROVED BY PROJECT  
 MANAGER 11-19-13-GALVANIZED NOT REQUIRED

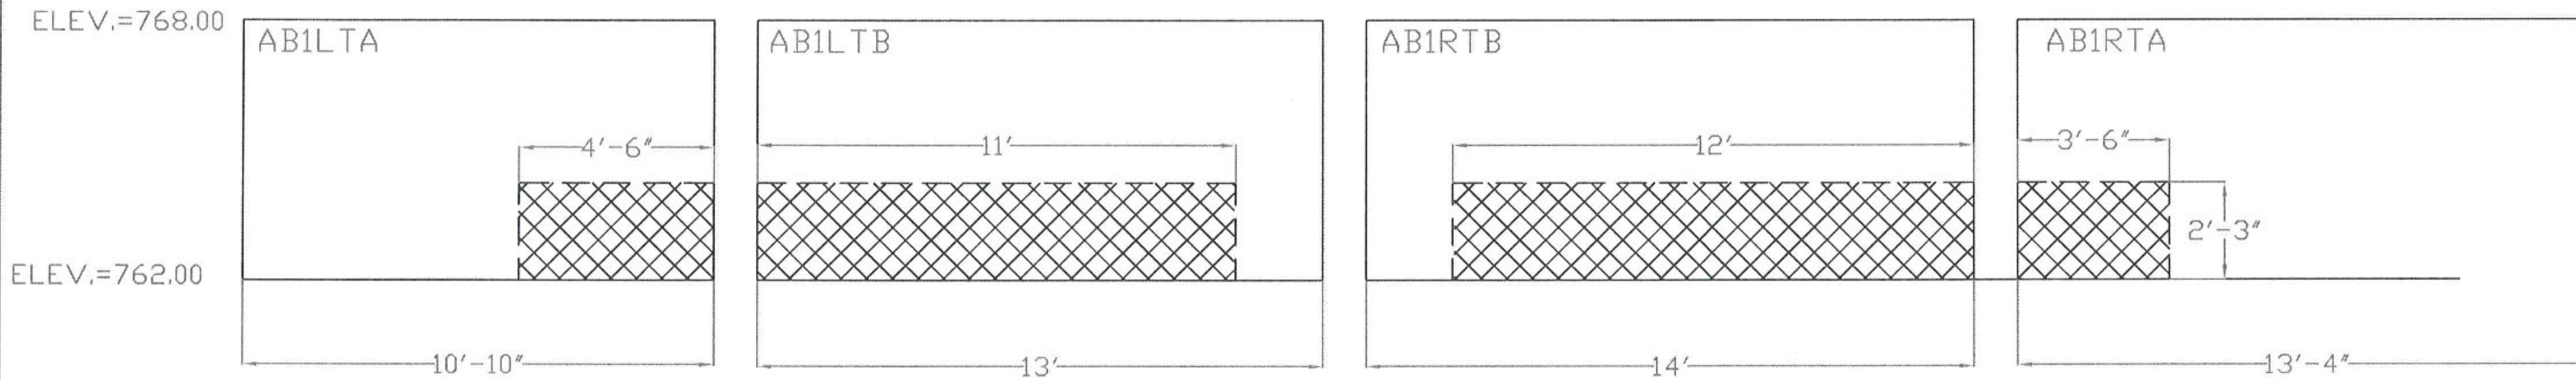

CASTING SEQUENCE

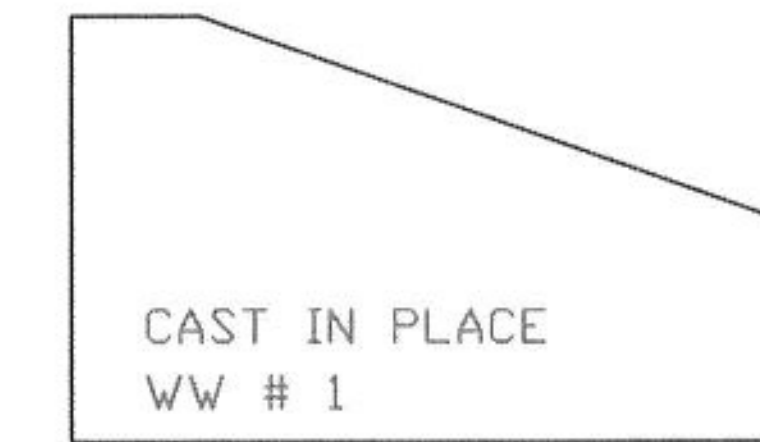

ABUTMENT 1 ELEVATION VIEW

REVISION # 1 11-19-13  
 REVISION # 2 12-6-13

COLD RIVER BRIDGES, LLC	
10 LANBRO LANE	
TEL 603-756-9300	WALPOLE, NH FAX 603-756-9303
CAVENDISH ER BRF 0146(13)	
ABUTMENT 1 PLAN	SHEET NUMBER
DATE: 10-2-13	Scale:
	3