



NOTE:
 USE MECHANICAL CONNECTOR #6 EPOXY COATED IN
 WINGWALLS AND ABUTMENTS EACH FACE AND SEAT LEVEL
 EPOXY COATED MECH CONNECTORS APPROVED BY PROJECT
 MANAGER 11-19-13-GALVANIZED NOT REQUIRED




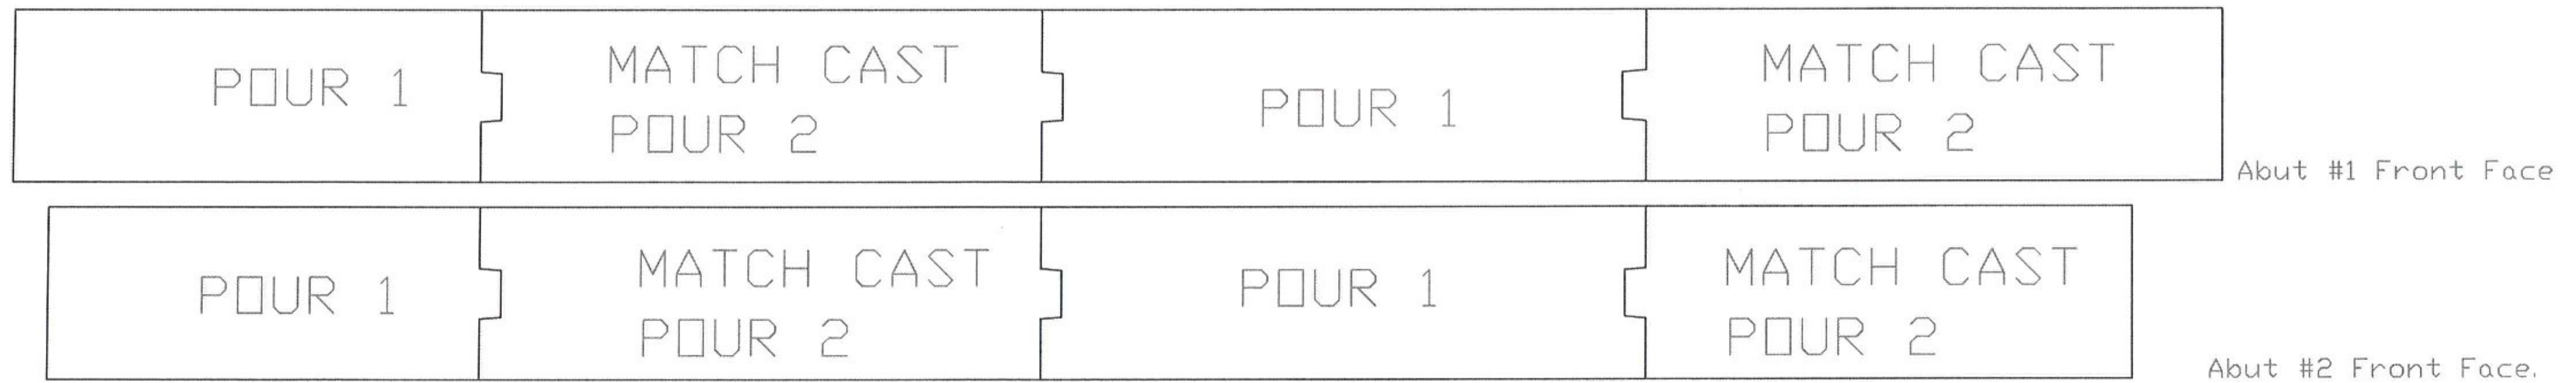


CASTING SEQUENCE

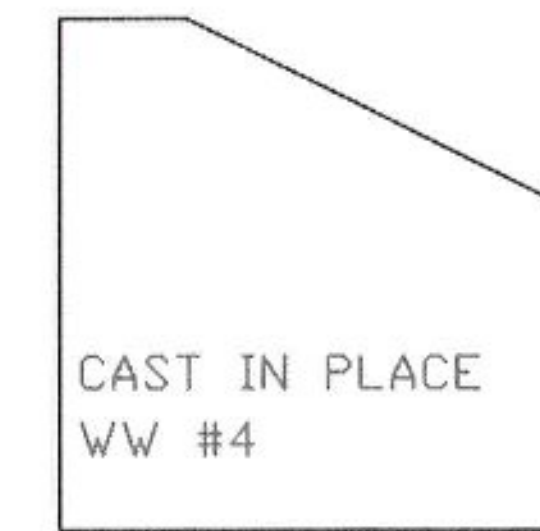

ELEV.=767.25

ELEV.=761.25

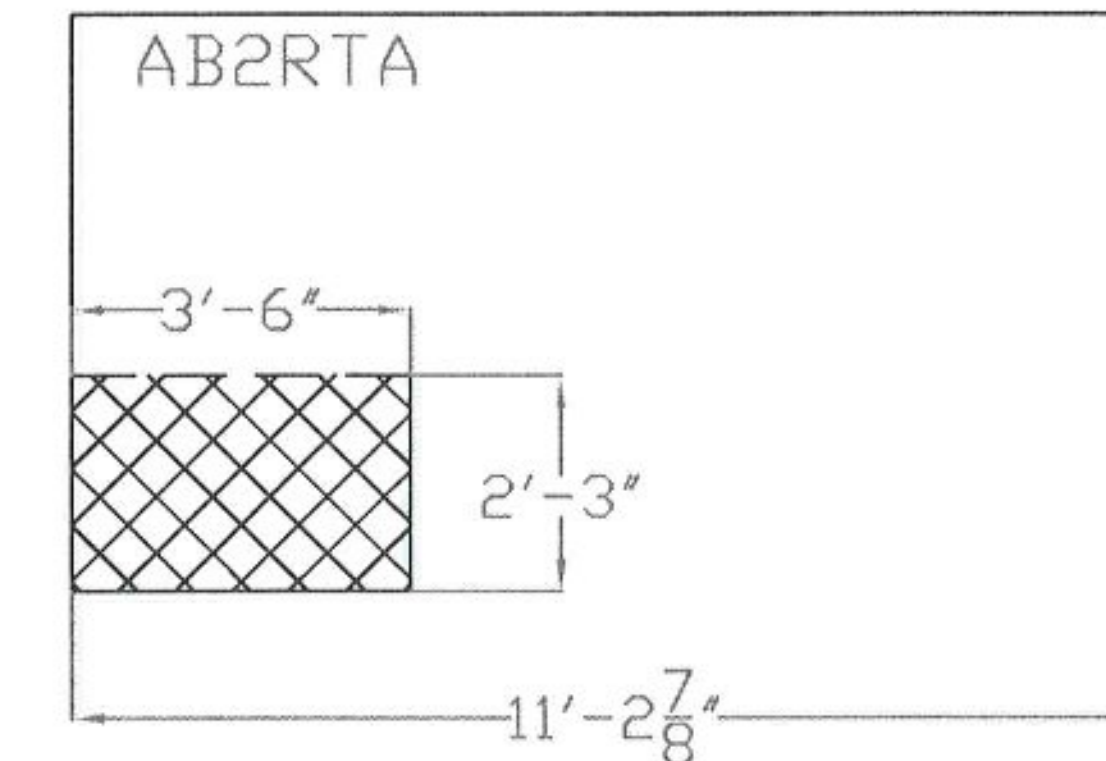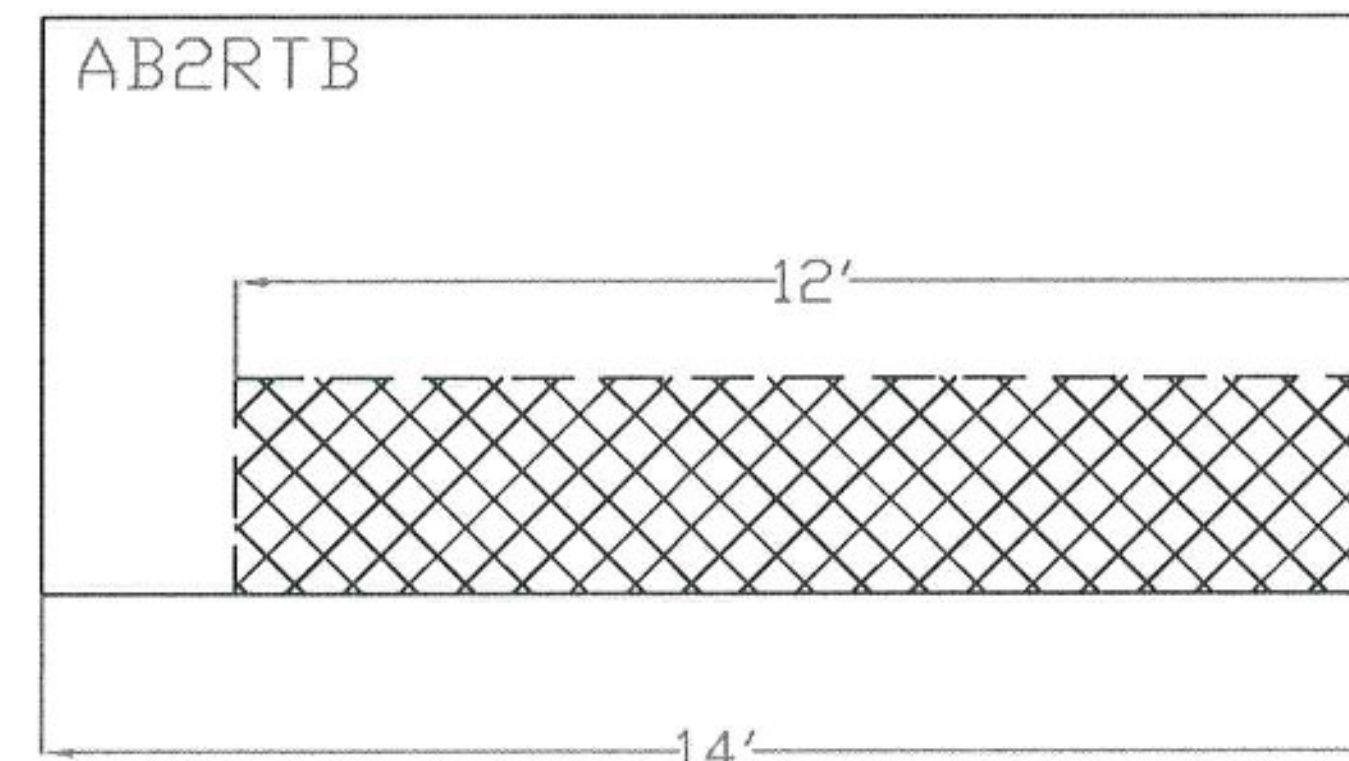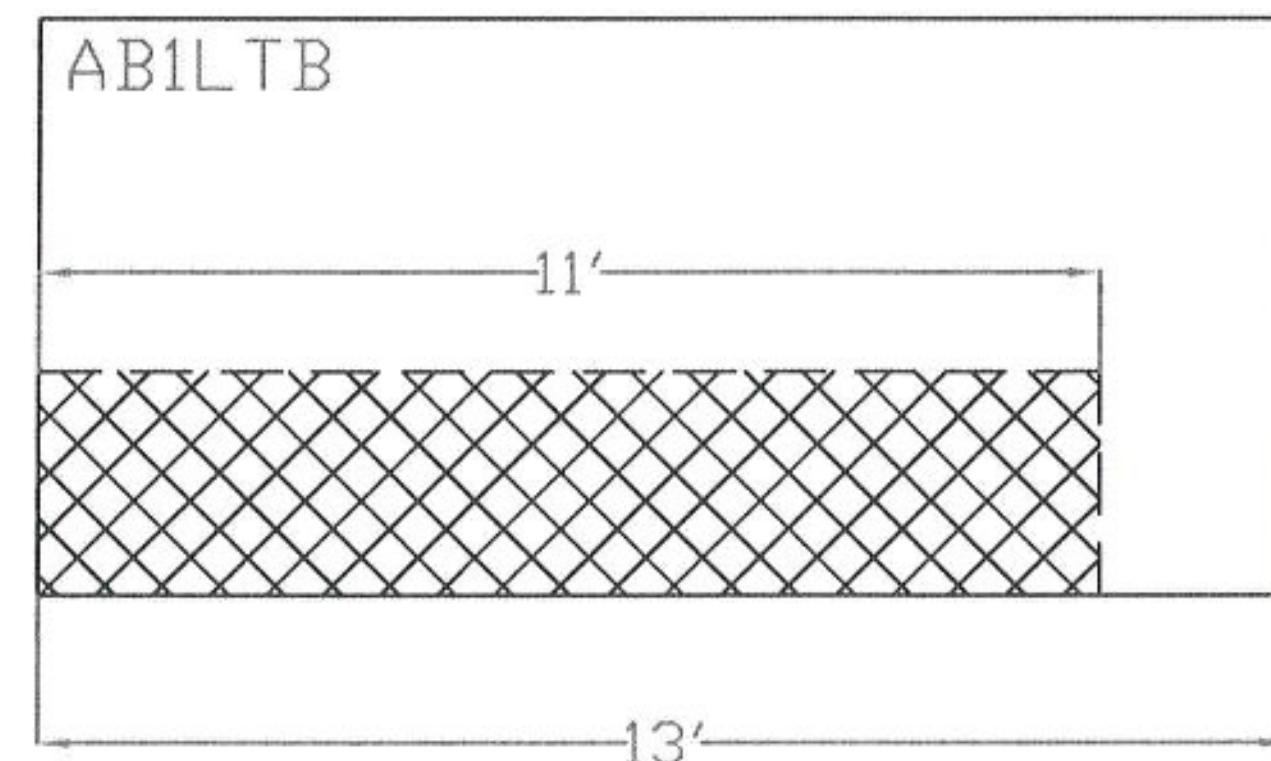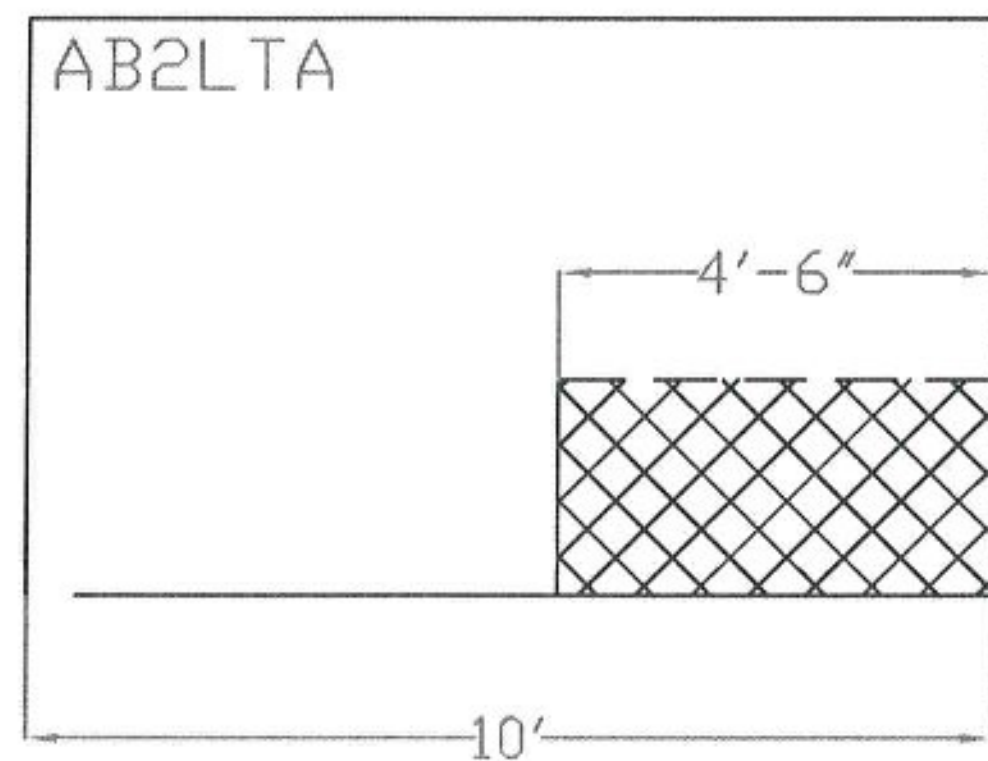

ABUTMENT 2 ELEVATION VIEW

REVISION # 1 11-19-13
 REVISION # 2 12-6-13

COLD RIVER BRIDGES, LLC	
10 LANBRO LANE	
TEL 603-756-9300	WALPOLE, NH FAX 603-756-9303
CAVENDISH ER BRF 0146(13)	
ABUTMENT 2 PLAN	SHEET NUMBER
DATE: 10-2-13	4
Scale:	