


REVISED DIMENSIONS FROM
FACE OF VERTICAL
CONSTRUCTION JOINT

ABUTMENT 2 BEARING LAY-OUT

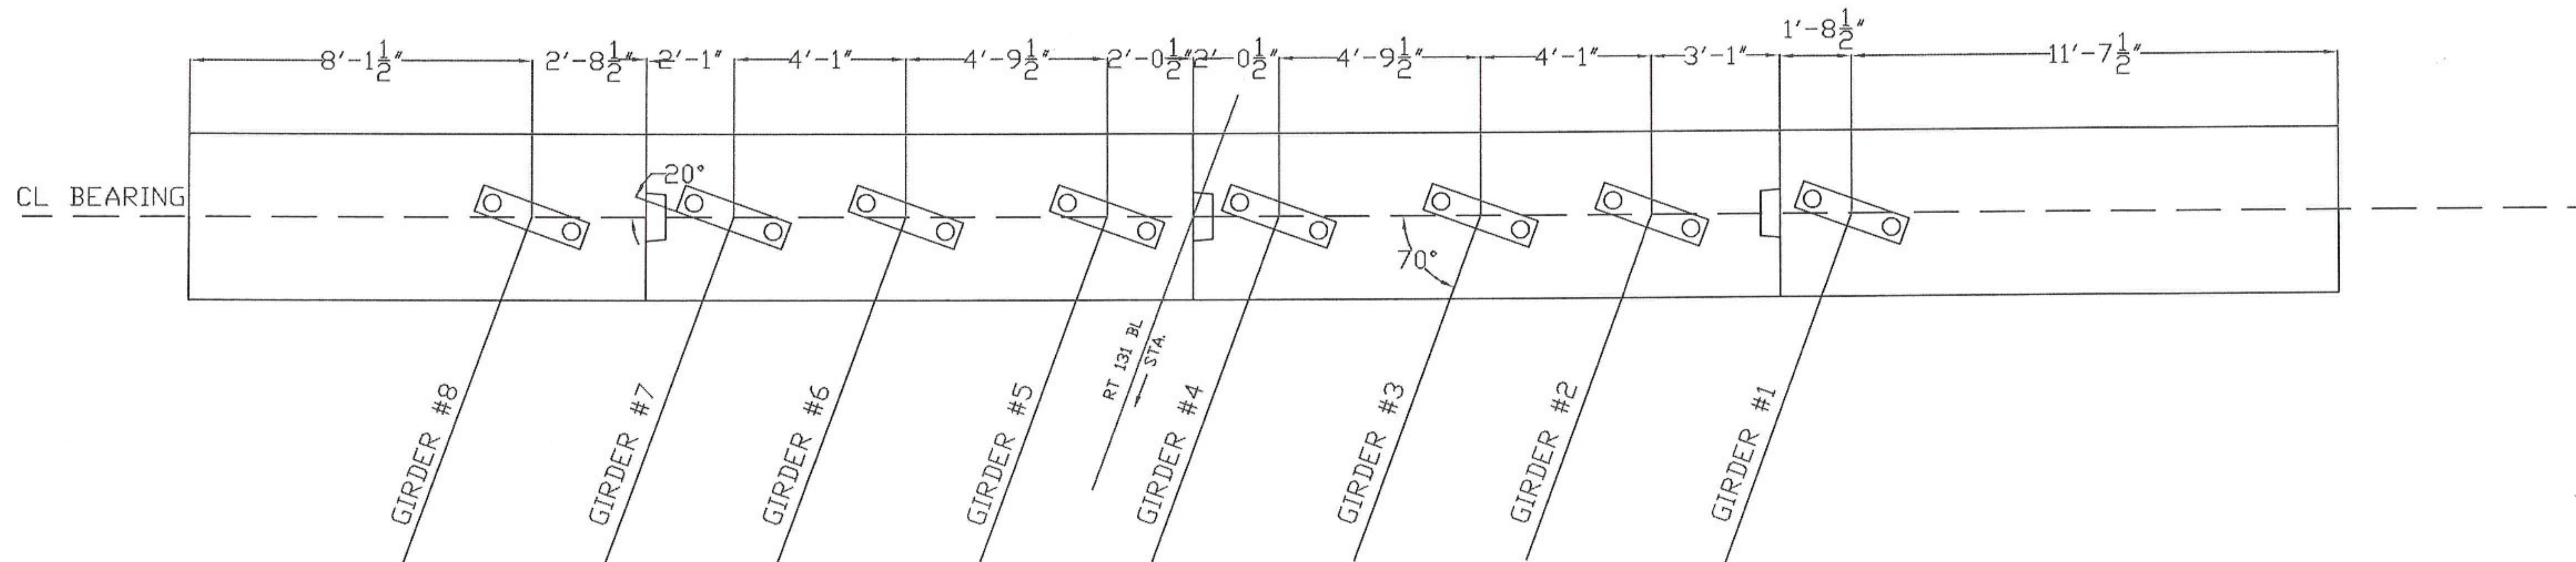

ABUTMENT 1 BEARING LAY-OUT

REVISION # 1 11-19-13
REVISION # 2 12-6-13

COLD RIVER BRIDGES, LLC	
10 LANBRO LANE	
TEL 603-756-9300	WALPOLE, NH FAX 603-756-9303
CAVENDISH ER BR 0146(13)	
BEARING LAY-OUT	SHEET NUMBER
DATE: 11-18-13	17
Scale:	