

TEMPORARY 4 INCH WHITE LINE, PAINT
 DURABLE 4 INCH WHITE LINE (OPTION BID ITEM)
 53+50 TO 56+52 SOLID LT
 53+50 TO 58+50 SOLID RT
 57+32 TO 58+50 SOLID LT

TEMPORARY 4 INCH YELLOW LINE, PAINT
 DURABLE 4 INCH YELLOW LINE (OPTION BID ITEM)
 53+50 TO 56+72 SOLID LT & RT
 57+12 TO 58+50 SOLID LT & RT

STEEL BEAM GUARDRAIL, GALVANIZED
 53+50 TO 54+98 RT
 55+31 TO 55+43.5 LT

STEEL BEAM GUARDRAIL,
 GALVANIZED W/8 FEET POSTS
 53+50 TO 55+31 LT


ANCHOR FOR STEEL BEAM RAIL
 54+98 RT
 55+43.5 LT

REMOVAL AND DISPOSAL OF GUARDRAIL
 53+50 TO 54+98 RT
 53+50 TO 55+37 LT

DELINEATOR WITH STEEL POST
 54+98 RT
 55+43.5 LT

REMOVING SIGNS
 AS SHOWN - 6

ERECTING SALVAGED SIGNS
 AS SHOWN - 1

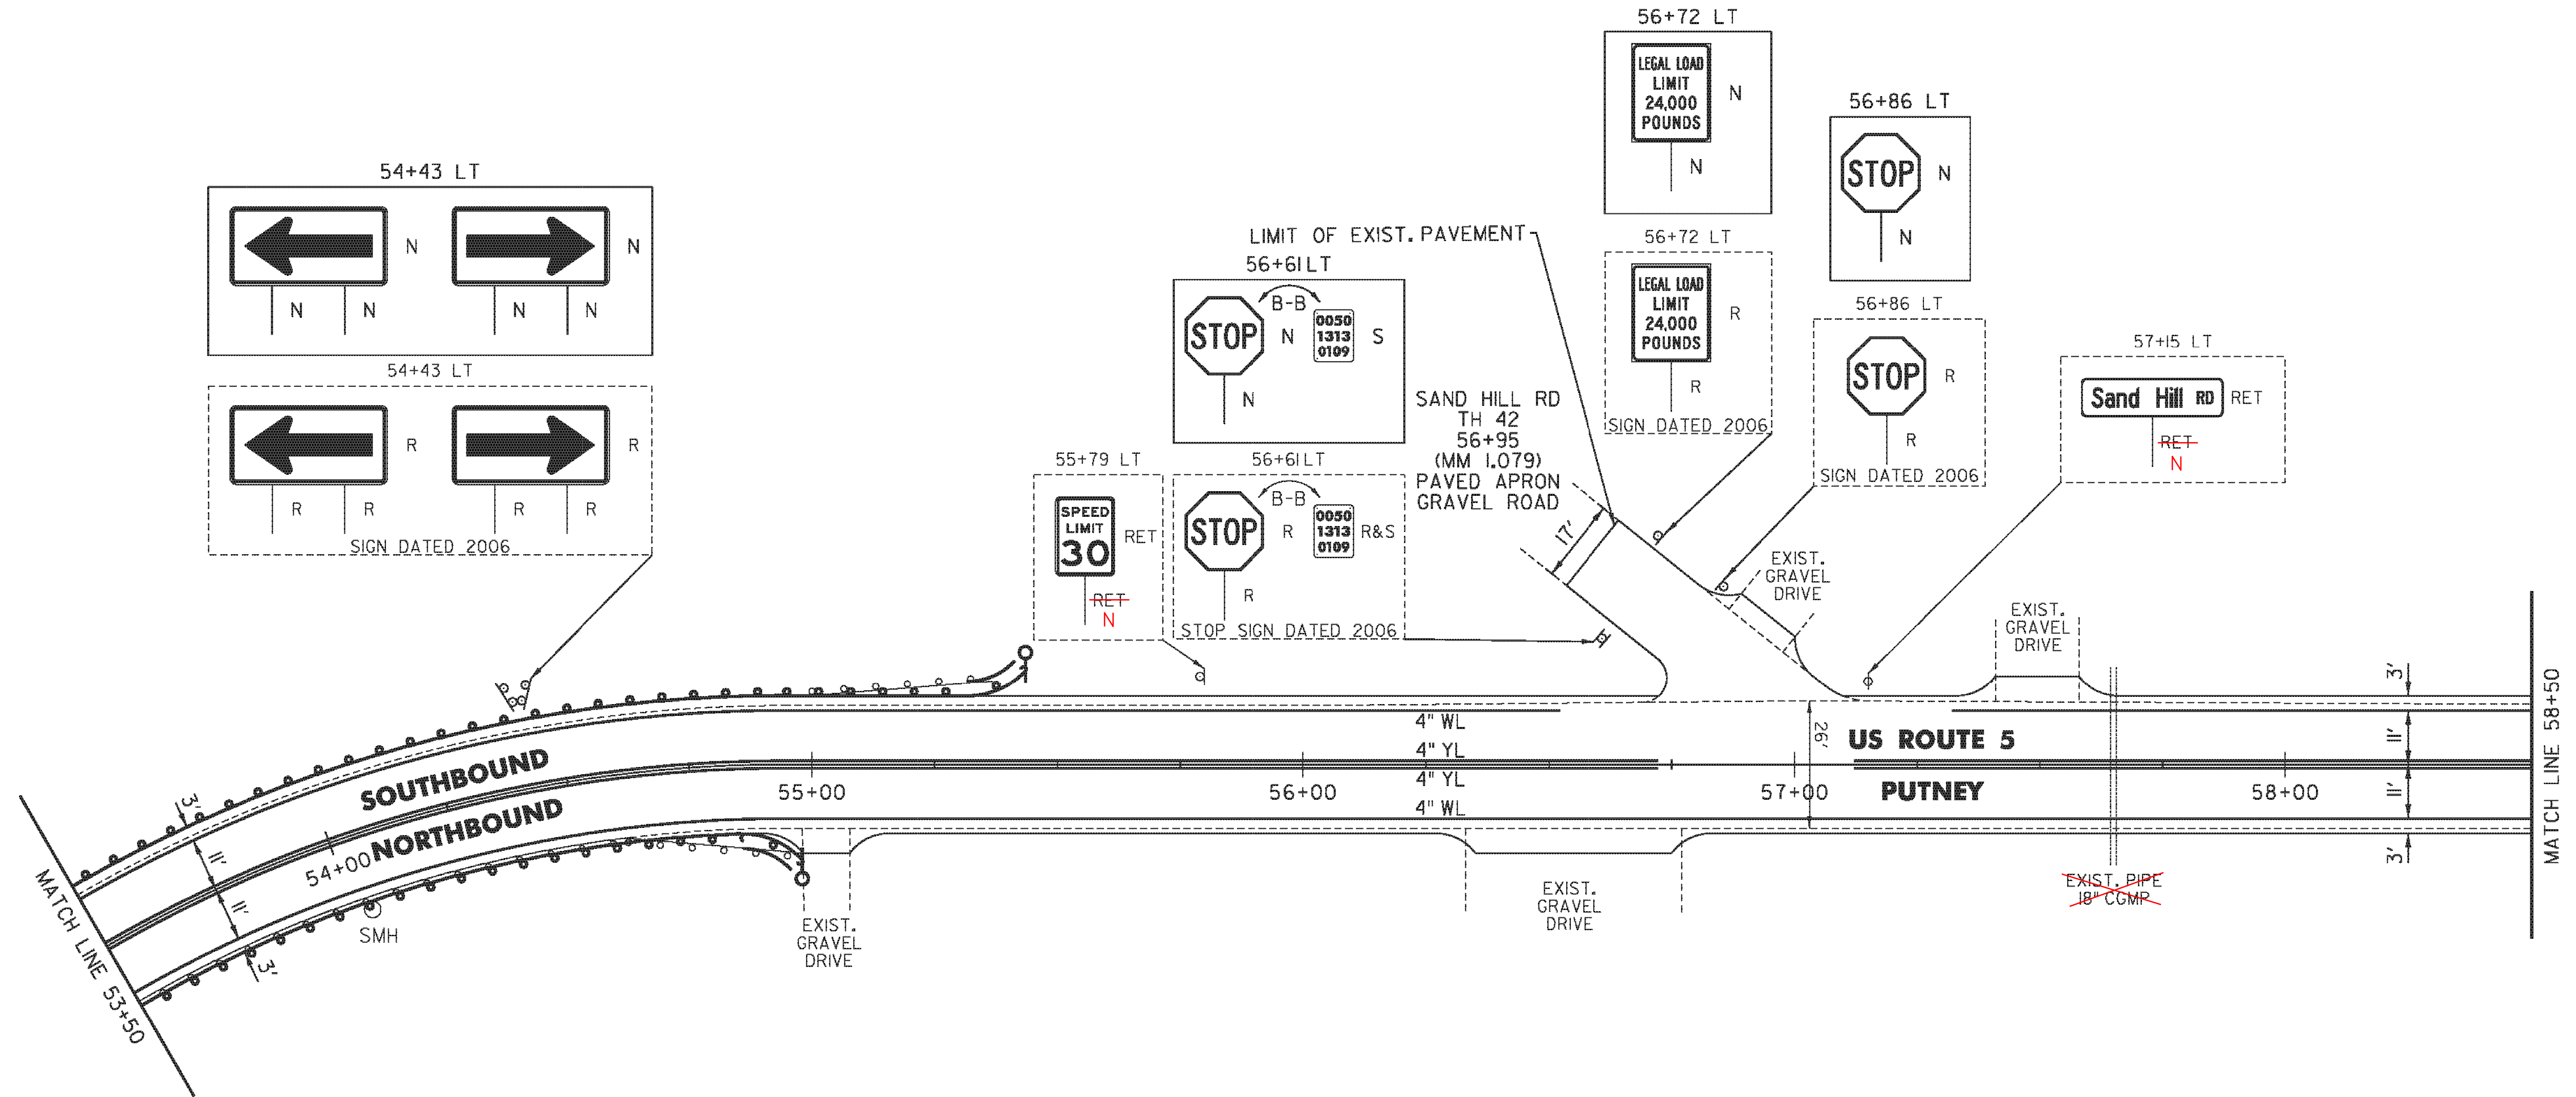

NOT TO SCALE

- LEGEND**
- R = REMOVE EXISTING
 - S = SALVAGE
 - R&S = REMOVE AND SALVAGE
 - N = NEW
 - RET = RETAIN
 - B-B = BACK TO BACK
 - = EXISTING GUARDRAIL
 - = PROPOSED GUARDRAIL
 - YL = YELLOW LINE
 - WL = WHITE LINE
 - = DELINEATOR
 - = UTILITY POLE

PROJECT NAME:	PUTNEY-WESTMINSTER	PLOT DATE:	12/10/2013
PROJECT NUMBER:	STP 2946(I)	DRAWN BY:	W. GORDON
FILE NAME:	zllc344bdr.dgn	DESIGNED BY:	N. LEMAY
ROADWAY LAYOUT:	3 US 5	CHECKED BY:	P. SHEDD
		SHEET:	24 OF 138