

TEMPORARY 4 INCH WHITE LINE, PAINT
 DURABLE 4 INCH WHITE LINE (OPTION BID ITEM)
 128+50 TO 138+50 SOLID LT & RT

TEMPORARY 4 INCH YELLOW LINE, PAINT
 DURABLE 4 INCH YELLOW LINE, POLYUREA
 128+50 TO 138+50 SOLID LT & RT

STEEL BEAM GUARDRAIL, GALVANIZED
 131+71 TO 132+08.5 RT


ANCHOR FOR STEEL BEAM RAIL
 131+71 RT

REMOVAL AND DISPOSAL OF GUARDRAIL
 131+71 TO 132+08.5 RT

DELINEATOR WITH STEEL POST
 131+71 RT

MILLED RUMBLE STRIPS
 128+50 TO 138+50 CL

REMOVING SIGNS
 AS SHOWN - 7

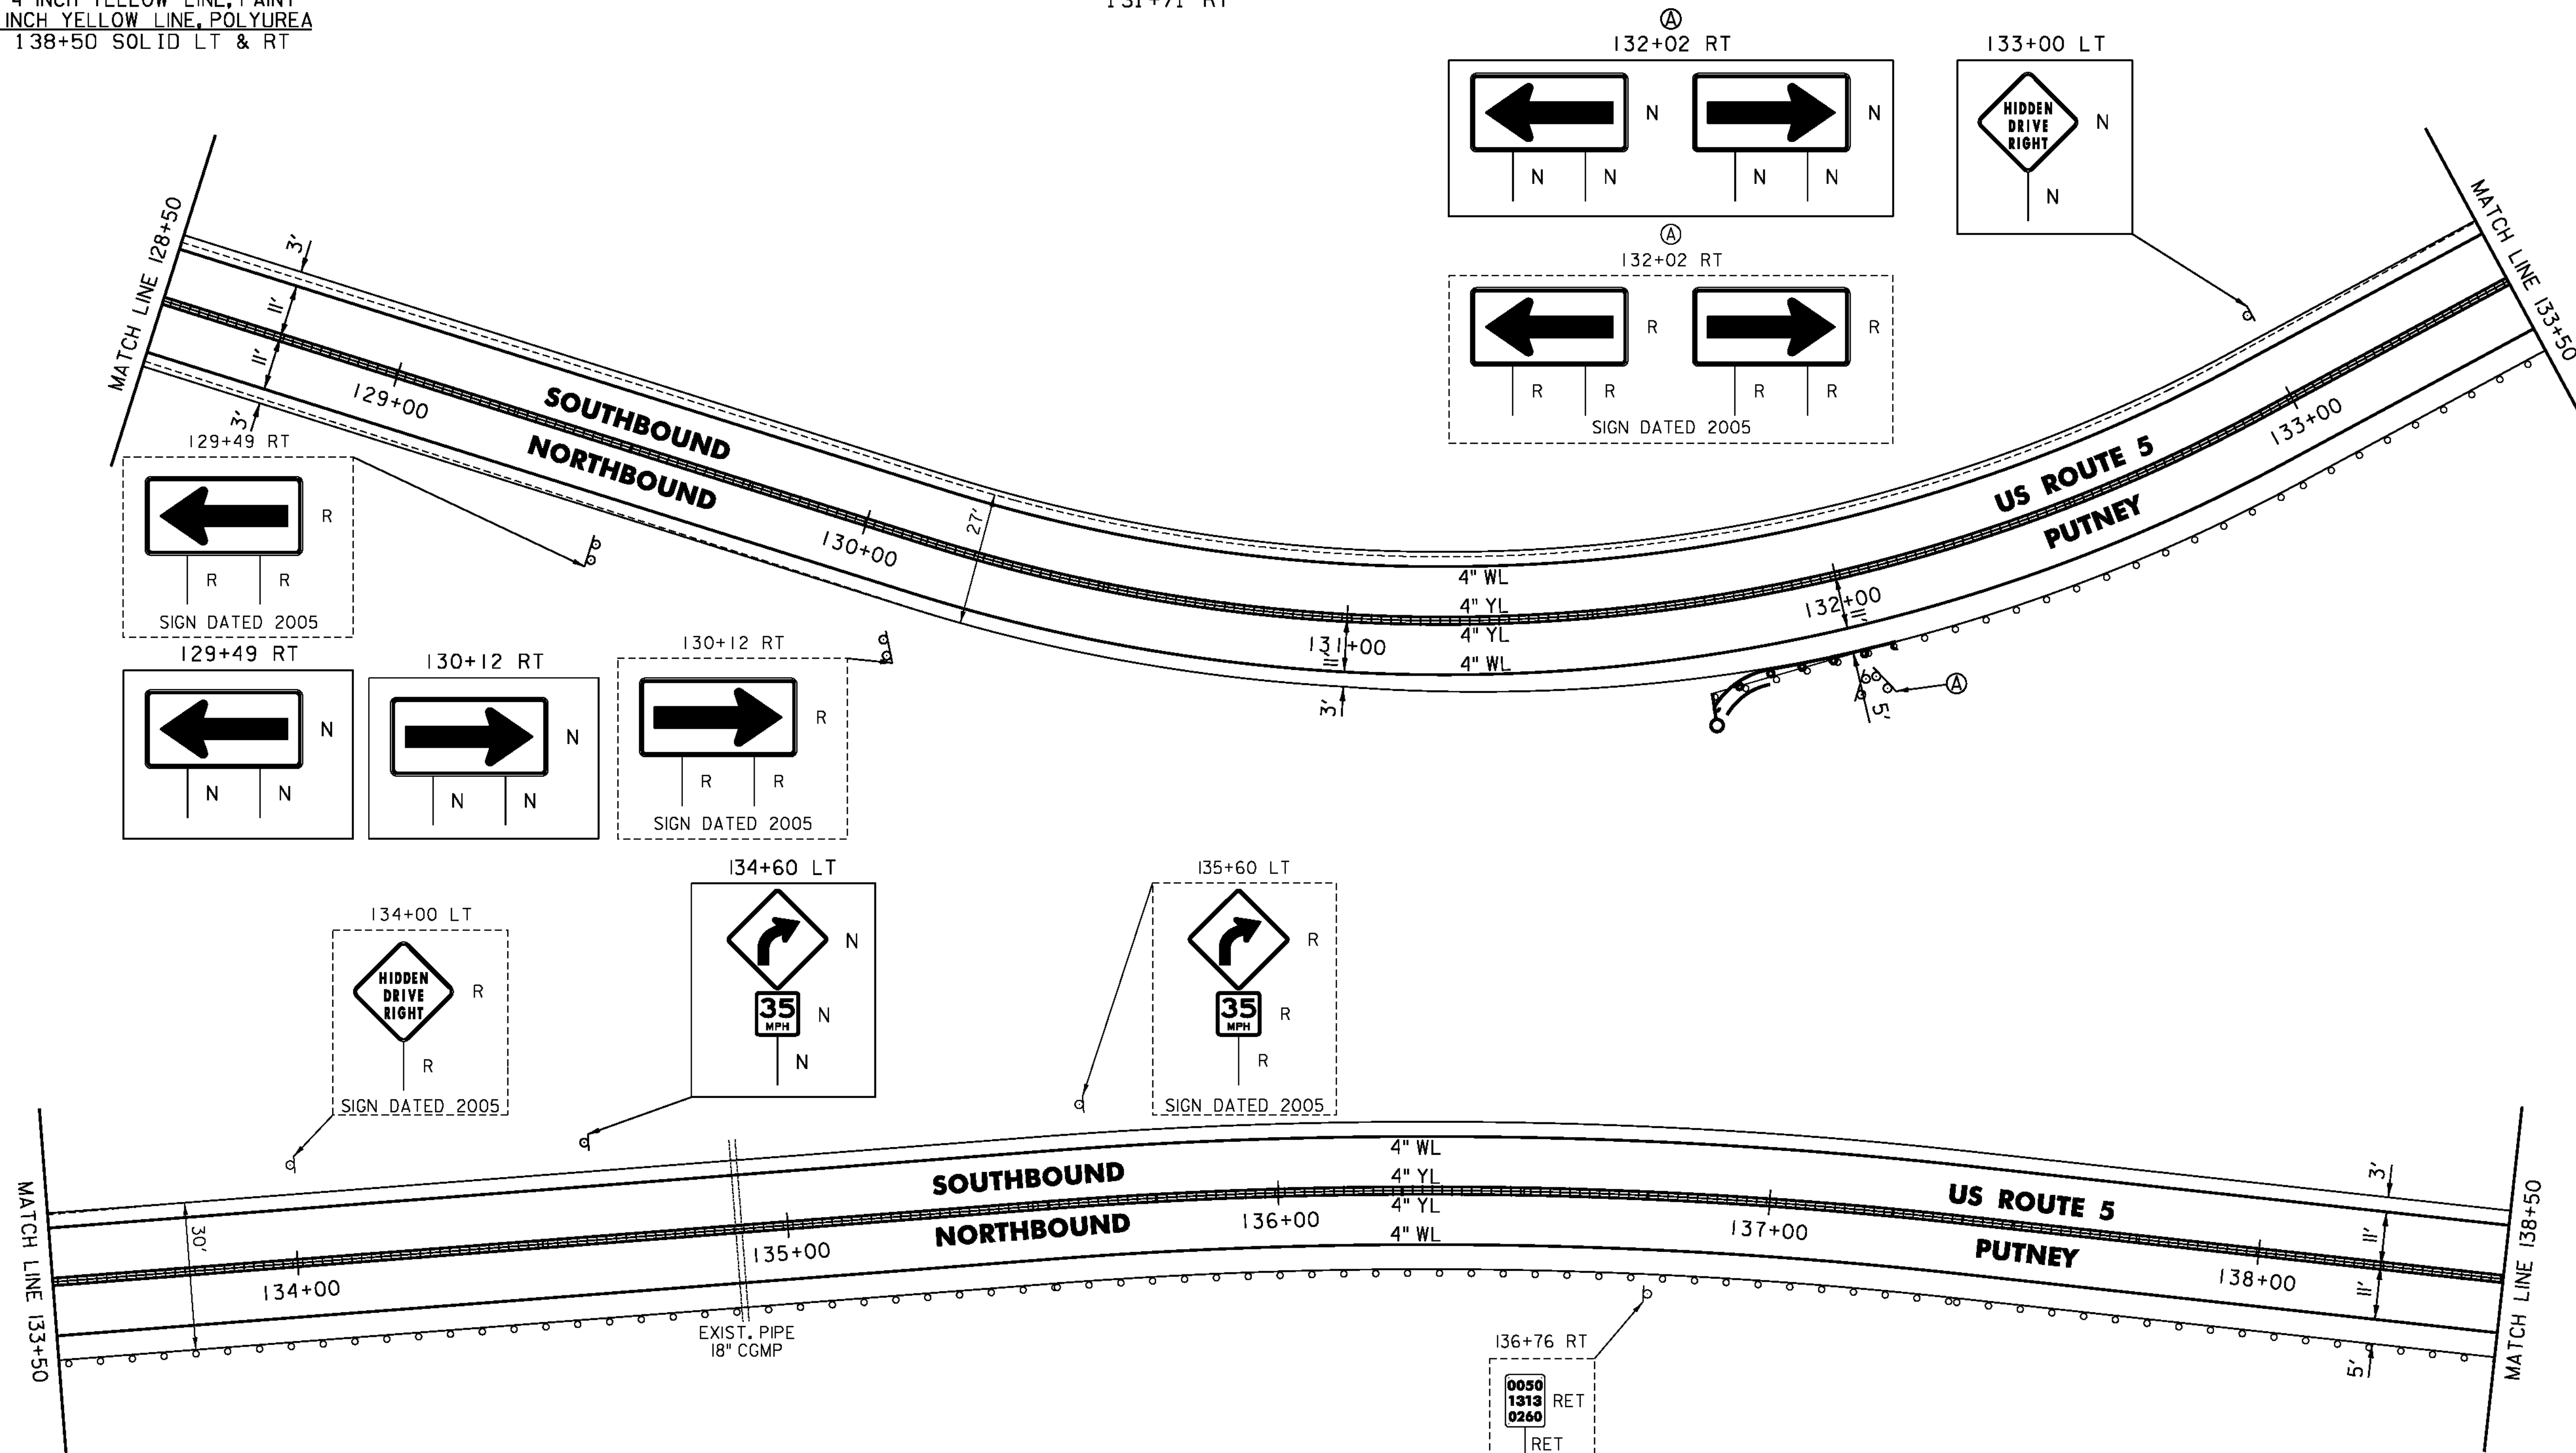

- LEGEND**
- R = REMOVE EXISTING
 - S = SALVAGE
 - R&S = REMOVE AND SALVAGE
 - N = NEW
 - RET = RETAIN
 - B-B = BACK TO BACK
 - = EXISTING GUARDRAIL
 - = PROPOSED GUARDRAIL
 - YL = YELLOW LINE
 - WL = WHITE LINE
 - = DELINEATOR
 - ⊕ = UTILITY POLE

PROJECT NAME: PUTNEY-WESTMINSTER	PLOT DATE: 12/10/2013
PROJECT NUMBER: STP 2946(1)	DRAWN BY: W. GORDON
FILE NAME: zllc344bdr.dgn	CHECKED BY: P. SHEDD
PROJECT LEADER: P. SHEDD	SHEET 34 OF 138
DESIGNED BY: N. LEMAY	
ROADWAY LAYOUT 13 US 5	

NOT TO SCALE