

TEMPORARY 4 INCH WHITE LINE, PAINT  
 DURABLE 4 INCH WHITE LINE (OPTION BID ITEM)  
 149+50 TO 152+18 SOLID LT  
 149+50 TO 155+50 SOLID RT  
 152+18 TO 152+47 SOLID LT (TH 24)  
 152+69 TO 152+96 SOLID LT (TH 24)  
 152+96 TO 155+50 SOLID LT

TEMPORARY 4 INCH YELLOW LINE, PAINT  
 149+50 TO 152+40 SOLID LT & RT  
 152+58 TO 152+60 DOUBLE SOLID LT (TH 24)  
 152+80 TO 155+50 SOLID LT & RT

DURABLE 4 INCH YELLOW LINE (OPTION BID ITEM)  
 149+50 TO 152+40 SOLID LT & RT  
 152+58 TO 152+60 DOUBLE SOLID LT (TH 24)  
 152+80 TO 153+50 SOLID LT & RT

DURABLE 4 INCH YELLOW LINE, POLYUREA  
 153+50 TO 155+50 SOLID LT & RT


TEMPORARY 24 INCH STOP BAR, PAINT  
 DURABLE 24 INCH STOP BAR (OPTION BID ITEM)  
 152+36 TO 152+60 LT (TH 24)

TEMPORARY LETTER OR SYMBOL, PAINT  
 DURABLE LETTER OR SYMBOL (OPTION BID ITEM)  
 153+51 LT - STOP (TH 24)

MILLED RUMBLE STRIPS  
 153+50 TO 155+50 CL

REMOVING SIGNS  
 AS SHOWN - 3

ERECTING SALVAGED SIGNS  
 AS SHOWN - 1

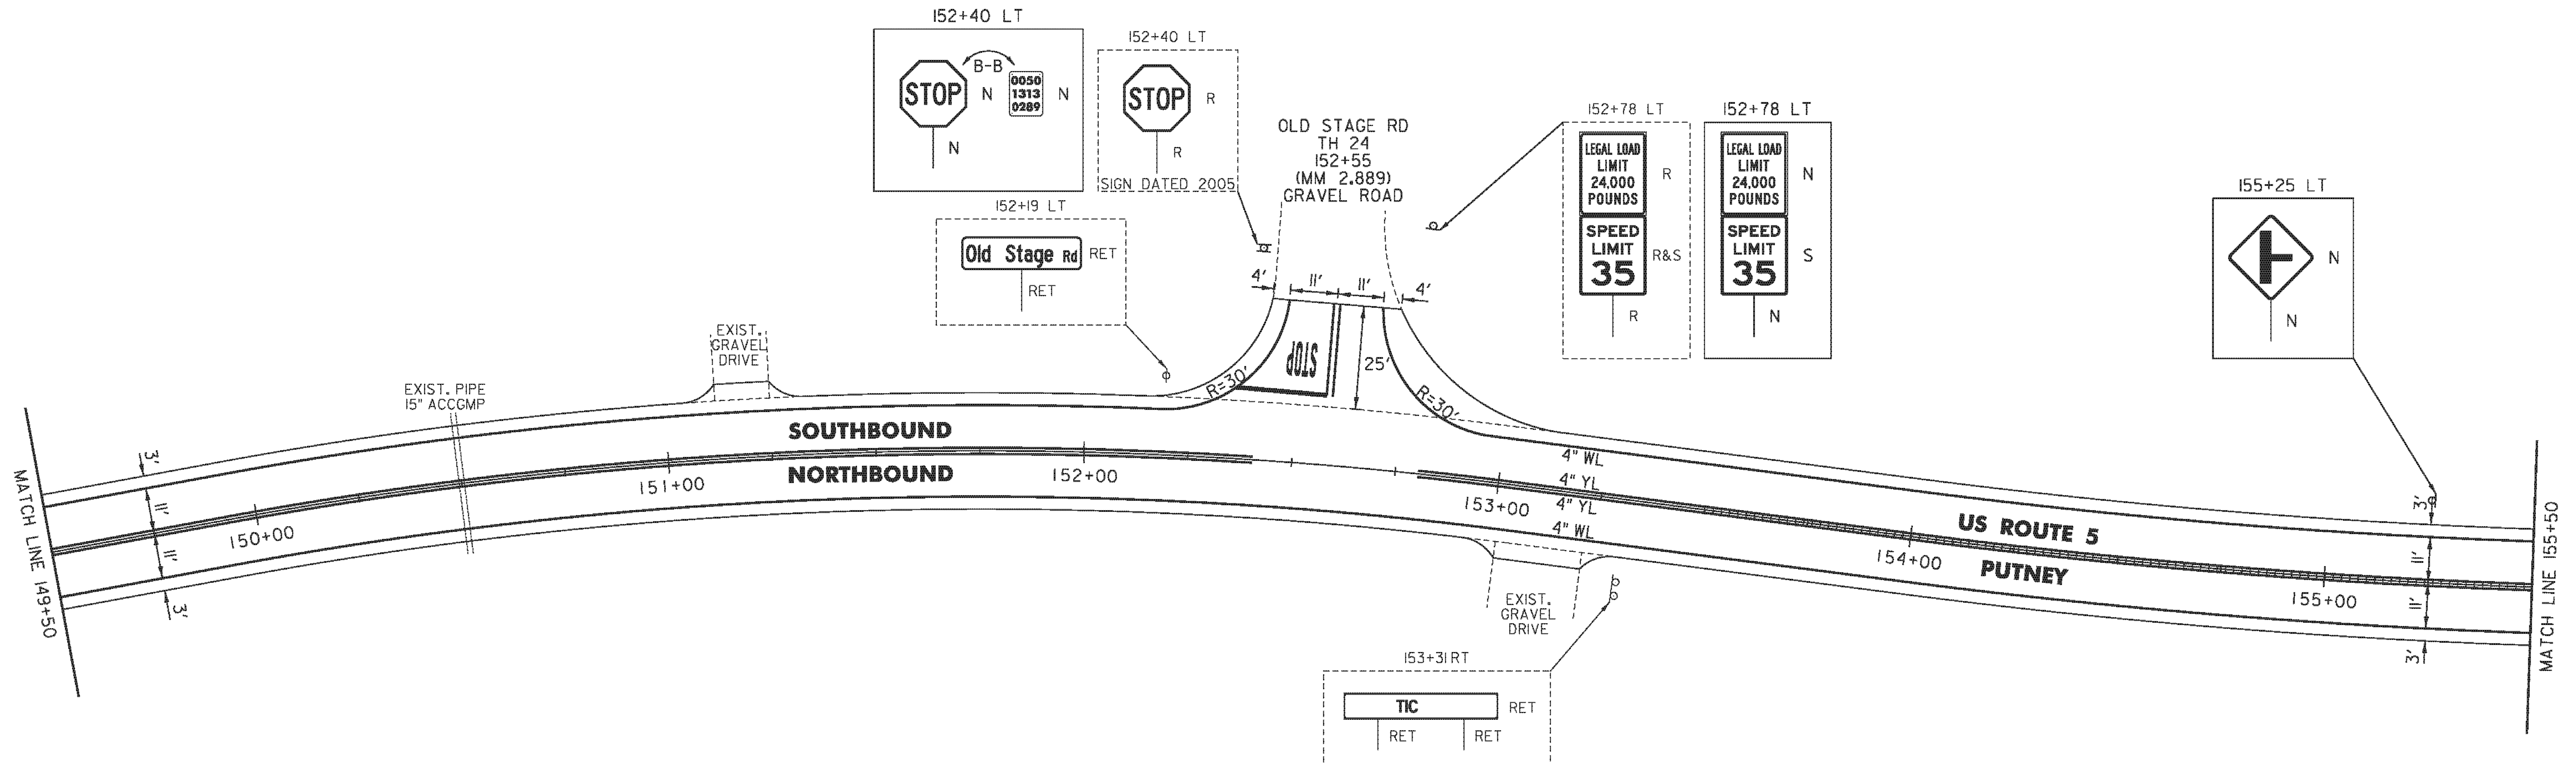

NOT TO SCALE

- LEGEND**
- R = REMOVE EXISTING
  - S = SALVAGE
  - R&S = REMOVE AND SALVAGE
  - N = NEW
  - RET = RETAIN
  - B-B = BACK TO BACK
  - ⊕ = EXISTING GUARDRAIL
  - ⊕ = PROPOSED GUARDRAIL
  - YL = YELLOW LINE
  - WL = WHITE LINE
  - ⊕ = DELINEATOR
  - ⊕ = UTILITY POLE

PROJECT NAME: PUTNEY-WESTMINSTER

PROJECT NUMBER: STP 2946(1)

FILE NAME: zllc344bdr.dgn  
 PROJECT LEADER: P. SHEDD  
 DESIGNED BY: N. LEMAY  
 ROADWAY LAYOUT IS US 5

PLOT DATE: 12/10/2013  
 DRAWN BY: W. GORDON  
 CHECKED BY: P. SHEDD  
 SHEET 36 OF 138