


TEMPORARY 4 INCH WHITE LINE, PAINT
 DURABLE 4 INCH WHITE LINE (OPTION BID ITEM)
 155+50 TO 165+50 SOLID LT & RT

TEMPORARY 4 INCH YELLOW LINE, PAINT
 155+50 TO 165+50 SOLID LT & RT
 DURABLE 4 INCH YELLOW LINE (OPTION BID ITEM)
 164+16 TO 165+50 SOLID LT & RT
 DURABLE 4 INCH YELLOW LINE, POLYUREA
 155+50 TO 164+16 SOLID LT & RT

MILLED RUMBLE STRIPS
 155+50 TO 164+16 CL
 REMOVING SIGNS
 AS SHOWN - 6

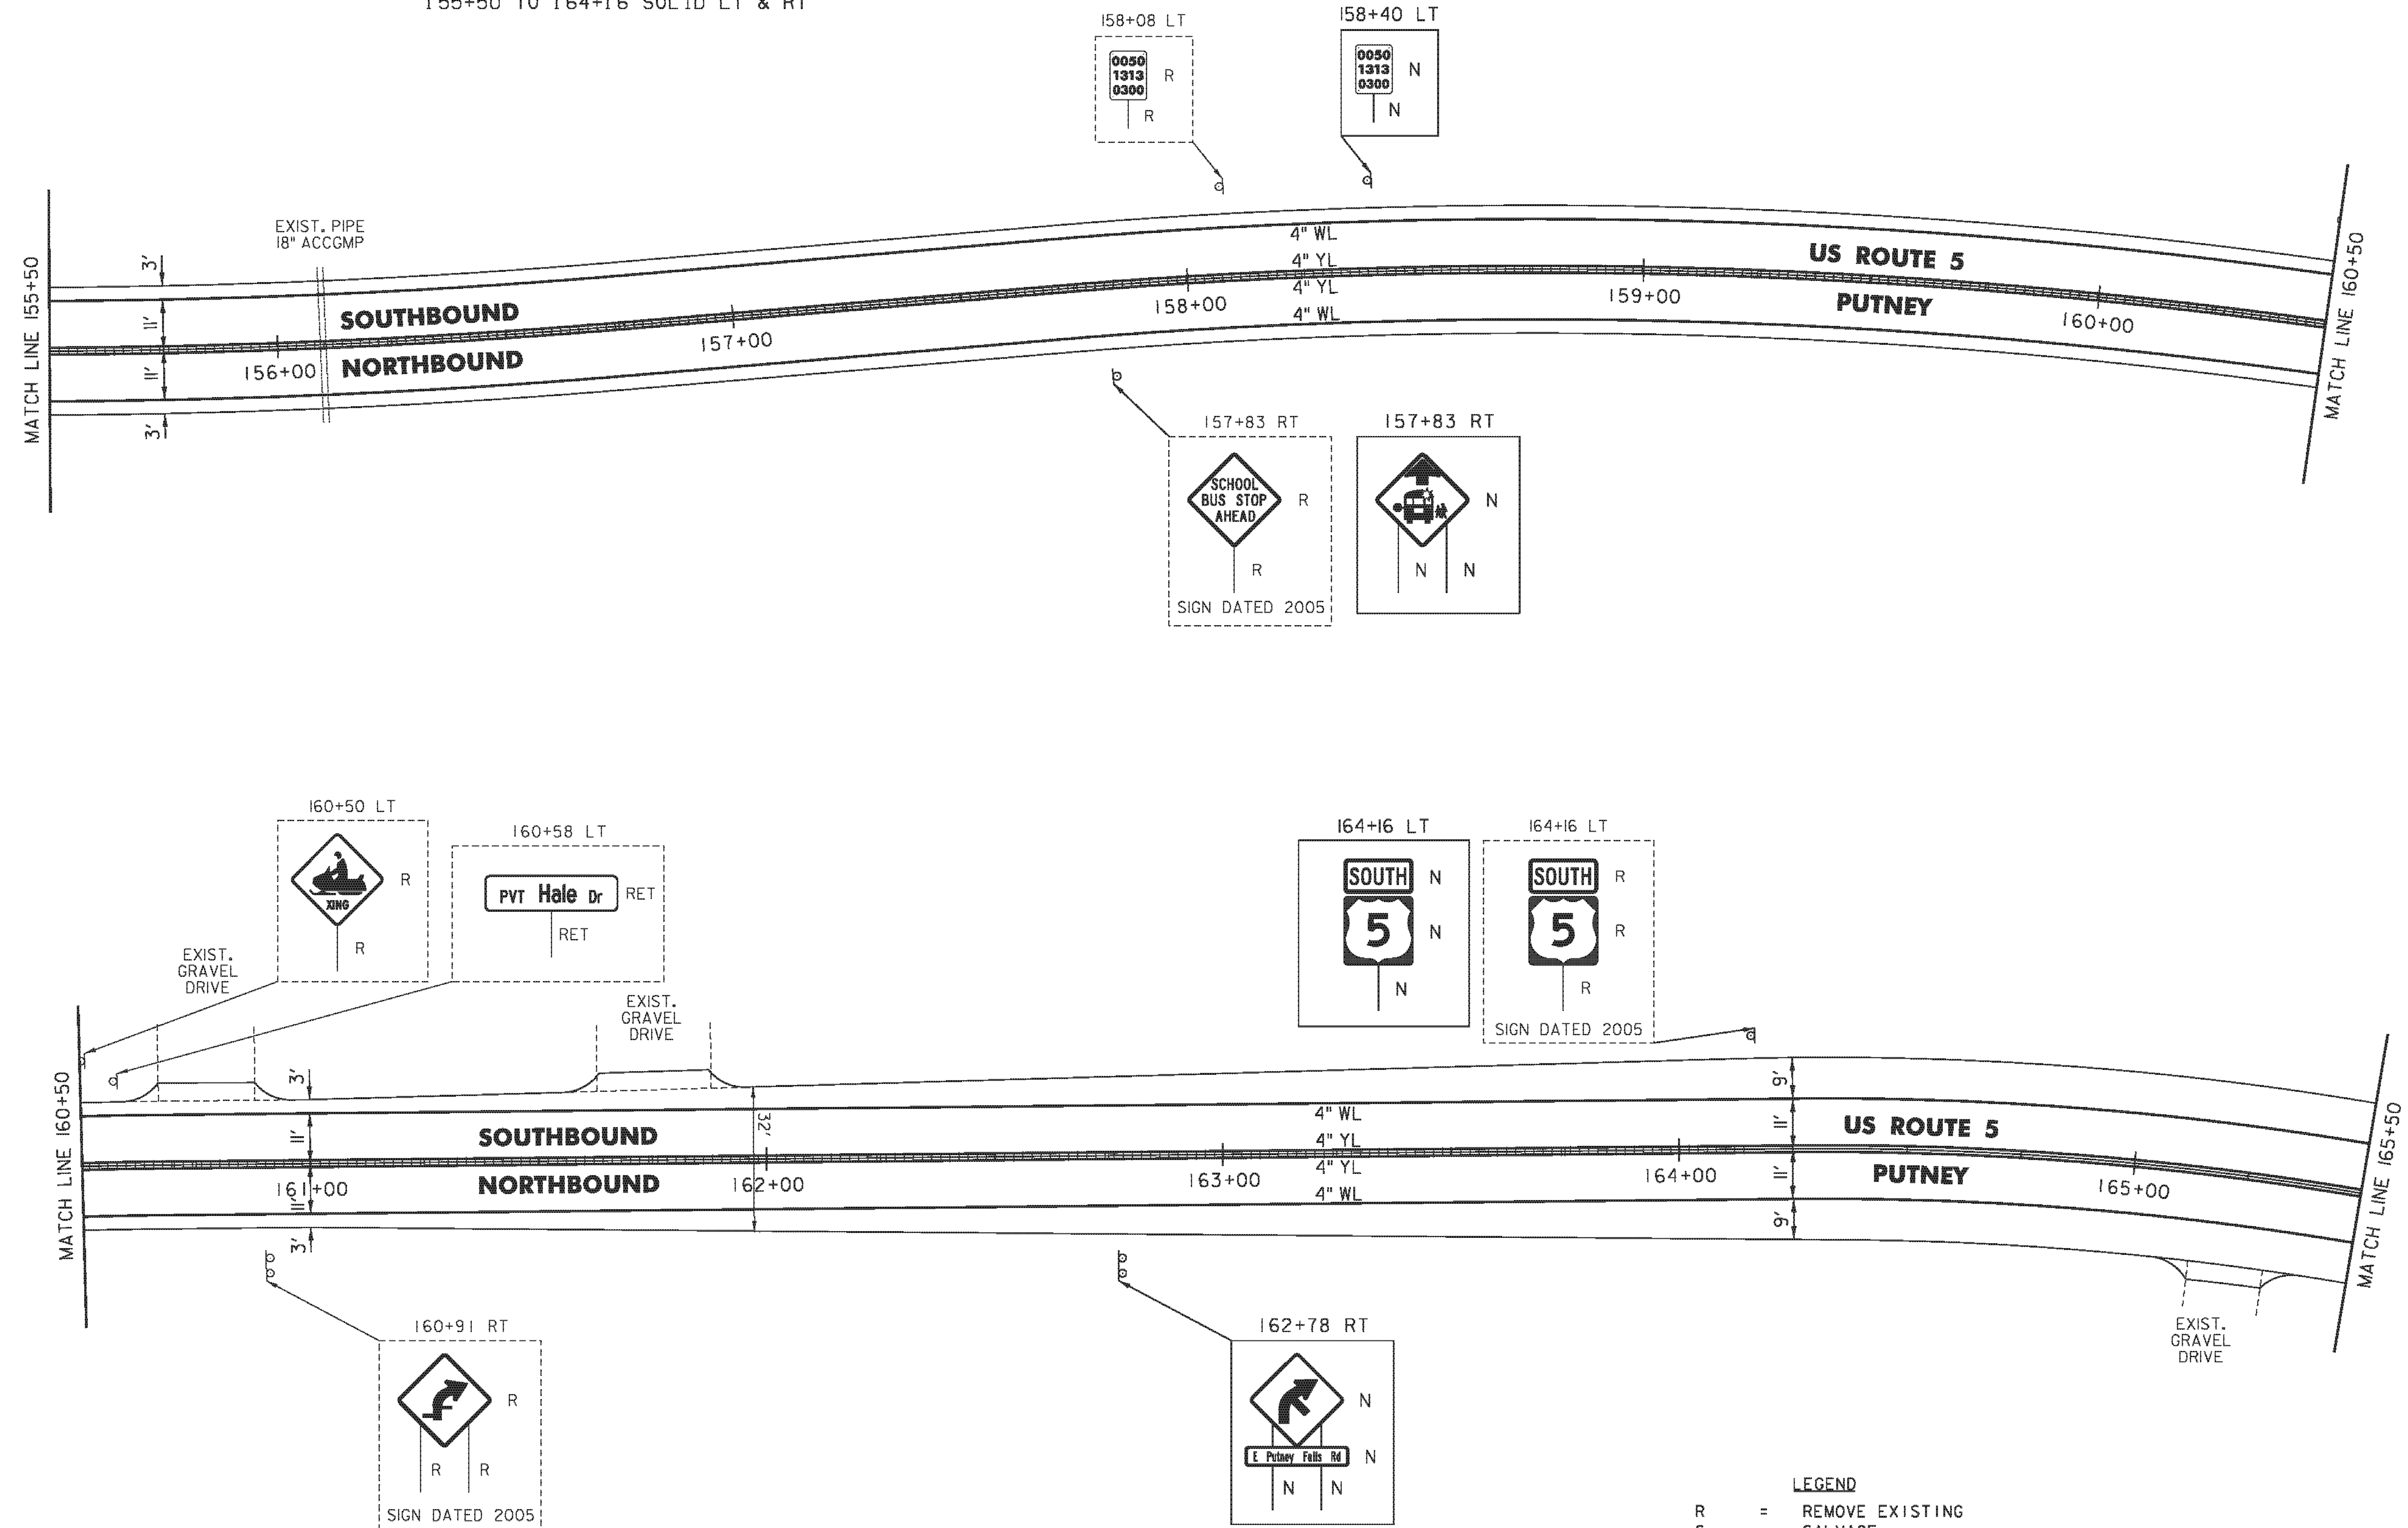

- LEGEND**
- R = REMOVE EXISTING
 - S = SALVAGE
 - R&S = REMOVE AND SALVAGE
 - N = NEW
 - RET = RETAIN
 - B-B = BACK TO BACK
 - = EXISTING GUARDRAIL
 - = PROPOSED GUARDRAIL
 - YL = YELLOW LINE
 - WL = WHITE LINE
 - = DELINEATOR
 - = UTILITY POLE

PROJECT NAME:	PUTNEY-WESTMINSTER	FILE NAME:	zllc344bdr.dgn	PLOT DATE:	12/10/2013
PROJECT NUMBER:	STP 2946(1)	PROJECT LEADER:	P. SHEDD	DRAWN BY:	W. GORDON
		DESIGNED BY:	N. LEMAY	CHECKED BY:	P. SHEDD
		ROADWAY LAYOUT	16 US 5	SHEET	37 OF 138

NOT TO SCALE